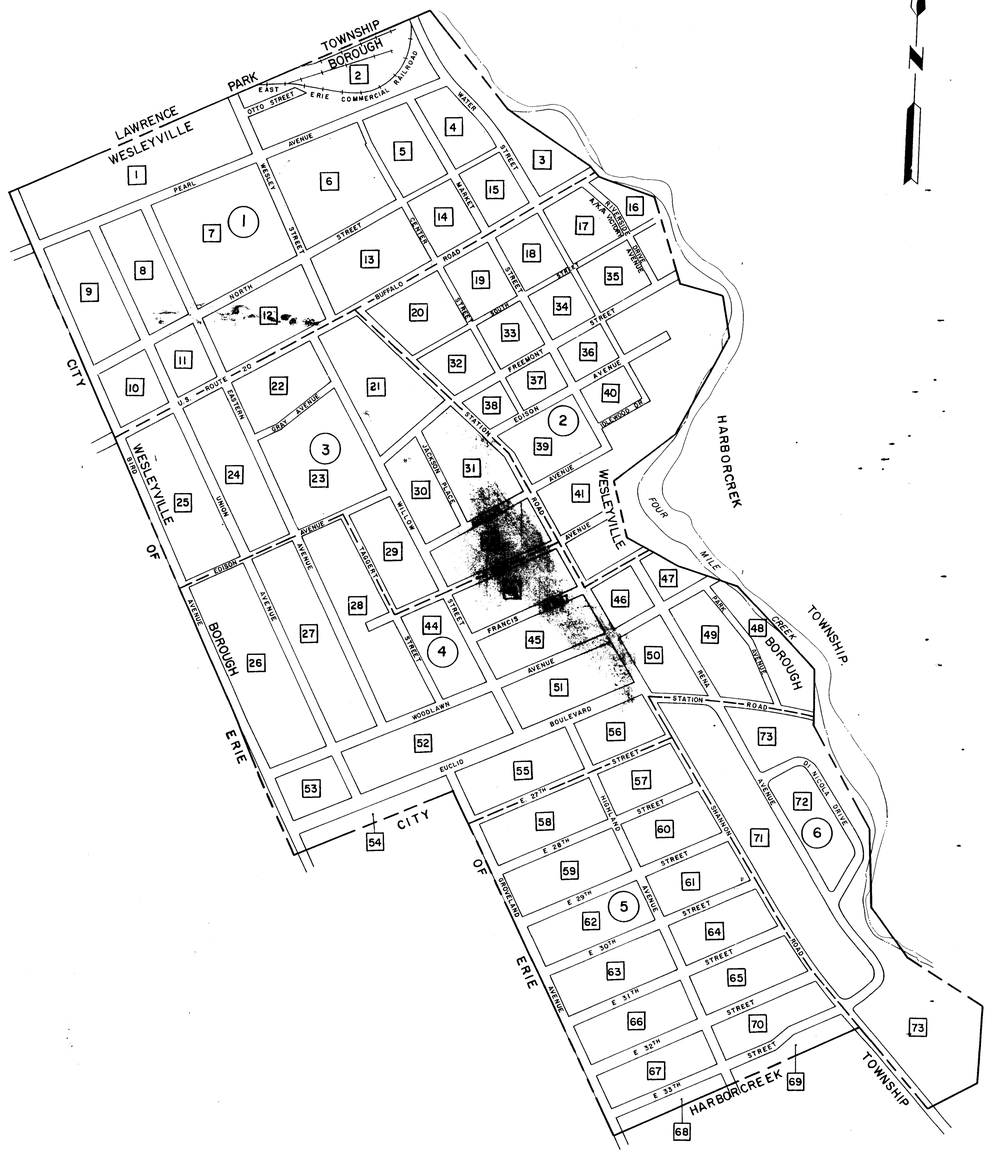


DRAFTED BY: H.K.D

CHECKED BY: E.S

FOR TAX PURPOSES ONLY

PREPARED BY

AMERICAN AIR SURVEYS, INC.
907 PENN AVENUE, PITTSBURGH, PA. 15222
NEW YORK PHILADELPHIA ATLANTA

Legend

State line	Right of way	Original block designation	(36)
County line	Easement.	Lot or parcel number	13
Township line	Edge of roadway	Deed lot number	27
Corporate limit	Railroad	Block number	2
Sanitary district	Stream	School	▶
Property line	Scaled dimension	Cemetery	Cem

Revisions


1	1-25-69 RLS	9		17	
2		10		18	
3		11		19	
4		12		20	
5		13		21	
6		14		22	

ERIE COUNTY

Office of Assessor

WESLEYVILLE BOROUGH

INDEX

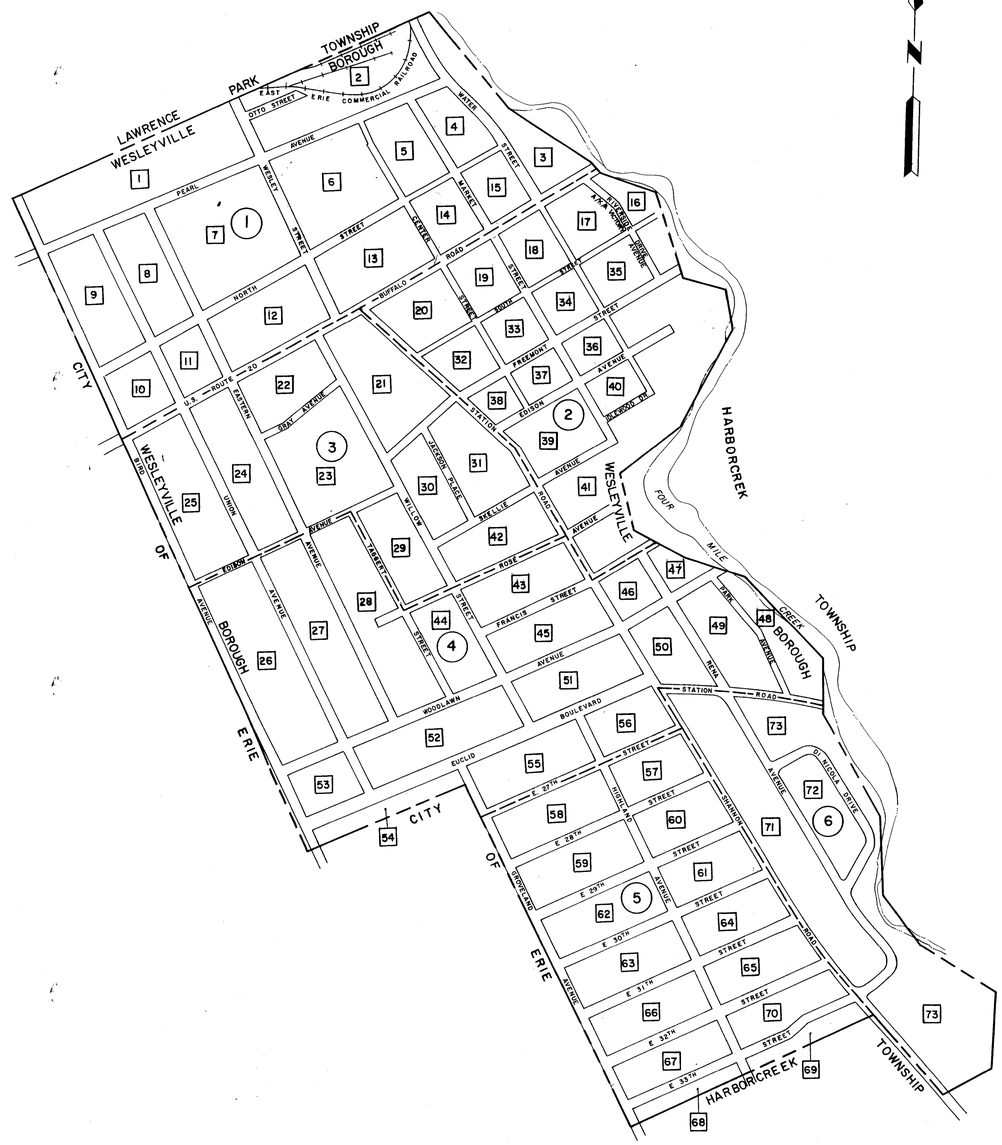

DRAFTED BY: K.N.D.

CHECKED BY: E.S.

FOR TAX PURPOSES ONLY

PREPARED BY

AMERICAN AIR SURVEYS, INC.

907 PENN AVENUE, PITTSBURGH, PA. 15222

NEW YORK PHILADELPHIA ATLANTA

Legend

State line	Right of way	Original block designation	(36)
County line	Easement	Lot or parcel number	13
Township line	Edge of roadway	Deed lot number	27
Corporate limit	Railroad	Block number	2
Sanitary district	Stream	School	▶
Property line	Scaled dimension	Cemetery	Cem
Original lot line	Deed dimension	Church	+

Revisions

1	1-28-69 RLS	9		17	
2		10		18	
3		11		19	
4		12		20	
5		13		21	
6		14		22	
7		15		23	
8		16		24	

ERIE COUNTY

Office of Assessor


PENNSYLVANIA

WESLEYVILLE BOROUGH

INDEX

Photo No.: _____ Scale: 1" = 400'

Date, Photography: 4-29-65 Date, Map: 12-16-65

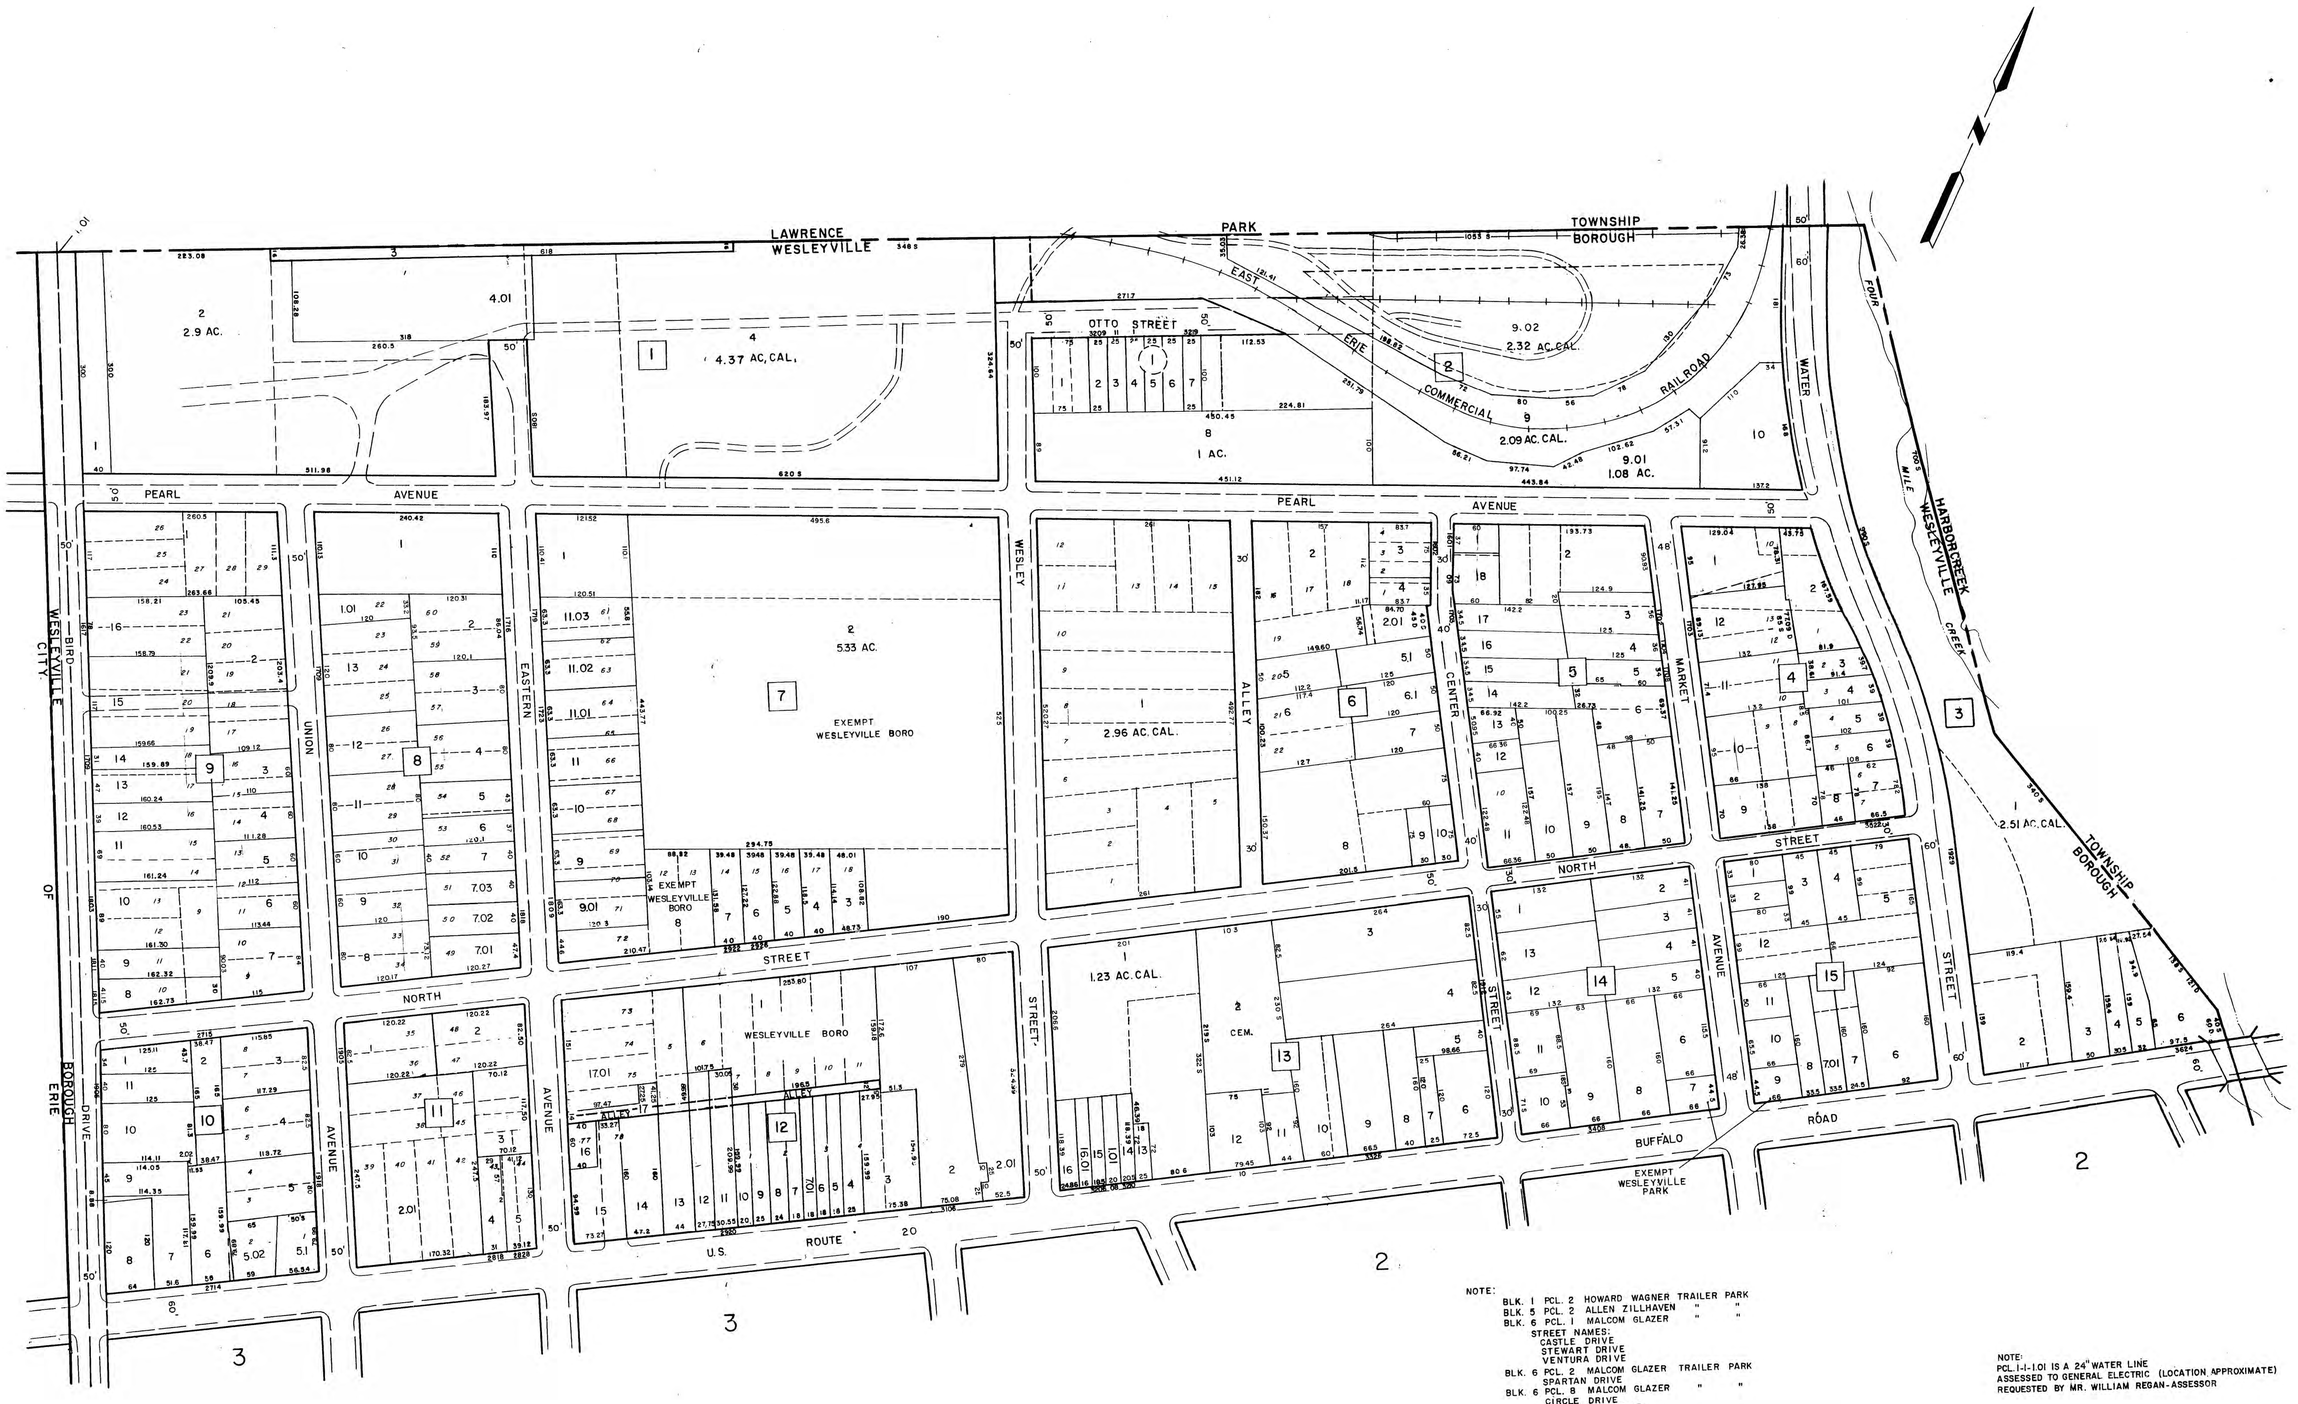

NOTE:
BLK. 1 PCL. 2 HOWARD WAGNER TRAILER PARK
BLK. 5 PCL. 2 ALLEN ZILLHAVEN " "
BLK. 6 PCL. 1 MALCOM GLAZER " "
STREET NAMES:
CASTLE DRIVE
STEWART DRIVE
VENTURA DRIVE
BLK. 6 PCL. 2 MALCOM GLAZER TRAILER PARK
SPARTAN DRIVE
BLK. 6 PCL. 8 MALCOM GLAZER " "
CIRCLE DRIVE
FLEETWOOD DRIVE
SPARTAN DRIVE
BLK. 9 PCL. 1 HARRY WAGNER " "
BLK. 9 PCL. 2 " " " "
EVERETT DRIVE
ZACHARY DRIVE
BLK. 9 PCL. 15 HARRY WAGNER " "
BLK. 13 PCL. 1 GLEN TRIMBLE " "

NOTE:
PCL. 1-1-101 IS A 24" WATER LINE
ASSESSED TO GENERAL ELECTRIC (LOCATION APPROXIMATE)
REQUESTED BY MR. WILLIAM REGAN - ASSESSOR

DRAFTED BY: kg
CHECKED BY: RB

FOR TAX PURPOSES ONLY

PREPARED BY

AMERICAN AIR SURVEYS, INC.
907 PENN AVENUE, PITTSBURGH, PA. 15222
NEW YORK PHILADELPHIA ATLANTA

Legend

State line	Right of way	Original block designation	(36)
County line	Easement	Lot or parcel number	13
Township line	Edge of roadway	Deed lot number	27
Corporate limit	Railroad	Block number	2
Sanitary district	Stream	School	▶
Property line	Scaled dimension	Cemetery	Cem
		Church	+

Revisions

1	1-25-69	9		17	
2	3-11-70-10/30/72-9/28/73-3/4/75	10		18	
3	9/22/78-12/17/90-1/23/92-3/9/98	11		19	
4	3/1/05-	12		20	
5		13		21	
6		14		22	
7		15		23	
8		16		24	

ERIE COUNTY

Office of Assessor


PENNSYLVANIA

WESLEYVILLE BOROUGH

Map No. 1

Photo No.: 580 Scale: 1" = 1(

Date, Photography: 4-29-65 Date, Map: 1

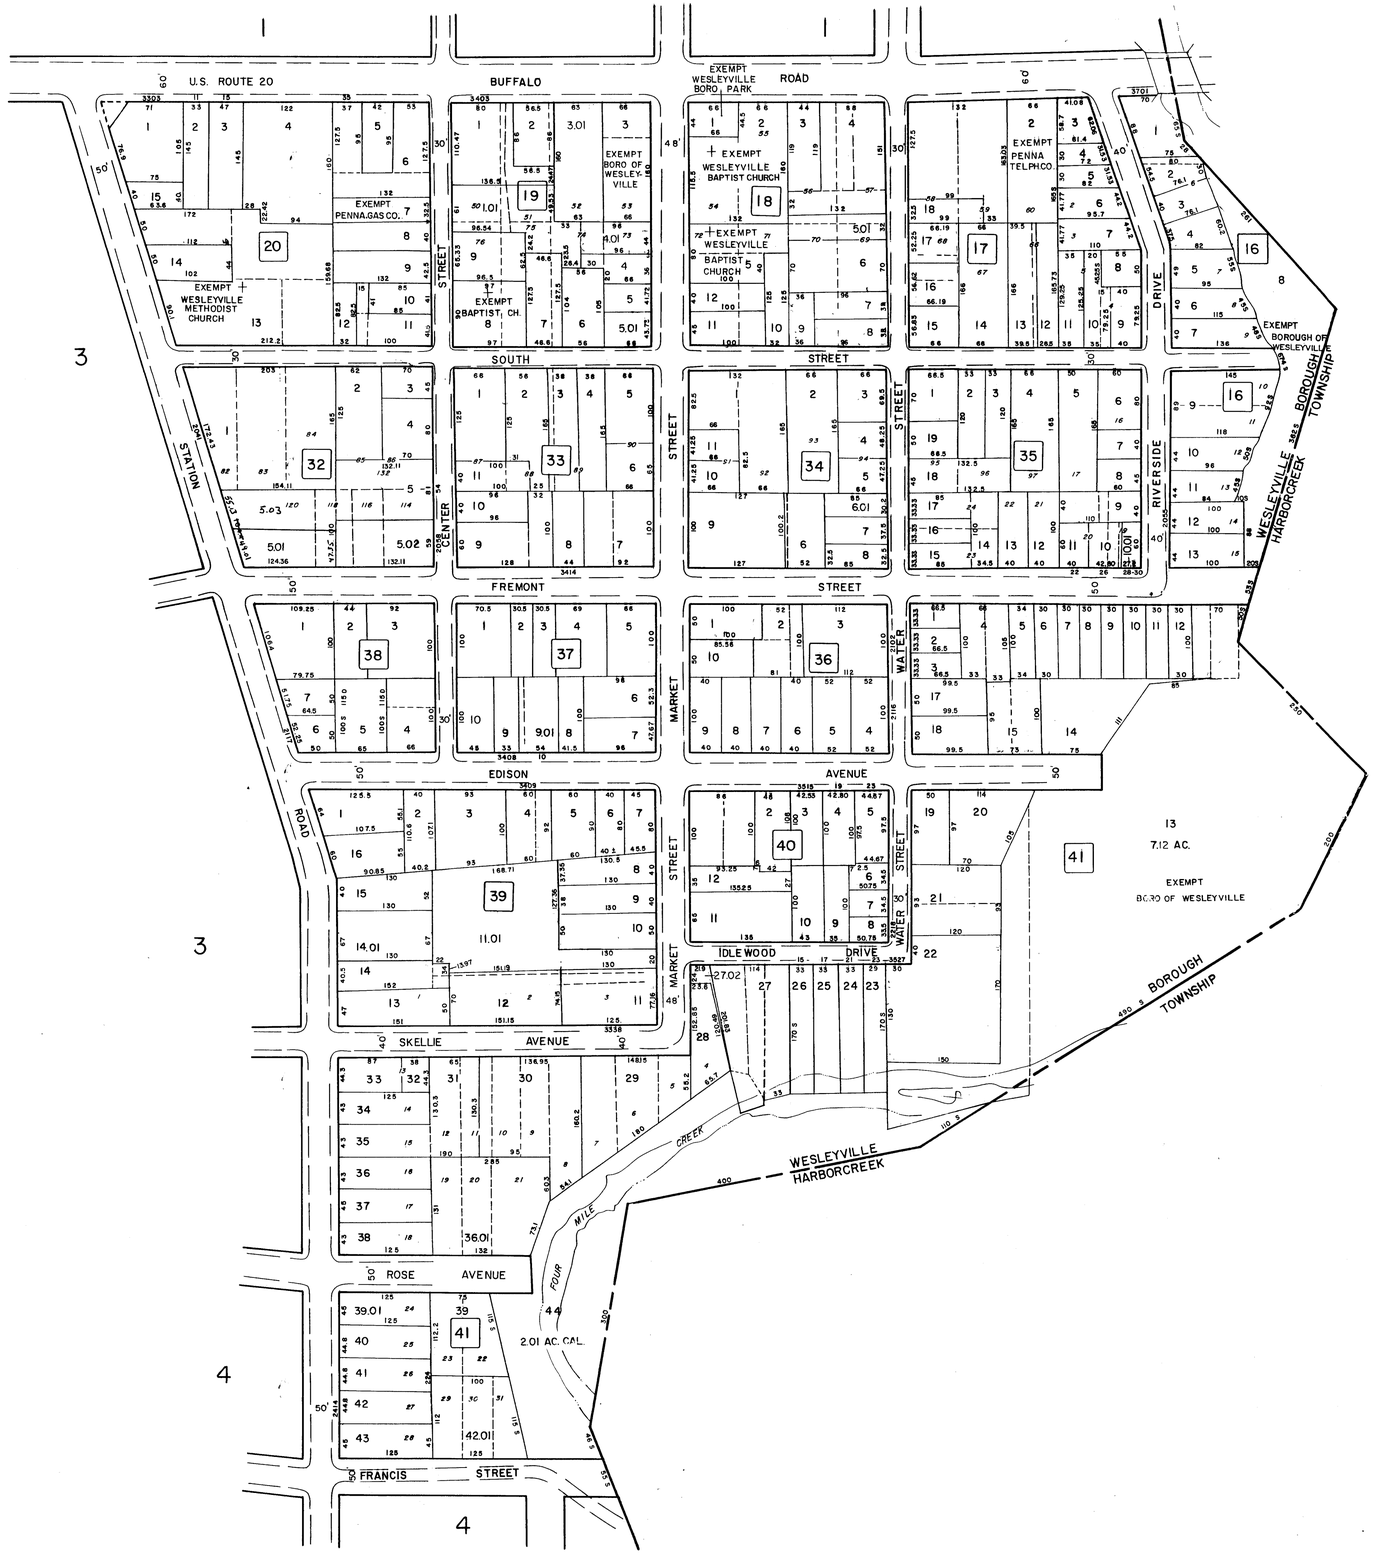

DRAFTED BY: [illegible]

CHECKED BY: ES

FOR TAX PURPOSES ONLY

PREPARED BY

AMERICAN AIR SURVEYS, INC.

907 PENN AVENUE, PITTSBURGH, PA. 15222

NEW YORK PHILADELPHIA ATLANTA

Legend

State line	Right of way	Original block designation	(36)
County line	Easement	Lot or parcel number	13
Township line	Edge of roadway	Deed lot number	27
Corporate limit	Railroad	Block number	2
Sanitary district	Stream	School	▶
Property line	Scaled dimension	Cemetery	Cem
Original lot line	Deed dimension	Church	+

Revisions

1	1-25-69	9		17	
2	3-11-70-10/30/72-9/28/73-7/18/74	10		18	
3	9/9/77-5/13/82-12/10/84-12/8/87	11		19	
4	12/17/90-1/27/92-3/9/98-	12		20	
5		13		21	
6		14		22	
7		15		23	
8		16		24	

ERIE COUNTY

Office of Assessor


PENNSYLVANIA

WESLEYVILLE BOROUGH

Map No. 2

Photo No.: 565-579-581 Scale: 1"=100'

Date, Photography: 4-29-65 Date, Map: 12-16-65

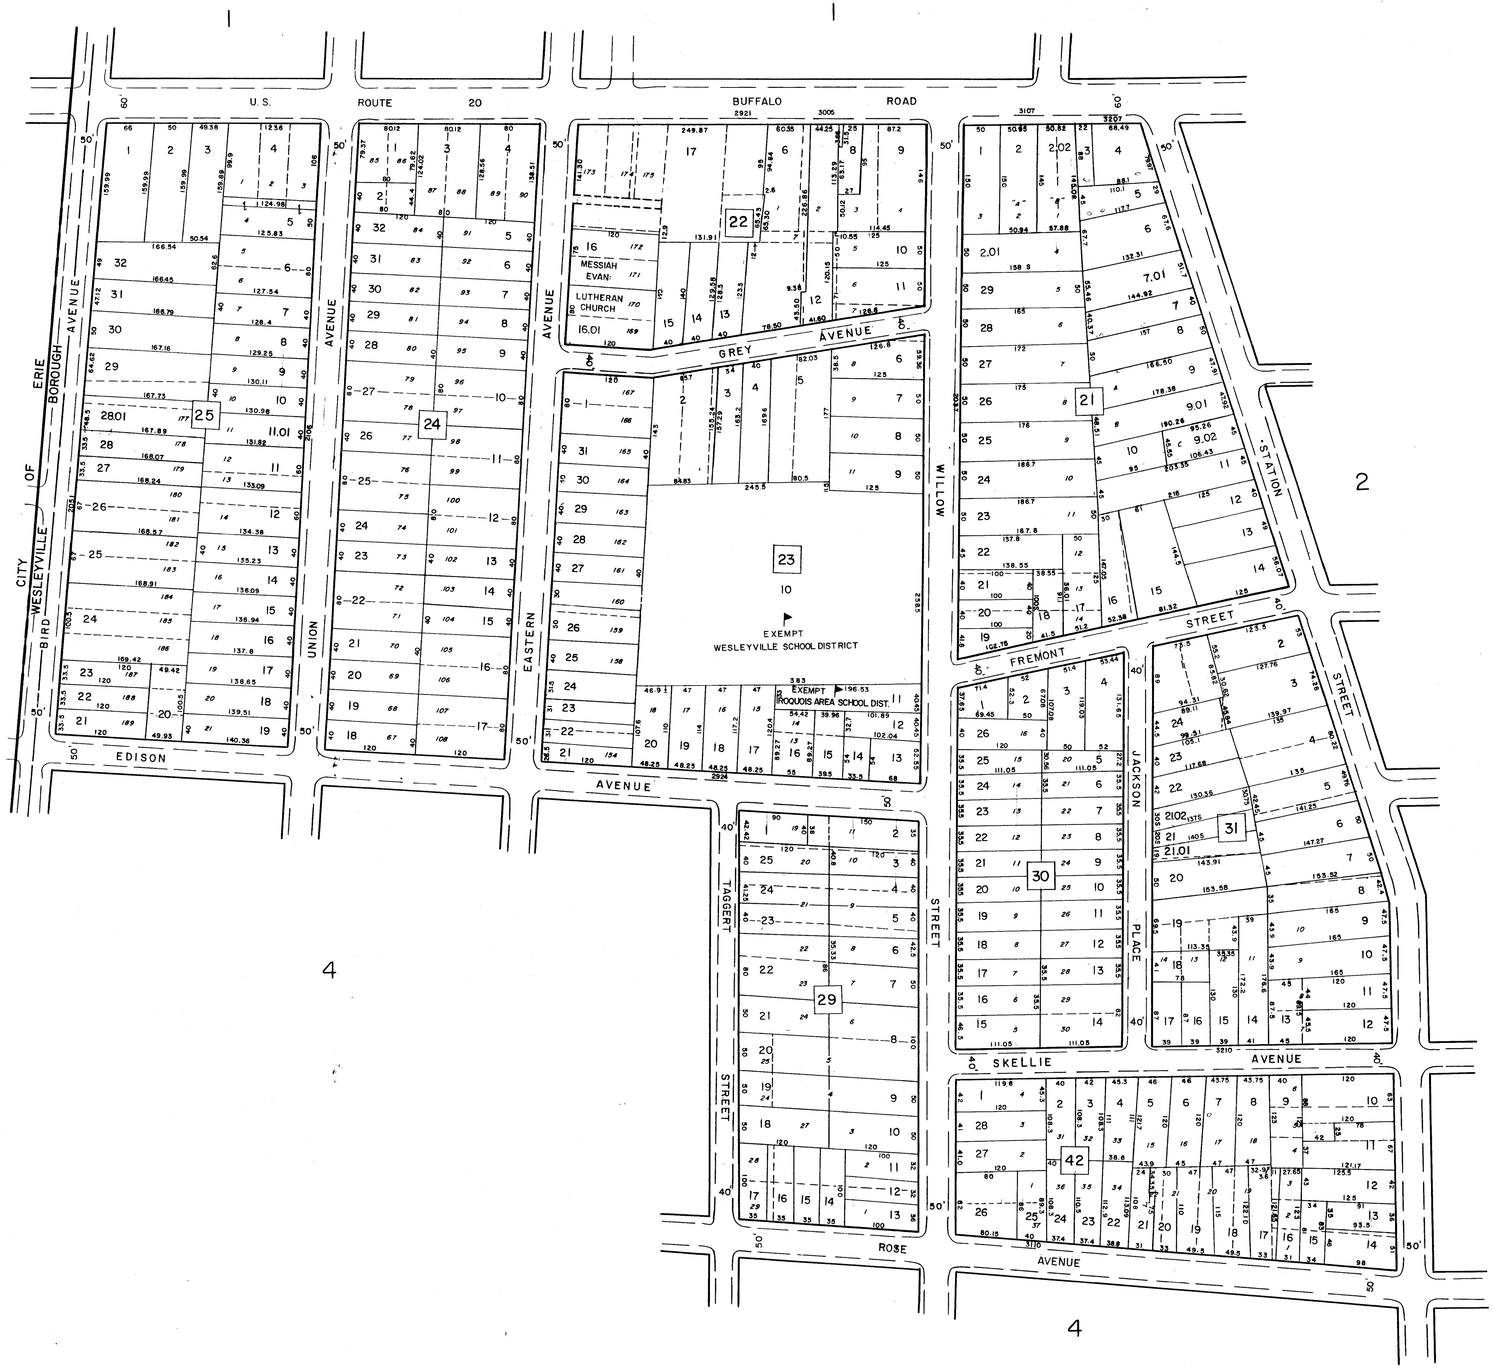

DRAFTED BY. B.M.
CHECKED BY. ES

FOR TAX PURPOSES ONLY

PREPARED BY

AMERICAN AIR SURVEYS, INC.
907 PENN AVENUE, PITTSBURGH, PA. 15222
NEW YORK PHILADELPHIA ATLANTA

Legend

State line		Right of way		Original block designation	(36)
County line		Easement		Lot or parcel number	13
Township line		Edge of roadway		Deed lot number	97
Corporate limit		Railroad		Block number	2
Sanitary district	S	Stream	▶	School	
Property line		Scaled dimension	S	Cemetery	Cem

Revisions

1	1-25-69	9		17	
2	3-11-70-10/30/72-7/18/74-12/10/81	10		18	
3	12/8/87-12/15/99-2/6/01-	11		19	
4		12		20	
5		13		21	
6		14		22	
7		15		23	
8		16		24	

ERIE COUNTY

Office of Assessor


PENNSYLVANIA

WESLEYVILLE BOROUGH

Map No. 3

Photo No.: 565 Scale: 1" = 100'

Date, Photography: 4-29-65 Date, Map: 12-16-65

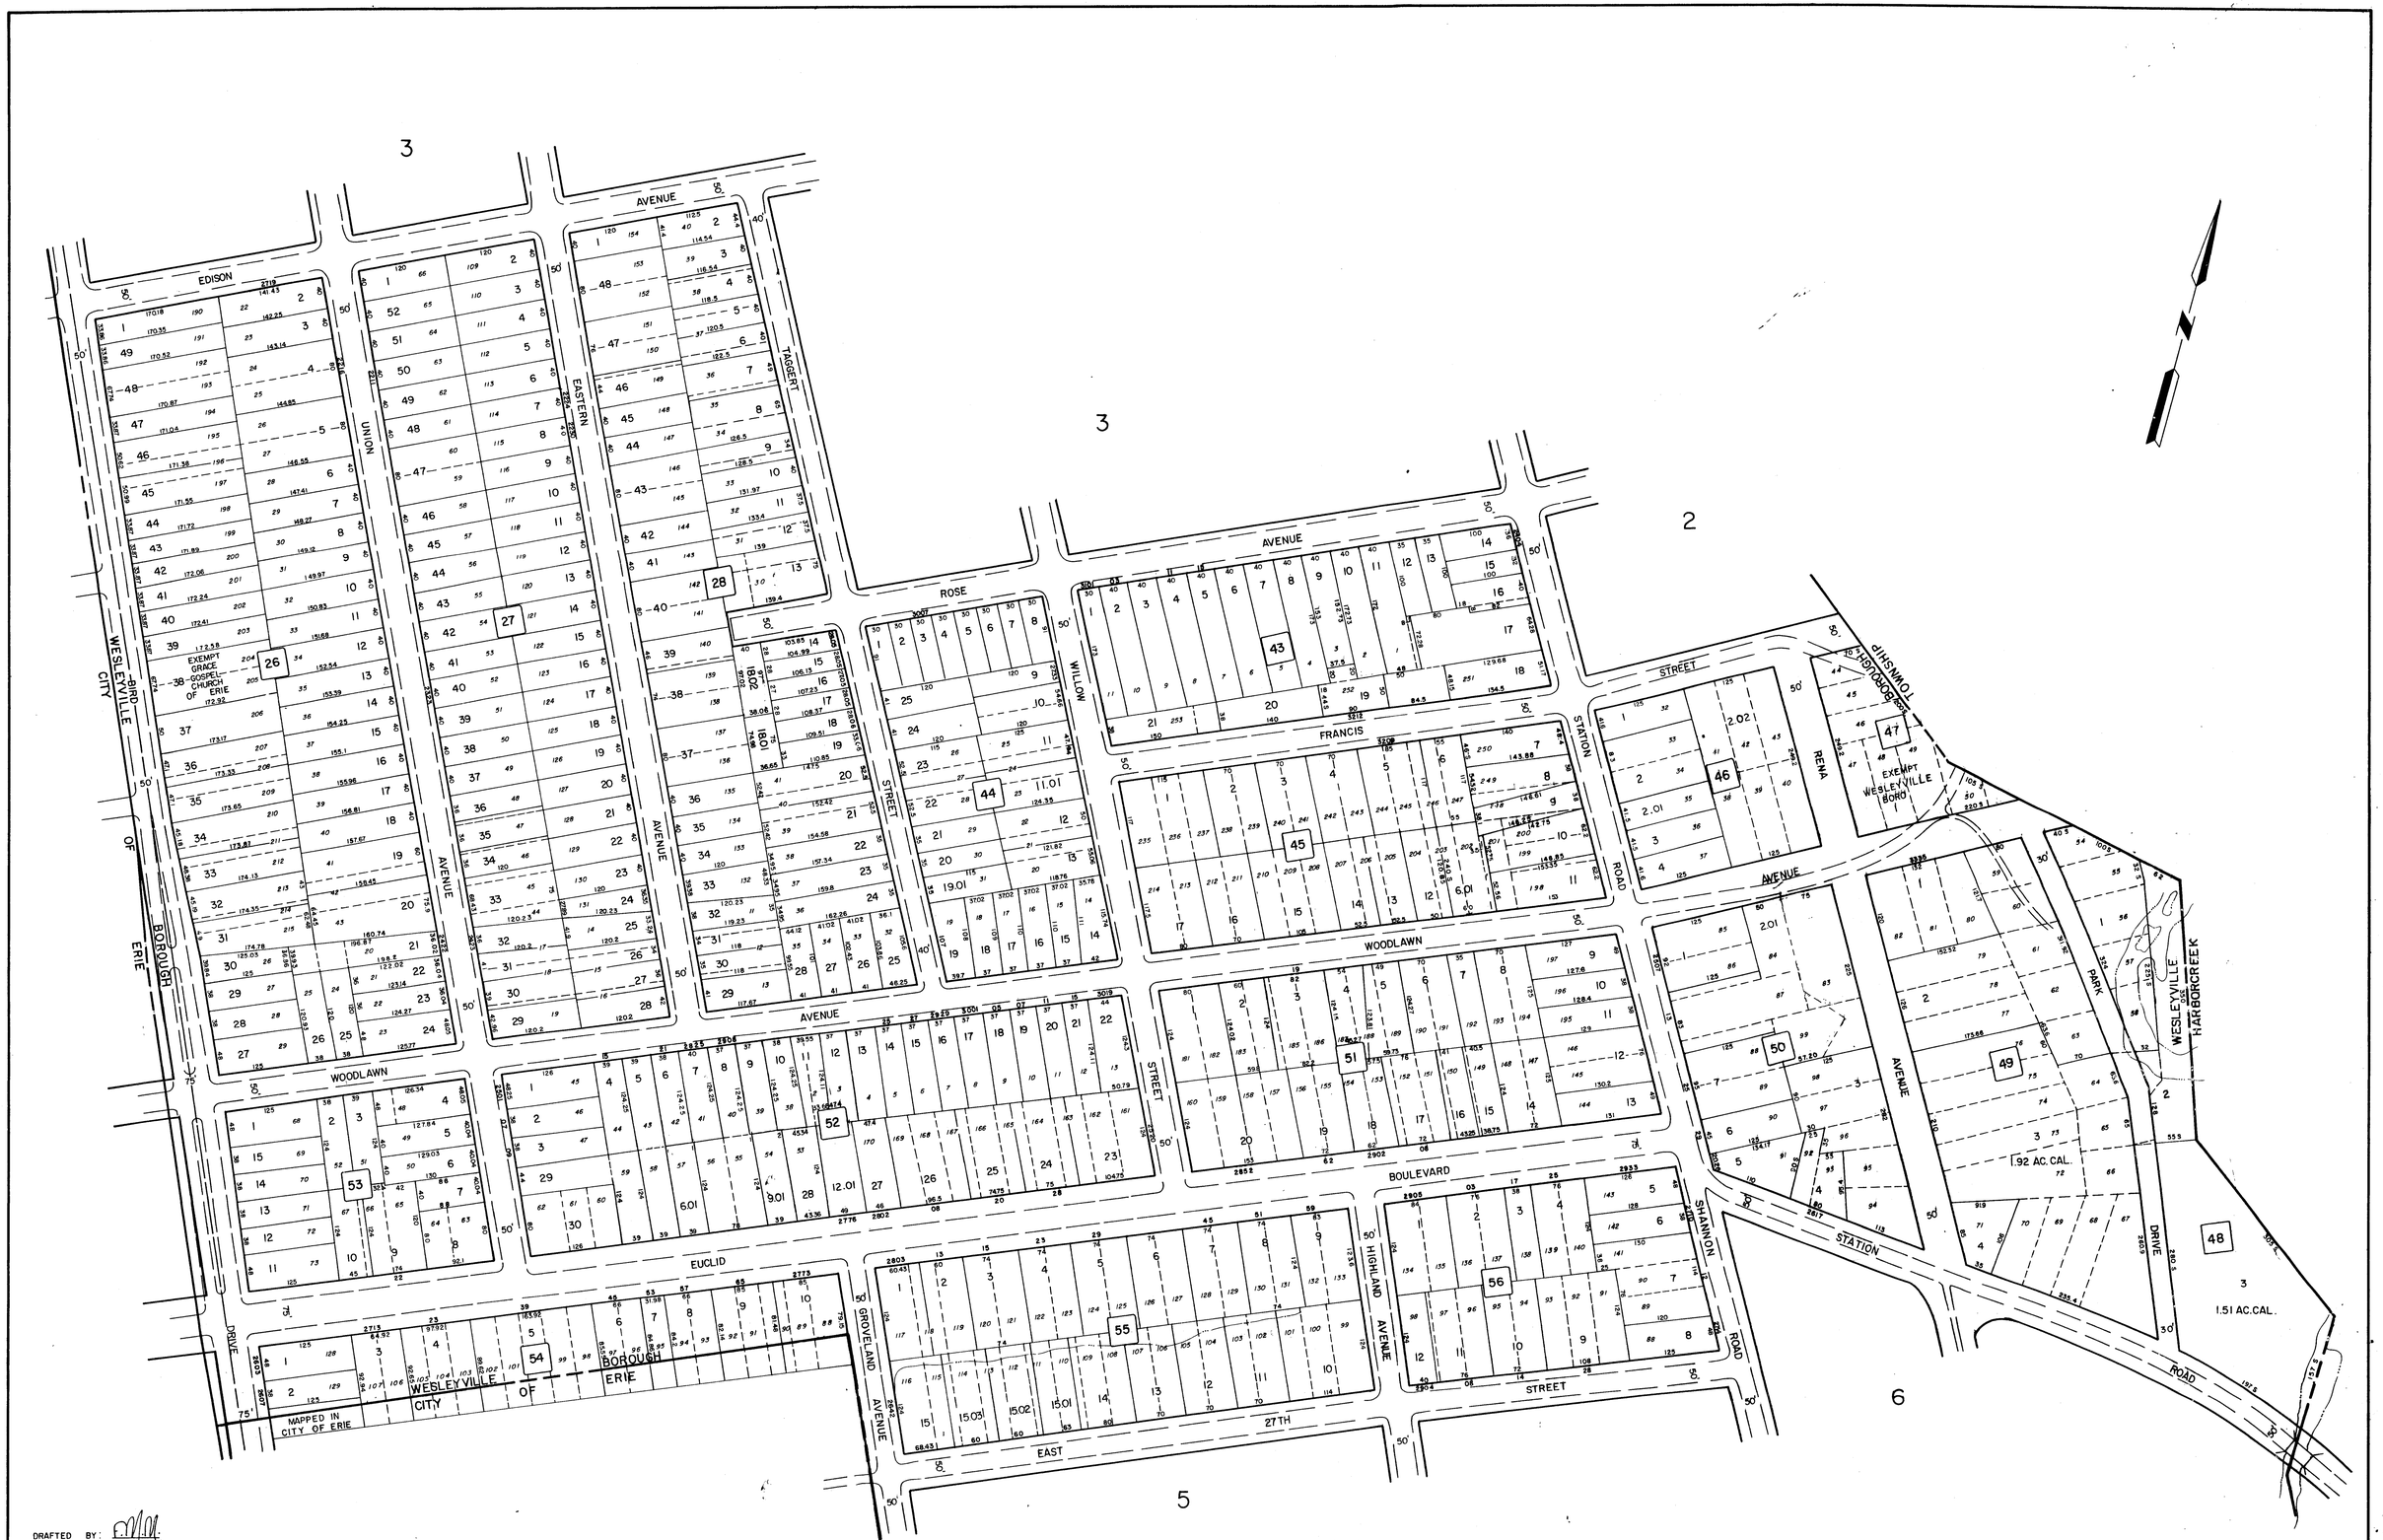

DRAFTED BY: F.M.M.

CHECKED BY: ES

FOR TAX PURPOSES ONLY

PREPARED BY

AMERICAN AIR SURVEYS, INC.

907 PENN AVENUE, PITTSBURGH, PA. 15222

NEW YORK PHILADELPHIA ATLANTA

Legend

State line	Right of way	Original block designation	(56)
County line	Easement	Lot or parcel number	13
Township line	Edge of roadway	Deed lot number	27
Corporate limit	RAILROAD	Block number	2
Sanitary district	STREAM	School	▶
Property line	SCALED DIMENSION	Cemetery	Cem
Original lot line	Deed dimension	Church	+

Revisions

1	1-25-69	9		17	
2	3-11-70-10/30/72-1/18/73-9/28/73-	10		18	
3	1/23/92-2/25/94-E/18/04-	11		19	
4		12		20	
5		13		21	
6		14		22	
7		15		23	
8		16		24	

ERIE COUNTY

Office of Assessor

PENNSYLVANIA

WESLEYVILLE BOROUGH

Map No. 4

Photo No.: 565 Scale: 1" = 100'

Date, Photography: 4-29-65 Date, Map: 12-16-65



DRAFTED BY: A.V.D.

CHECKED BY: E.S.

FOR TAX PURPOSES ONLY

PREPARED BY

AMERICAN AIR SURVEYS, INC.
907 PENN AVENUE, PITTSBURGH, PA. 15222
NEW YORK PHILADELPHIA ATLANTA

Legend

State line	Right of way	Original block designation	(36)
County line	Easements	Lot or parcel number	13
Township line	Edge of roadway	Deed lot number	27
Corporate limit	Railroad	Block number	2
Sanitary district	Stream	School	▶
Property line	Scaled dimension	Cemetery	Cem
	Deed dimension	Church	†

Revisions

1	1-25-69	9		17	
2	3-12-70	10		18	
3	5-26-70-10/30/72-9/28/73-12/29/76	11		19	
4	11/12/80-12/14/83-12/10/84-10/25/85	12		20	
5	12/8/87-12/17/90-12/15/99-	13		21	
6		14		22	
7		15		23	
8		16		24	

ERIE COUNTY

Office of Assessor


PENNSYLVANIA

WESLEYVILLE BOROUGH

Map No. 5

Photo No.: 565 Scale: 1"=100'

Date, Photography: 4-29-65 Date, Map: 12-16-65

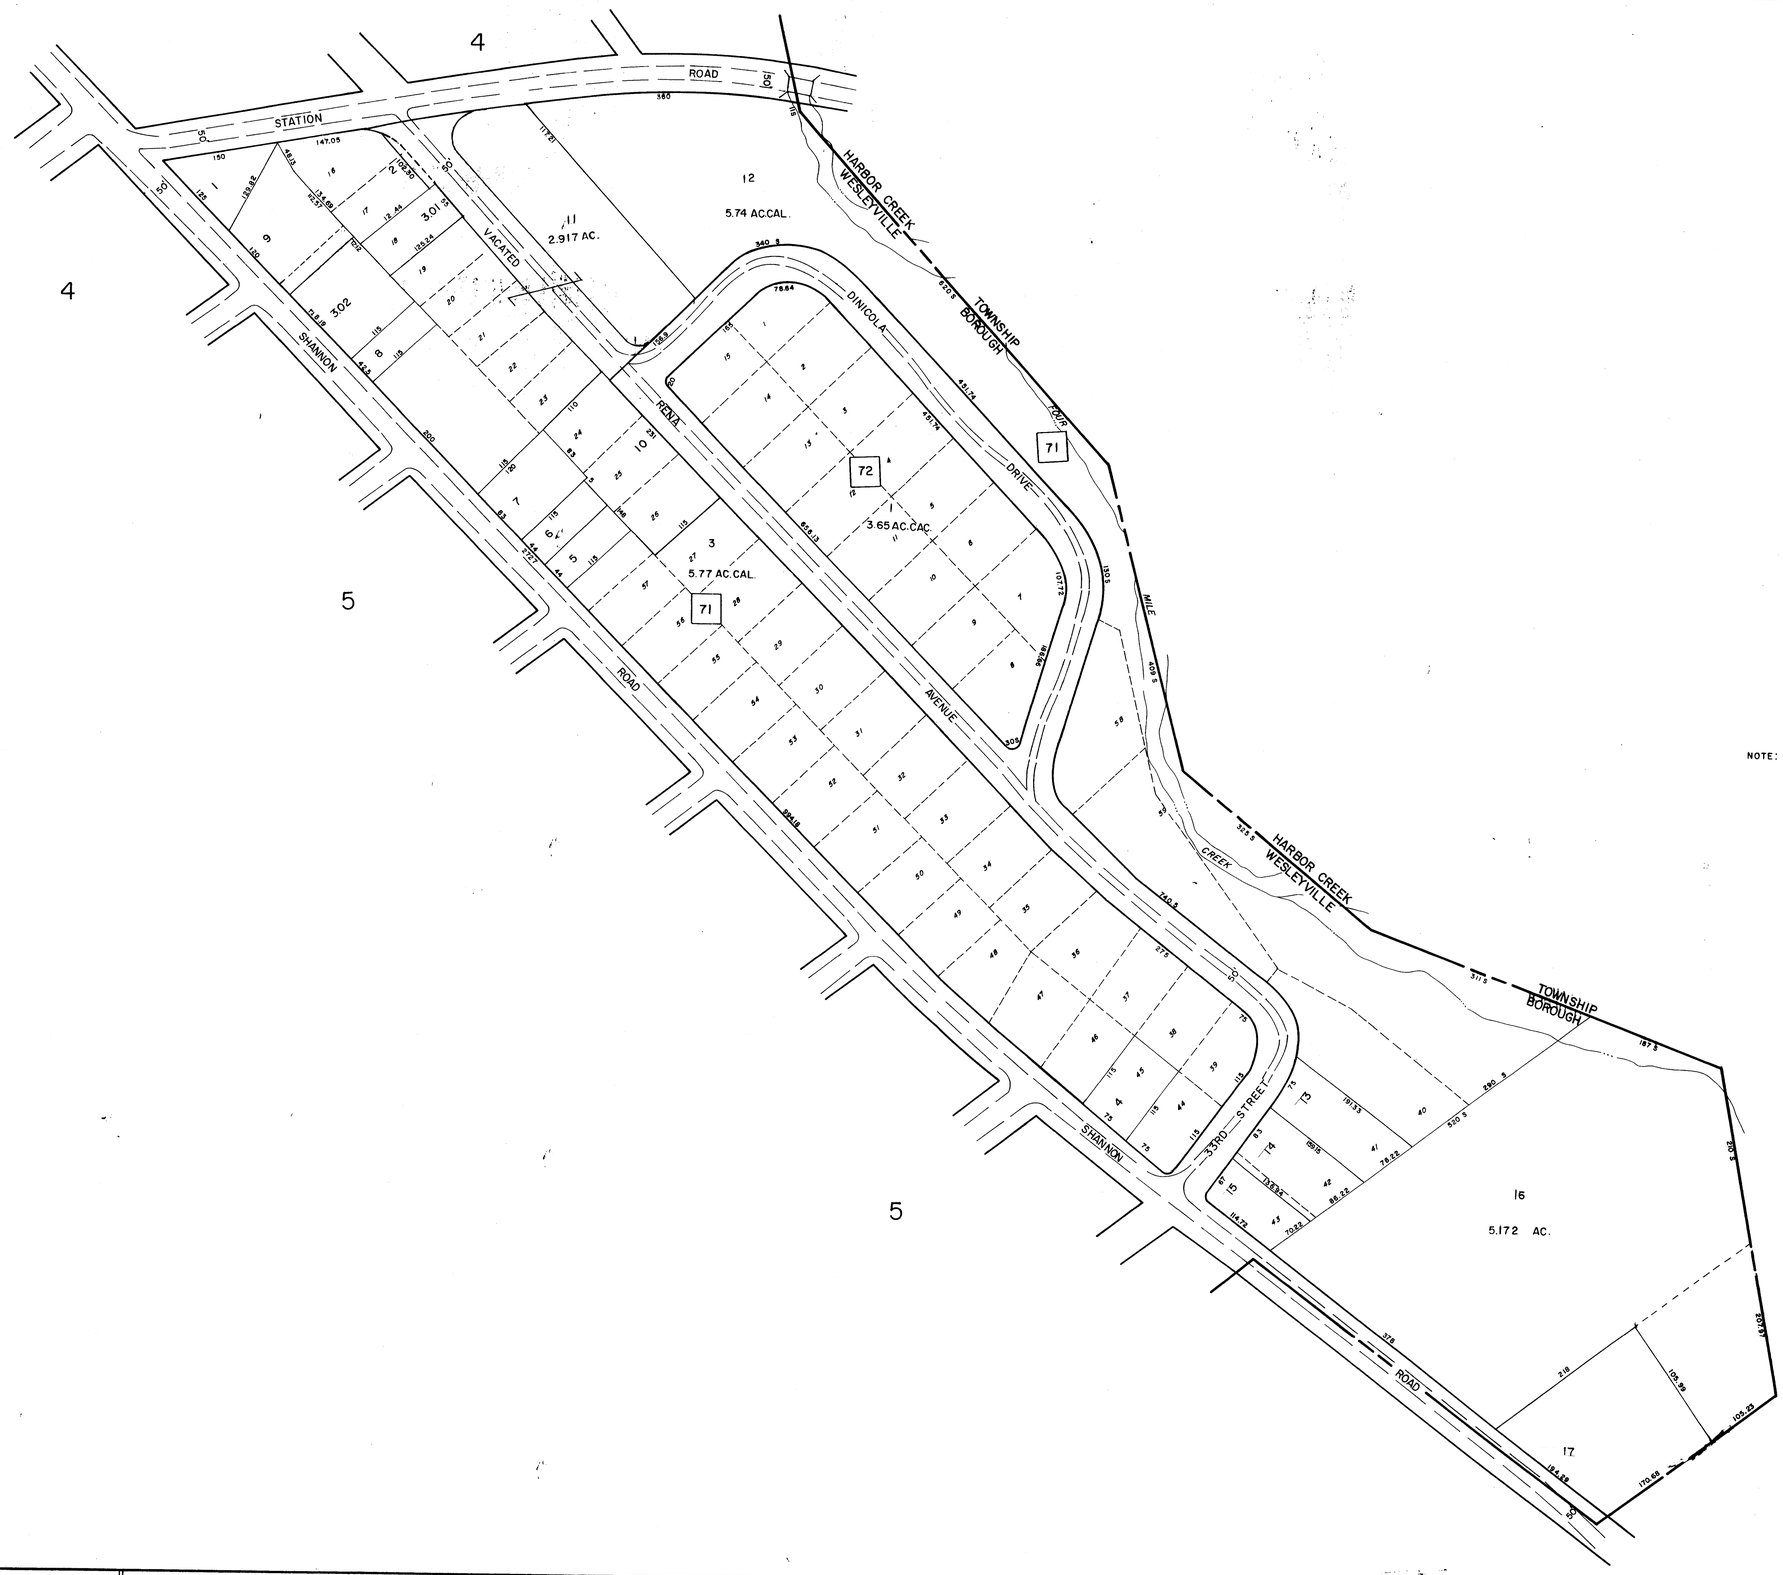

NOTE: BLK. 71 - PCL. 3 M. V. IRWIN TRAILER COURT
BLK. 71 - PCL. 10 " " " " "
BLK. 72 - PCL. 1 " " " " "
BLK. 73 - PCL. 2 " " " " "
BLK. 73 - PCL. 6 " " " " "

DRAFTED BY: JM
CHECKED BY: ES

FOR TAX PURPOSES ONLY

PREPARED BY

AMERICAN AIR SURVEYS, INC.
907 PENN AVENUE, PITTSBURGH, PA. 15222
NEW YORK PHILADELPHIA ATLANTA

Legend

State line	Right of way	Original block designation	(36)
County line	Easements	Lot or parcel number	13
Township line	Edge of roadway	Deed lot number	97
Corporate limit	Railroad	Block number	2
Sanitary district	S Stream	School	
Property line	Scaled dimension	S Cemetery	Cem
Original lot line	Deed dimension	D Church	†

Revisions

1	1-25-69 RLS	9		17	
2	3-11-70-7/22/71-3/4/75-9/22/78	10		18	
3	12/15/99-	11		19	
4		12		20	
5		13		21	
6		14		22	
7		15		23	
8		16		24	

ERIE COUNTY

Office of Assessor

PENNSYLVANIA

WESLEYVILLE BOROUGH

Map No. 6

Photo No.: 565 Scale: 1" = 10'


WESLEYVILLE SEWER MAP

INDEX

DRAWING NO	NAME OF STREETS
MB-10	OTTO ST.
MB-11-A	PEARL AVE.
MB-11-B	——"——
MB-12-A	NORTH ST.
MB-12-B	——"——
MB-13-A	BUFFALO RD.
MB-13-B	——"——
MB-14	GRAY ST.
MB-15	SOUTH ST.
MB-16-A	FREMONT ST.
MB-16-B	——"——
MB-17-A	EDISON AVE.
MB-17-B	——"——
MB-18	IDLEWOOD DR.
MB-19 SEE MB-18	SKELLIE AVE.
MB-20	ROSE AVE.
MB-21	FRANCIS AVE.
MB-22-A	WOODLAWN AVE.
MB-22-B	——"——
MB-23-A	EUCLID BLVD.
MB-23-B	——"——
MB-24-A	STATION RD.
MB-24-B	——"——
MB-25-A	BIRD DR.
MB-25-B	——"——
MB-25-C	——"——
MB-26-A	UNION AVE.
MB-26-B	——"——
MB-26-C	——"——
MB-27-A	EASTERN AVE.


DRAWING NO	NAME OF STREETS
MB-27-B	EASTERN AVE.
MB-28	TAGGERT ST.
MB-29-A	WILLOW ST.
MB-29-B	——"——
MB-30	WESLEY ST.
MB-31 SEE MB-14	JACKSON PL.
MB-32 SEE MB-22-B	RENA AVE.
MB-33-A	CENTER ST.
MB-33-B	——"——
	PARK DR.
MB-38	EAST 27th ST.
MB-39	EAST 28th ST.
MB-40	EAST 29th ST.
MB-41	EAST 30th ST.
MB-42	EAST 31st ST.
MB-43	EAST 32nd ST.
MB-44	EAST 33rd ST.
MB-45-A	GROVELAND AVE.
MB-45-B	——"——
MB-46-A	HIGHLAND AVE.
MB-46-B	——"——
MB-47-A	SHANNON RD.
MB-47-B	——"——

LAWRENCE PARK TOWNSHIP

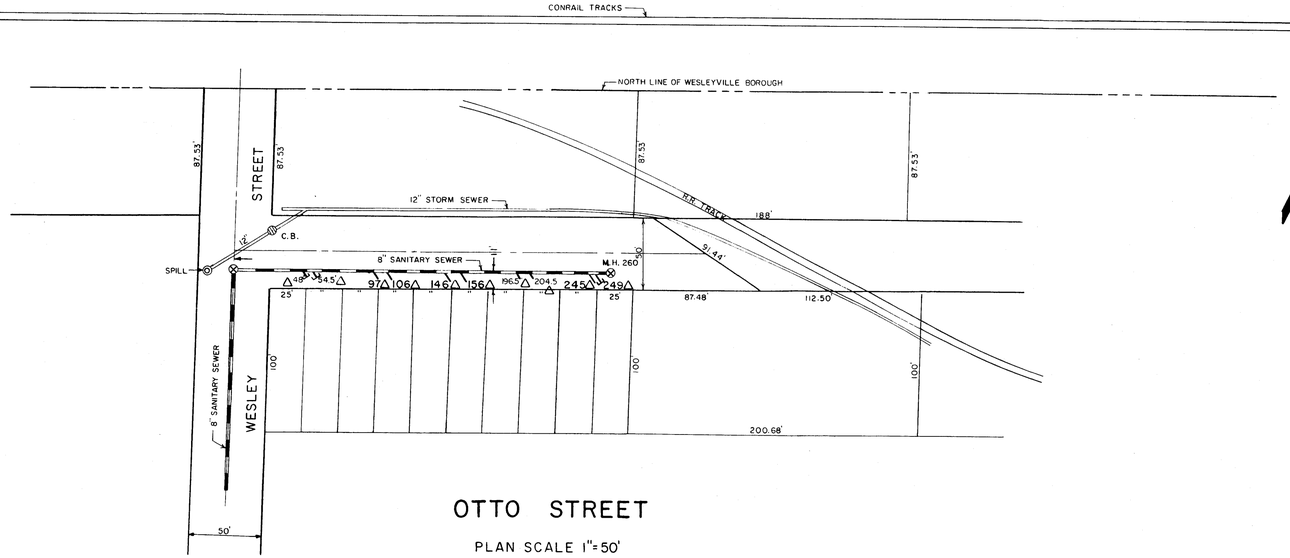

OTTO STREET

PLAN SCALE 1"=50'

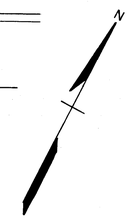

SANITARY SEWER
REHABILITATION — 1998

ALL DISTANCES MEASURED FROM
CENTER OF NOTED MANHOLE


LEGEND

△ REPLACED LATERAL WYE

⊗ REPLACED MANHOLE

⊥ LATERAL CAPPED AT WYE

NOTE: REPLACED EXISTING 8" VCP WITH 8" PVC PIPE MH W46 TO W47.

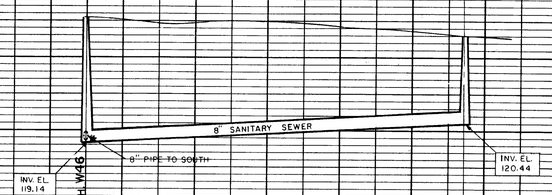

PROFILE SCALE
HORIZ. 1"=50'
VERT. 1"=5'

URBAN ENGINEERS, INC.

OTTO STREET
SEWER MAP
BOROUGH OF WESLEYVILLE
ERIE COUNTY, PENNSYLVANIA

SCALE: AS SHOWN	DATE: FEBRUARY 1977
DRAWN BY: S.T.	APPROVED BY:
TRACED BY: J.J.D. & R.A.S.	DRAWING NO. MB-10
CHECKED BY: S.T.	

REVISED: JAN. 1999


PLAN — SURVEYED, PLOTTED, NOTE BOOK, No., BY, DATE, ALIGNMENT CHECKED, R. OF WAY CHECKED

PROFILE — SURVEYED, PLOTTED, NOTE BOOK, No., GRADES CHECKED, R.W.L. NOTED, STRUCTURE LOCATIONS CHECKED

Printed in U. S. A.
On IMPERIAL Tracing Cloth


PLATE 1 PLAN - PROFILE B P R STANDARD
EUGENE DIETZGEN CO., CHICAGO, NEW YORK

Printed in U.S.A.
On IMPERIAL Tracing Cloth

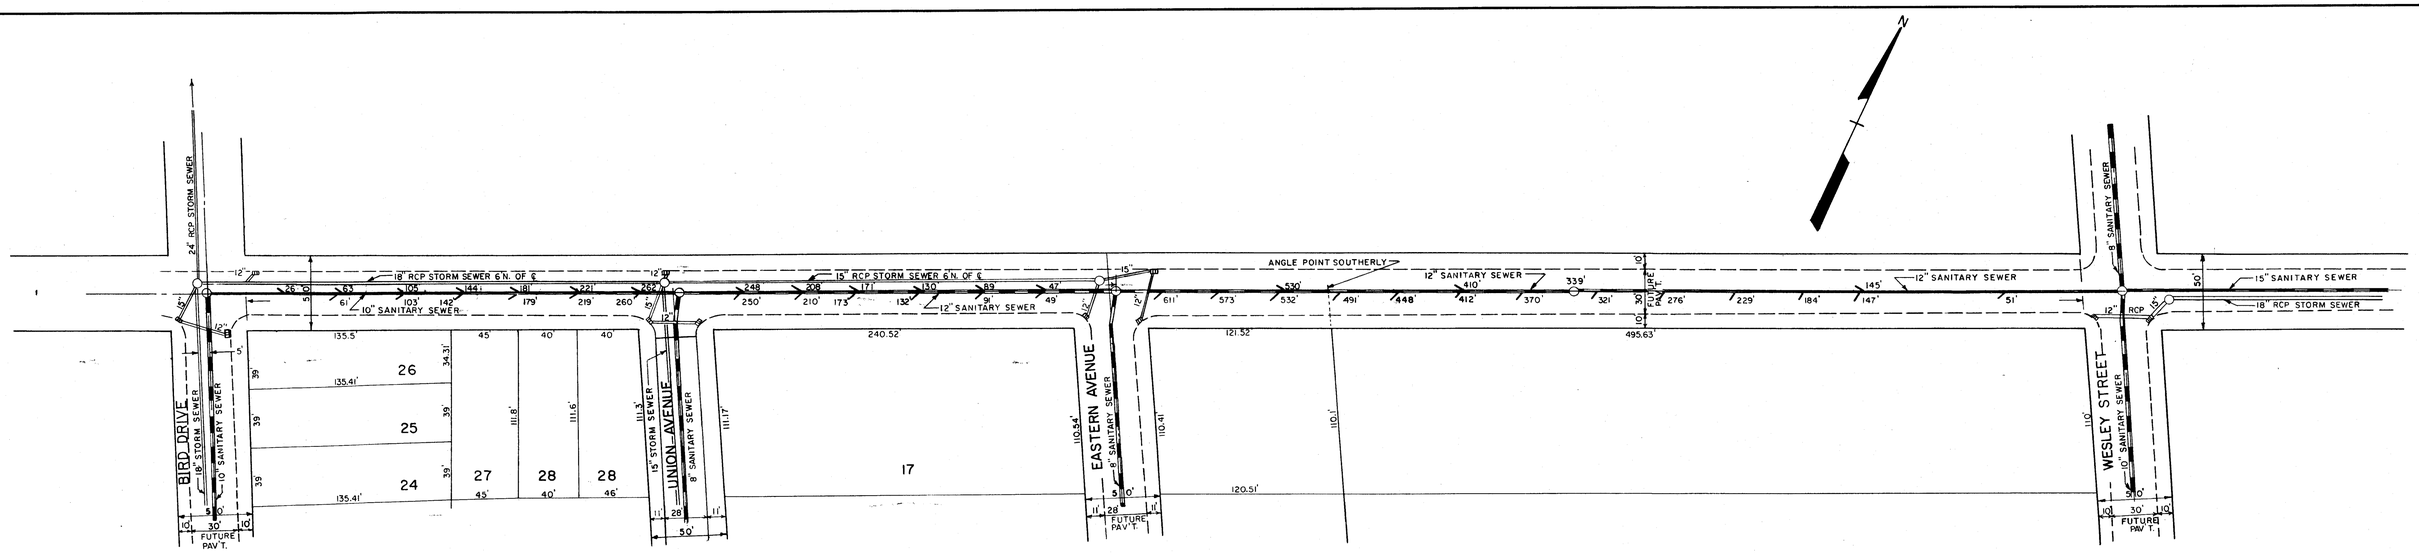

PEARL AVENUE

PLAN SCALE 1"= 50'

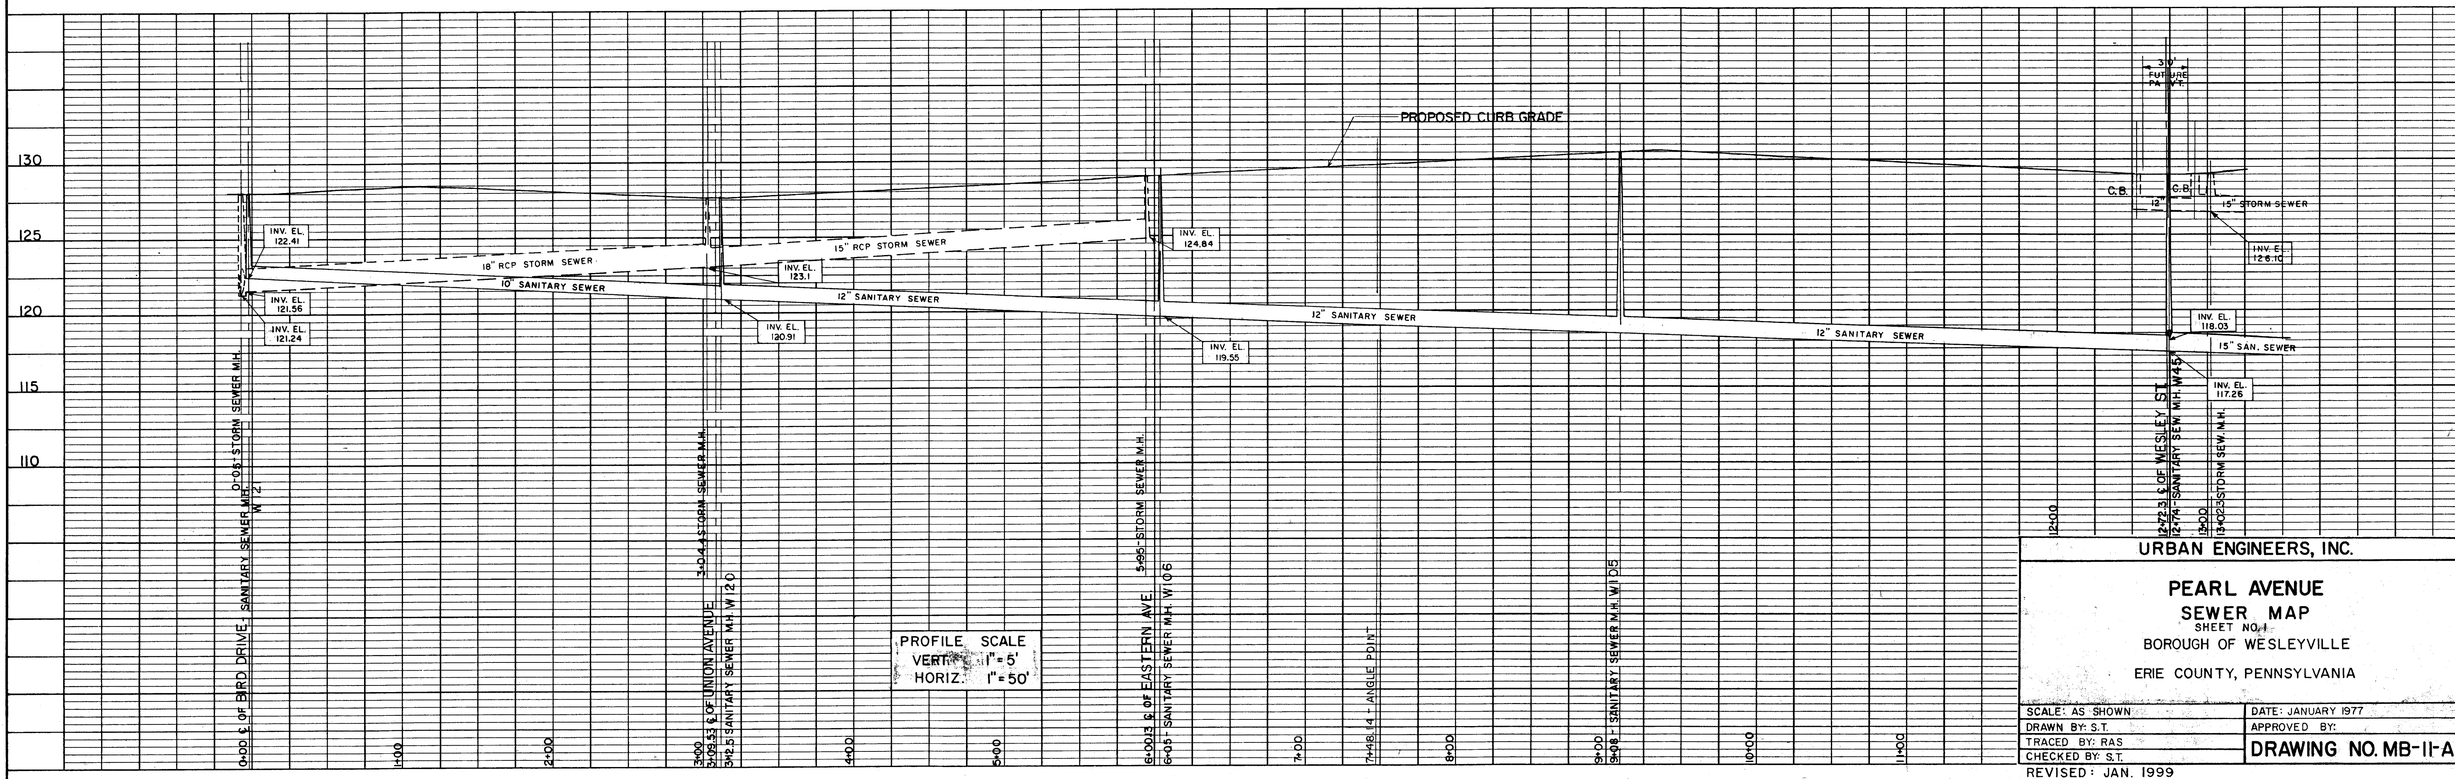

PROFILE SCALE
VERT. 1"= 5'
HORIZ. 1"= 50'

URBAN ENGINEERS, INC.

PEARL AVENUE
SEWER MAP
SHEET NO. 1
BOROUGH OF WESLEYVILLE
ERIE COUNTY, PENNSYLVANIA

SCALE: AS SHOWN	DATE: JANUARY 1977
DRAWN BY: S.T.	APPROVED BY:
TRACED BY: RAS	DRAWING NO. MB-11-A
CHECKED BY: S.T.	

REVISED: JAN. 1999

PLAN — SURVEYED, PLOTTED, NOTE BOOK, No., DATE, BY, ALIGNMENT CHECKED, RT. OF WAY CHECKED


PROFILE — SURVEYED, PLOTTED, NOTE BOOK, No., DATE, BY, GRADES CHECKED, R. W.'s NOTED, STRUCTURE NOTATIONS CHECKED

Printed in U. S. A.
On IMPERIAL Tracing Cloth

PLATE I PLAN - PROFILE B P R STANDARD
EUGENE DIETZGEN CO., CHICAGO, NEW YORK

Printed in U.S.A.
On IMPERIAL Tracing C


PLAN
SURVEYED
PLOTTED
NOTE BOOK
No.
ALIGNMENT CHECKED
RT. OF WAY CHECKED
BY
DATE

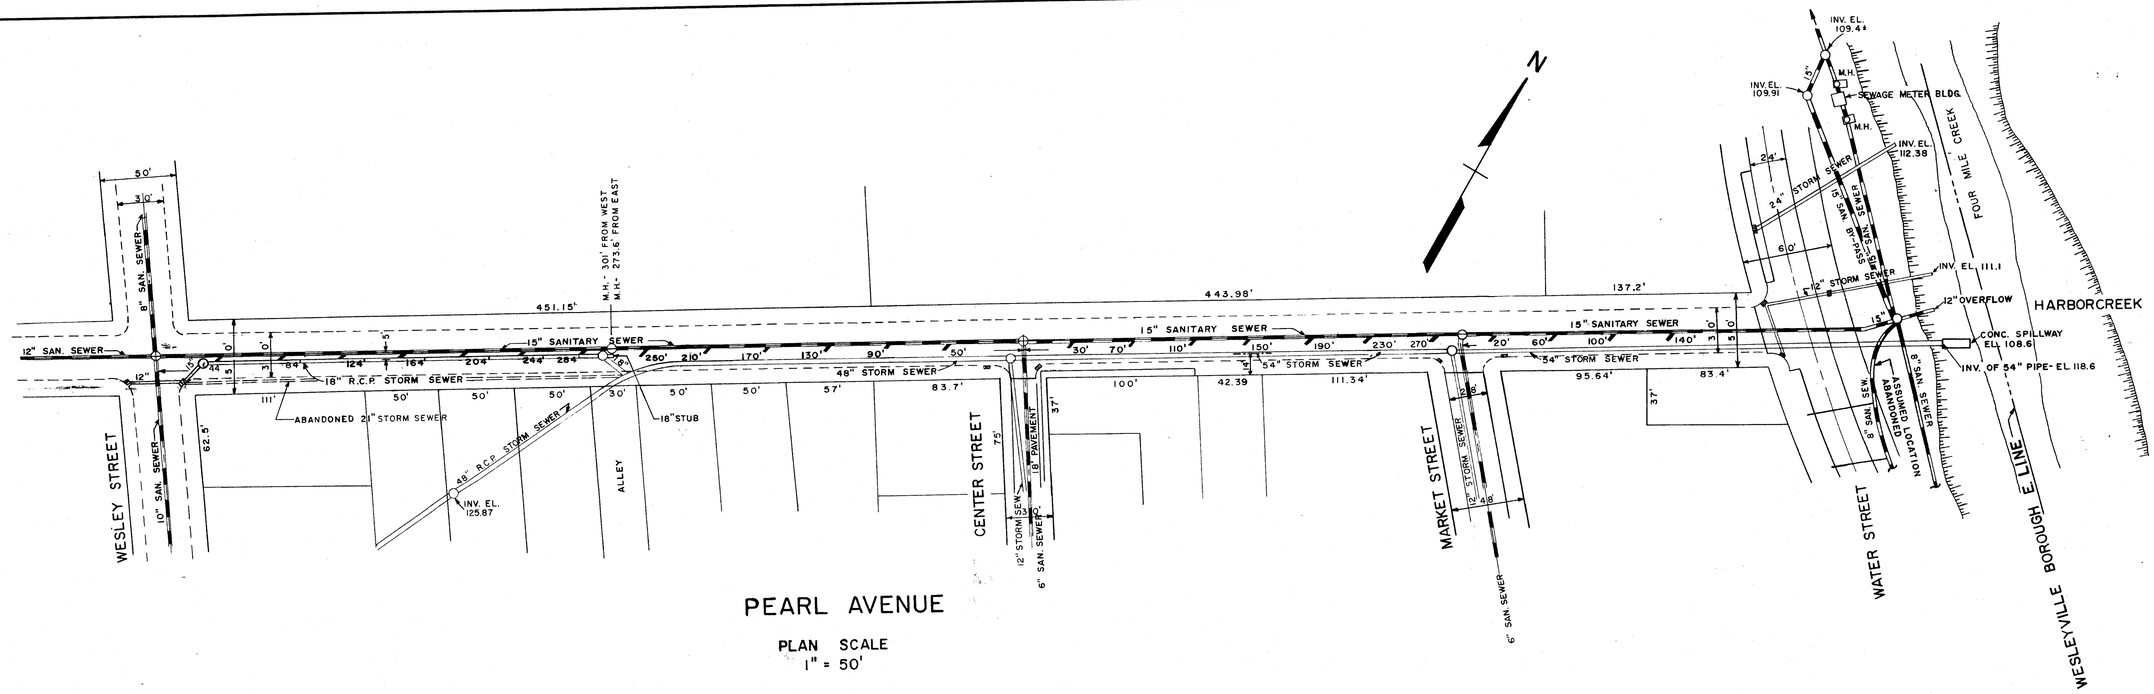

PEARL AVENUE

PLAN SCALE
1" = 50'

PROFILE
SURVEYED
PLOTTED
NOTE BOOK
No.
GRADES CHECKED
R. R.'s NOTED
STRUCTURE ELEVATIONS CHECKED
BY
DATE

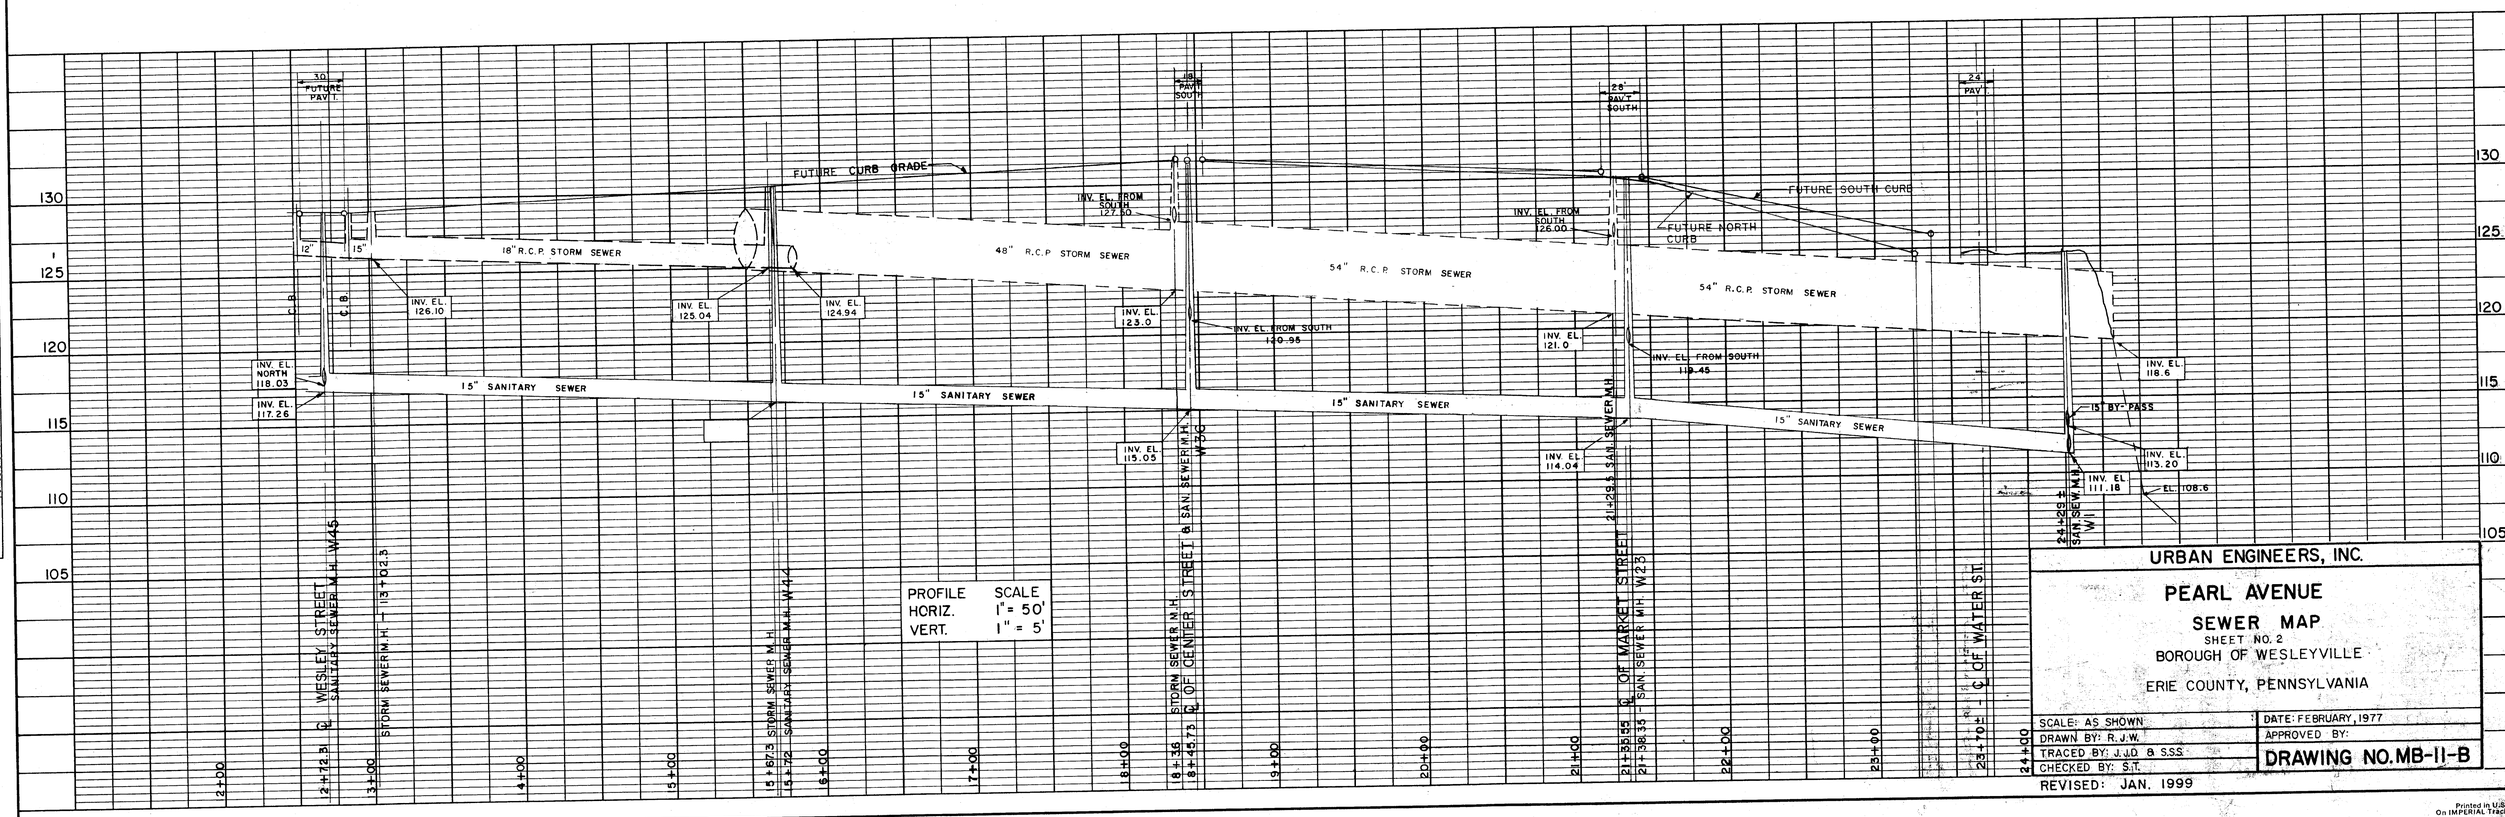

PROFILE SCALE
HORIZ. 1" = 50'
VERT. 1" = 5'

URBAN ENGINEERS, INC.

PEARL AVENUE

SEWER MAP


SHEET NO. 2
BOROUGH OF WESLEYVILLE
ERIE COUNTY, PENNSYLVANIA

SCALE: AS SHOWN	DATE: FEBRUARY, 1977
DRAWN BY: R.J.W.	APPROVED BY:
TRACED BY: J.J.O & S.S.S	DRAWING NO. MB-11-B
CHECKED BY: S.T.	

REVISED: JAN. 1999

PLATE 1 PLAN - PROFILE B P R STANDARD
EUGENE DIETZGEN CO., CHICAGO - NEW YORK

Printed in U. S. A.
On IMPERIAL Tracing Cloth

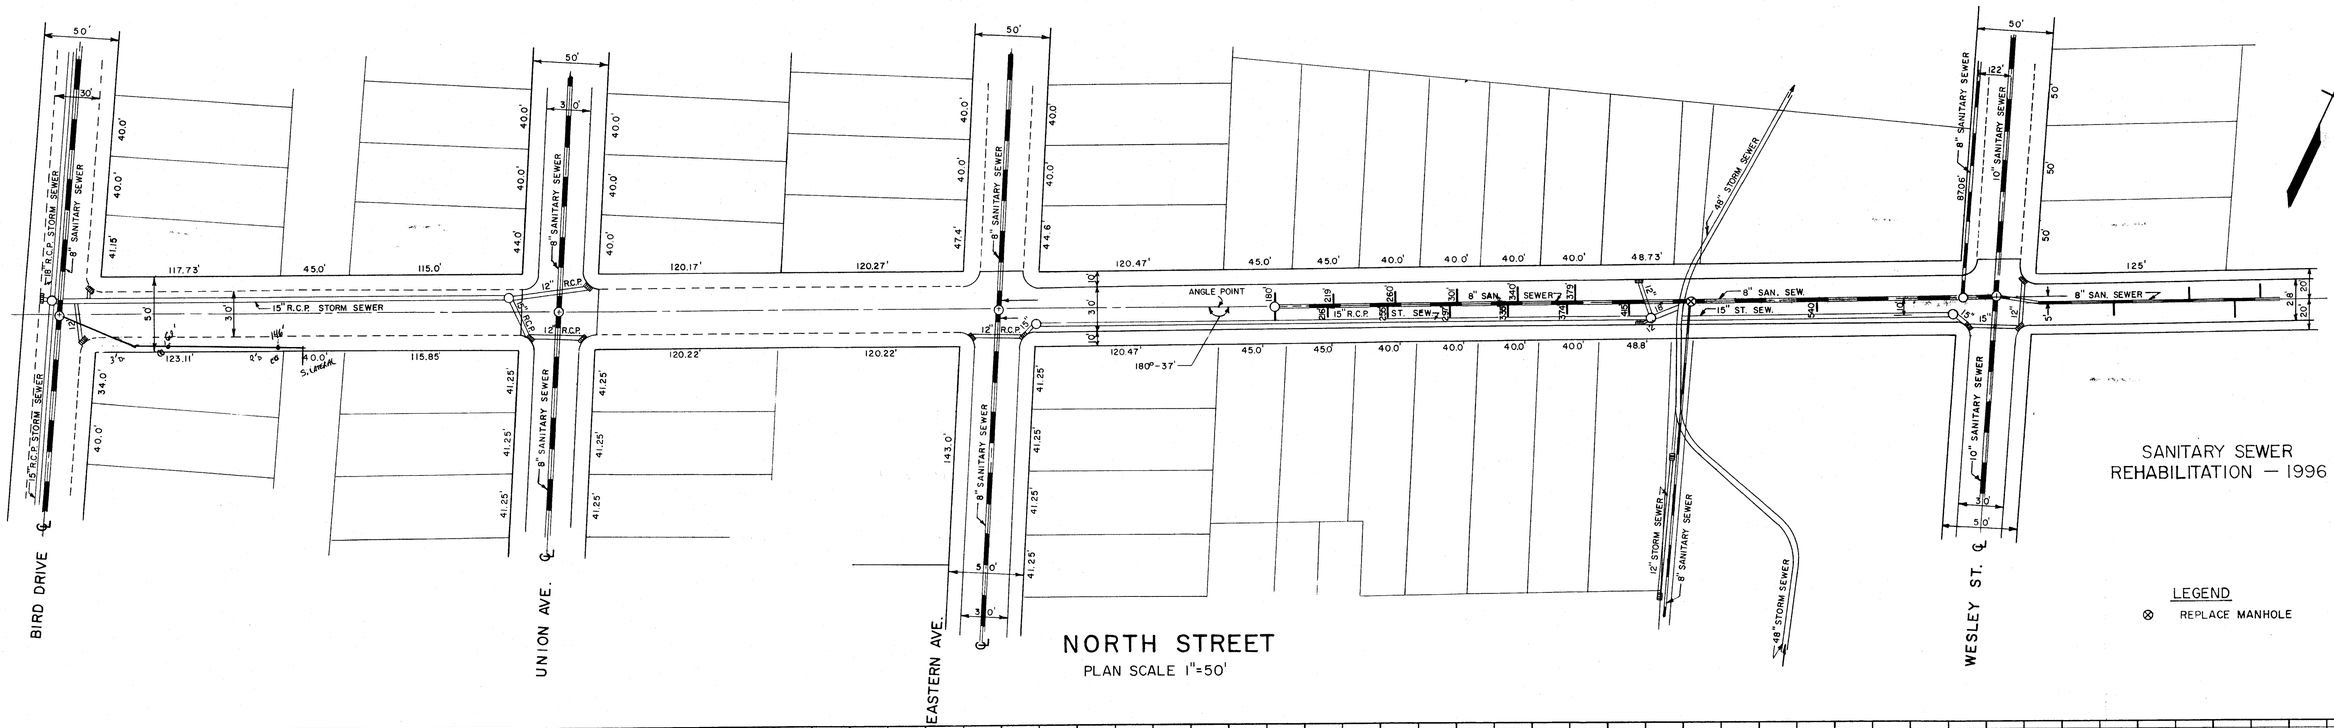

PLAN — SURVEYED, PLOTTED, GRADE CHECKED, R.R. CROSS., ST. OF WAY CHECKED, NOTE BOOK, No.

PROFILE — SURVEYED, PLOTTED, GRADE CHECKED, R.R. CROSS., STRUCTURE NOTATIONS CHECKED, NOTE BOOK, No.

DATE / BY

URBAN ENGINEERS, INC.


NORTH STREET
SEWER MAP
SHEET NO. I
BOROUGH OF WESLEYVILLE
ERIE COUNTY, PENNSYLVANIA

SCALE: AS SHOWN	DATE: JANUARY, 1977
DRAWN BY: S.T.	APPROVED BY:
TRACED BY: S.S.	DRAWING NO. MB-12-A
CHECKED BY: S.T.	

REVISED: JAN. 1999


Printed in U. S. A.
On IMPERIAL Tracing Cloth

PLATE 1 PLAN - PROFILE B P R STANDARD
EUGENE DIETZGEN CO., CHICAGO - NEW YORK

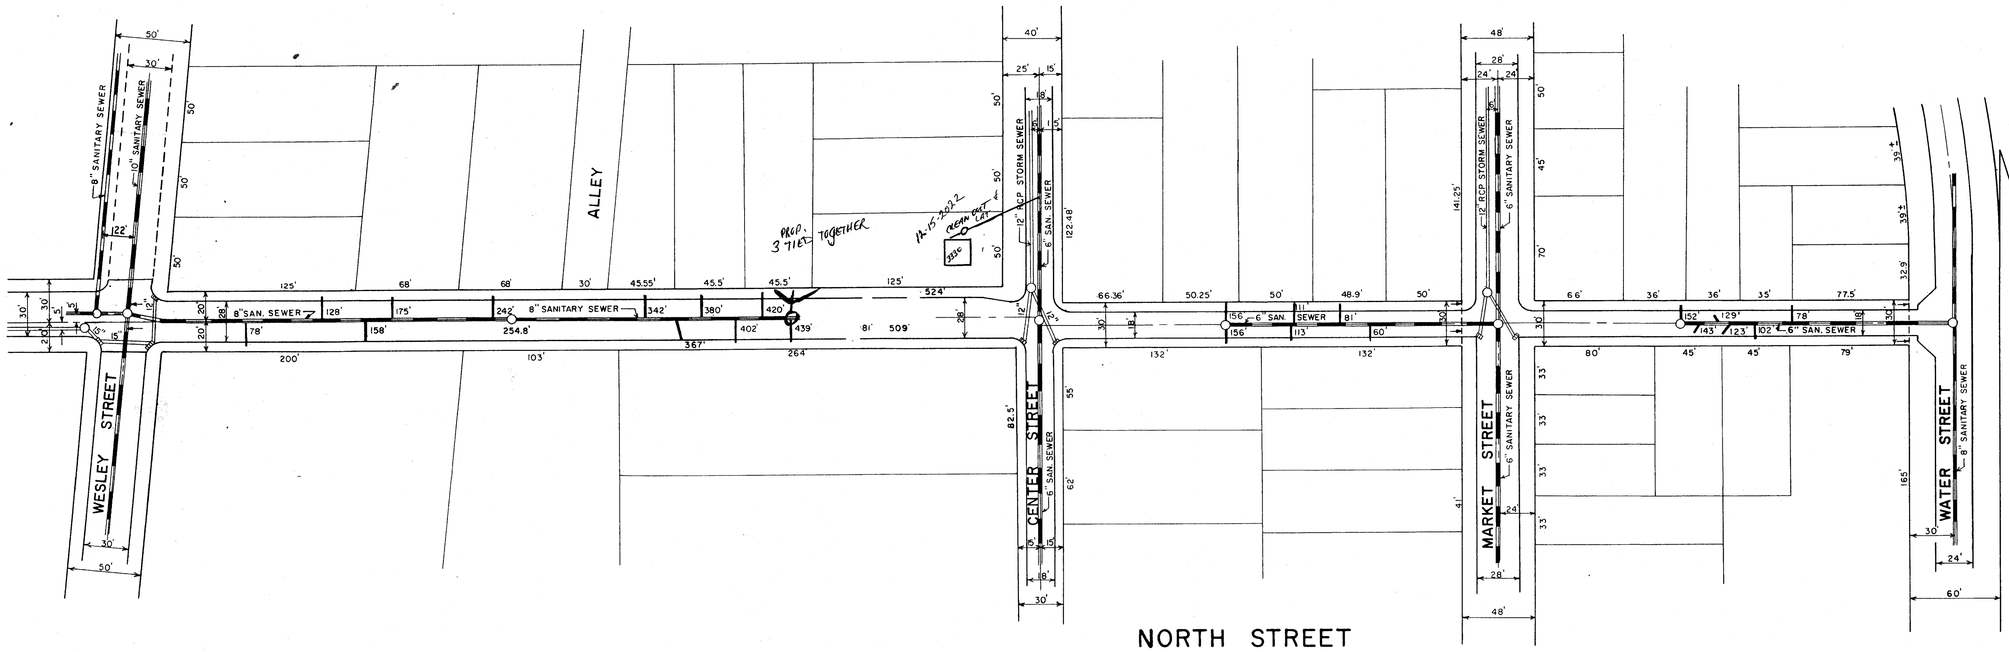

NORTH STREET

PLAN SCALE 1"=50'

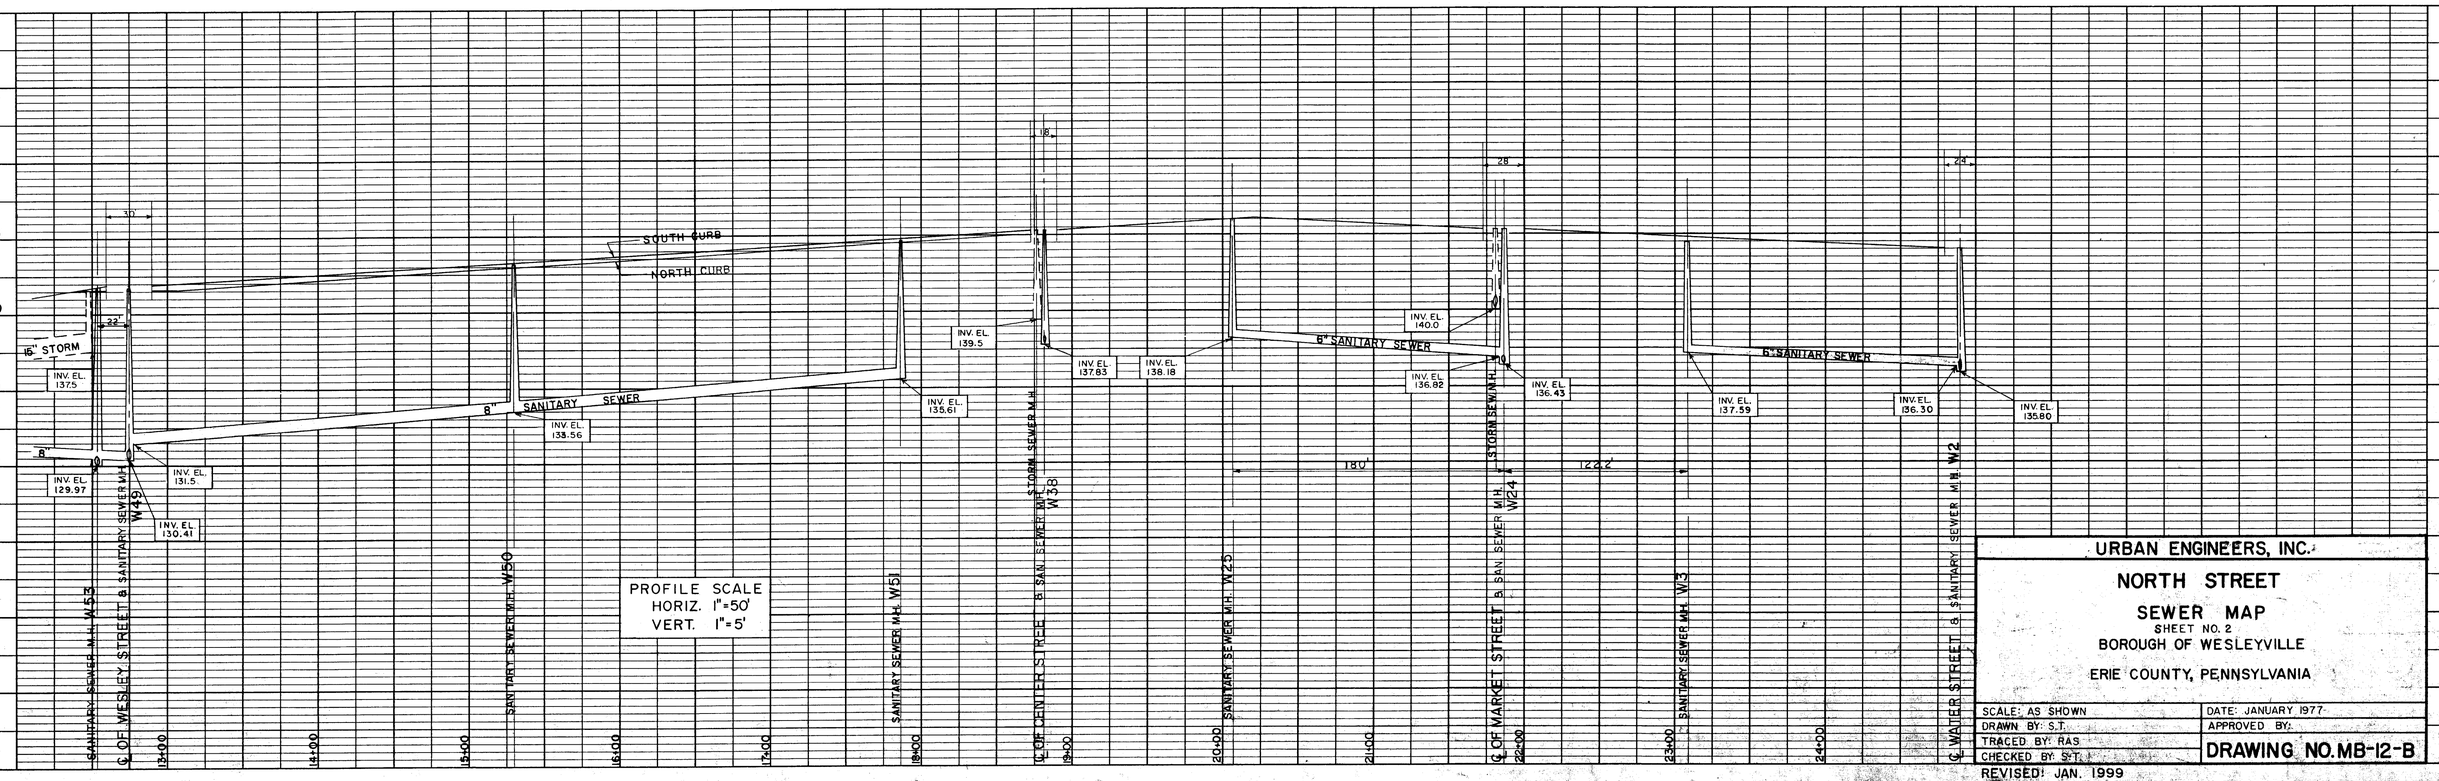

PROFILE SCALE
HORIZ. 1"=50'
VERT. 1"=5'

URBAN ENGINEERS, INC.

NORTH STREET
SEWER MAP
SHEET NO. 2
BOROUGH OF WESLEYVILLE
ERIE COUNTY, PENNSYLVANIA

SCALE: AS SHOWN	DATE: JANUARY 1977
DRAWN BY: S.T.	APPROVED BY:
TRACED BY: RAS	DRAWING NO. MB-12-B
CHECKED BY: S.T.	

REVISED! JAN. 1999


PLOT
DATE
BY
PLAN — SURVEYED, PLOTTED, ALIGNMENT CHECKED, R/W'S NOTED, NOTE BOOK, No.
PROFILE — SURVEYED, PLOTTED, GRADES CHECKED, R/W'S NOTED, STRUCTURE NOTATIONS CHECKED, NOTE BOOK, No.

Printed in U. S. A.
On IMPERIAL Tracing Cloth

PLATE 1 PLAN - PROFILE B P R STANDARD
EUGENE DIETZGEN CO., CHICAGO - NEW YORK

Printed in U.S.A.
On IMPERIAL Tracing

PLAN
SURVEYED
PLOTTED
NOTE BOOK
No.
DATE
BY
ALIGNMENT CHECKED
ELEV. & MAP CHECKED

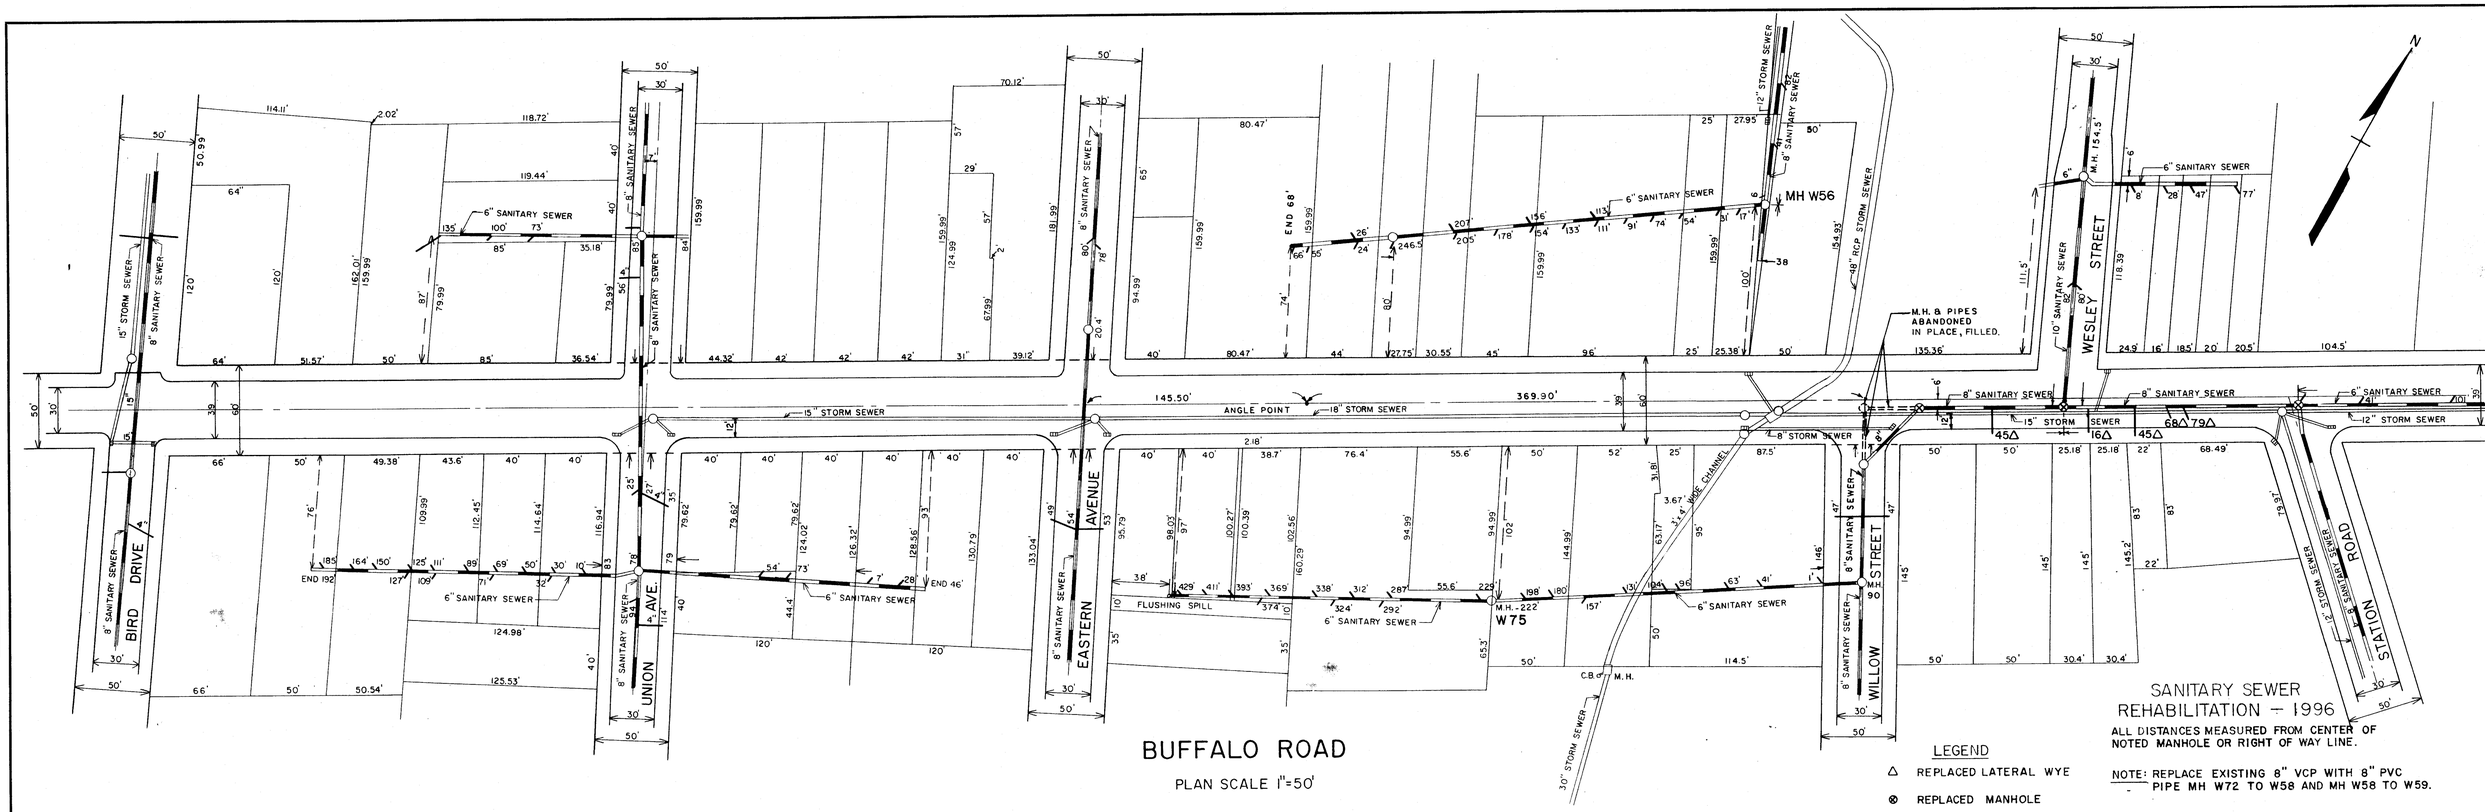

BUFFALO ROAD

PLAN SCALE 1"=50'

SANITARY SEWER REHABILITATION – 1996

ALL DISTANCES MEASURED FROM CENTER OF NOTED MANHOLE OR RIGHT OF WAY LINE.


NOTE: REPLACE EXISTING 8" VCP WITH 8" PVC PIPE MH W72 TO W58 AND MH W58 TO W59.

LEGEND

△ REPLACED LATERAL WYE

⊗ REPLACED MANHOLE

PROFILE
SURVEYED
PLOTTED
NOTE BOOK
No.
DATE
BY
GRADES CHECKED
R. M.'s NOTED
STRUCTURE LOCATIONS CHECKED

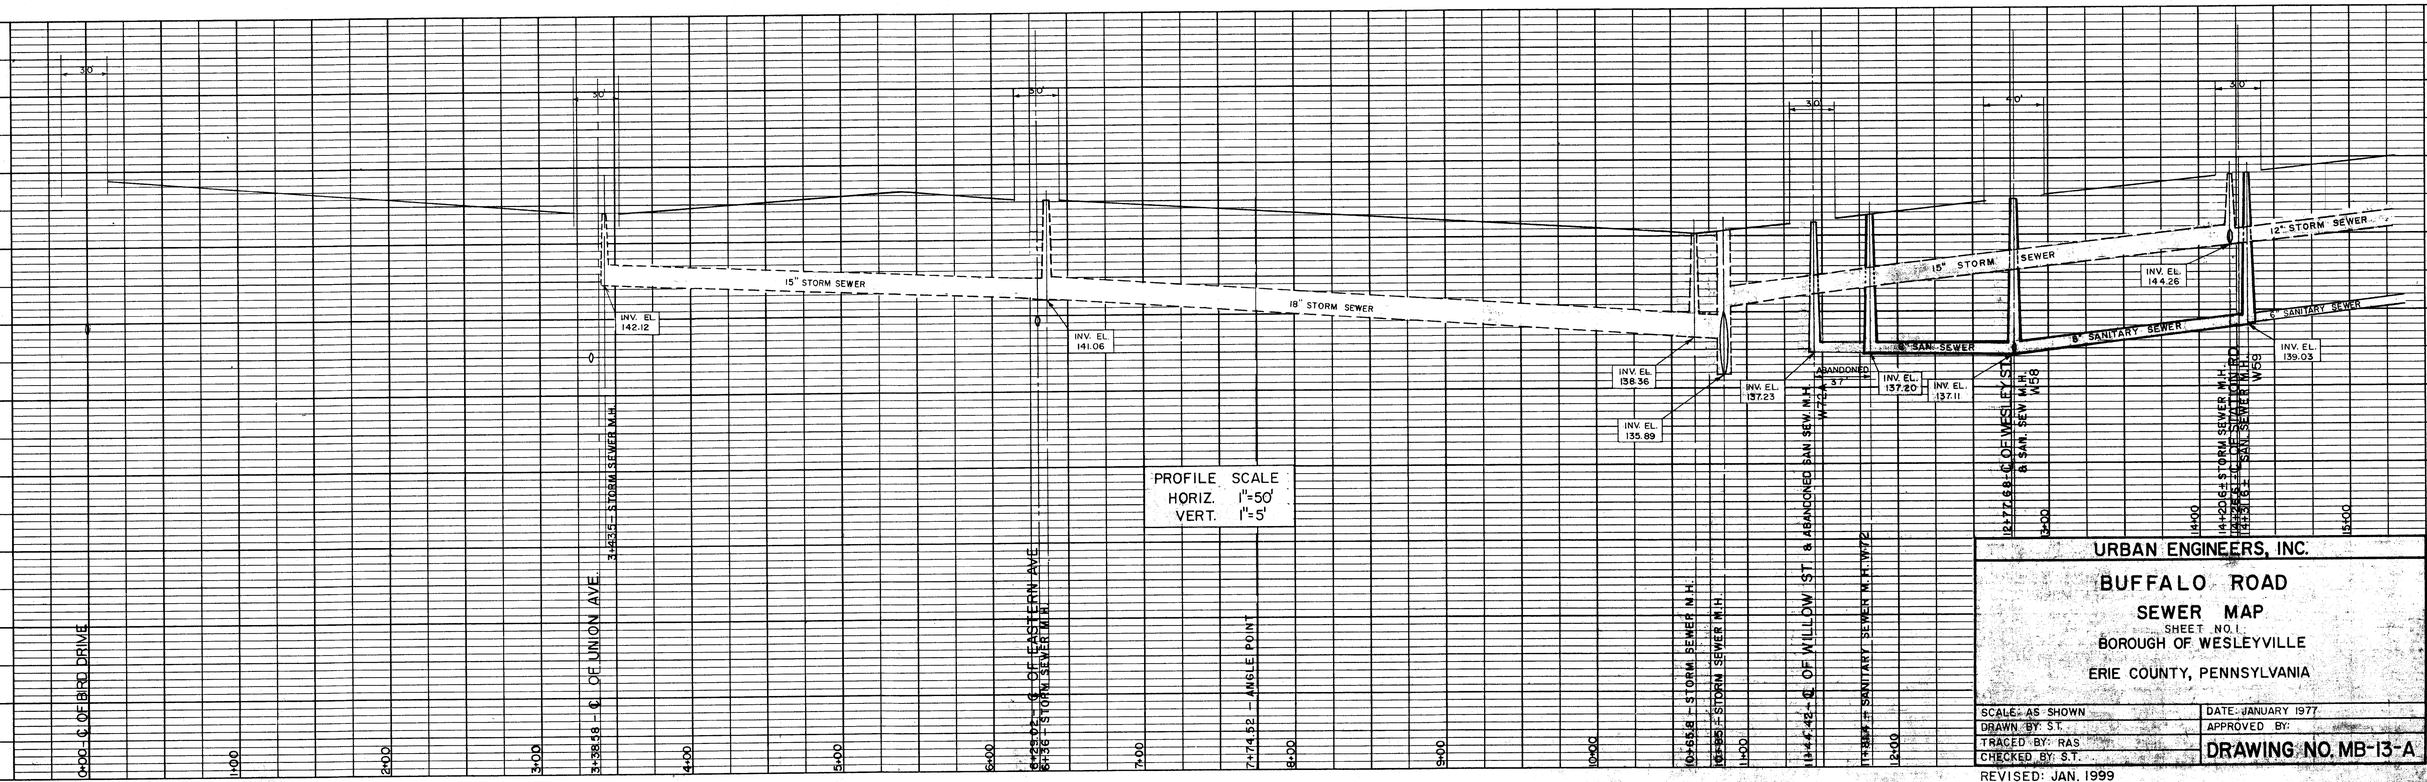

PROFILE SCALE
HORIZ. 1"=50'
VERT. 1"=5'

URBAN ENGINEERS, INC.

BUFFALO ROAD
SEWER MAP
SHEET NO.1
BOROUGH OF WESLEYVILLE
ERIE COUNTY, PENNSYLVANIA


SCALE: AS SHOWN	DATE: JANUARY 1977
DRAWN BY: S.T.	APPROVED BY:
TRACED BY: R.A.S.	DRAWING NO. MB-13-A
CHECKED BY: S.T.	


REVISED: JAN. 1999

PLATE 1 PLAN - PROFILE B P R STANDARD
EUGENE DIETZGEN CO., CHICAGO - NEW YORK

Printed in U. S. A.
On IMPERIAL Tracing Cloth

Printed in U.S.
On IMPERIAL Tracing

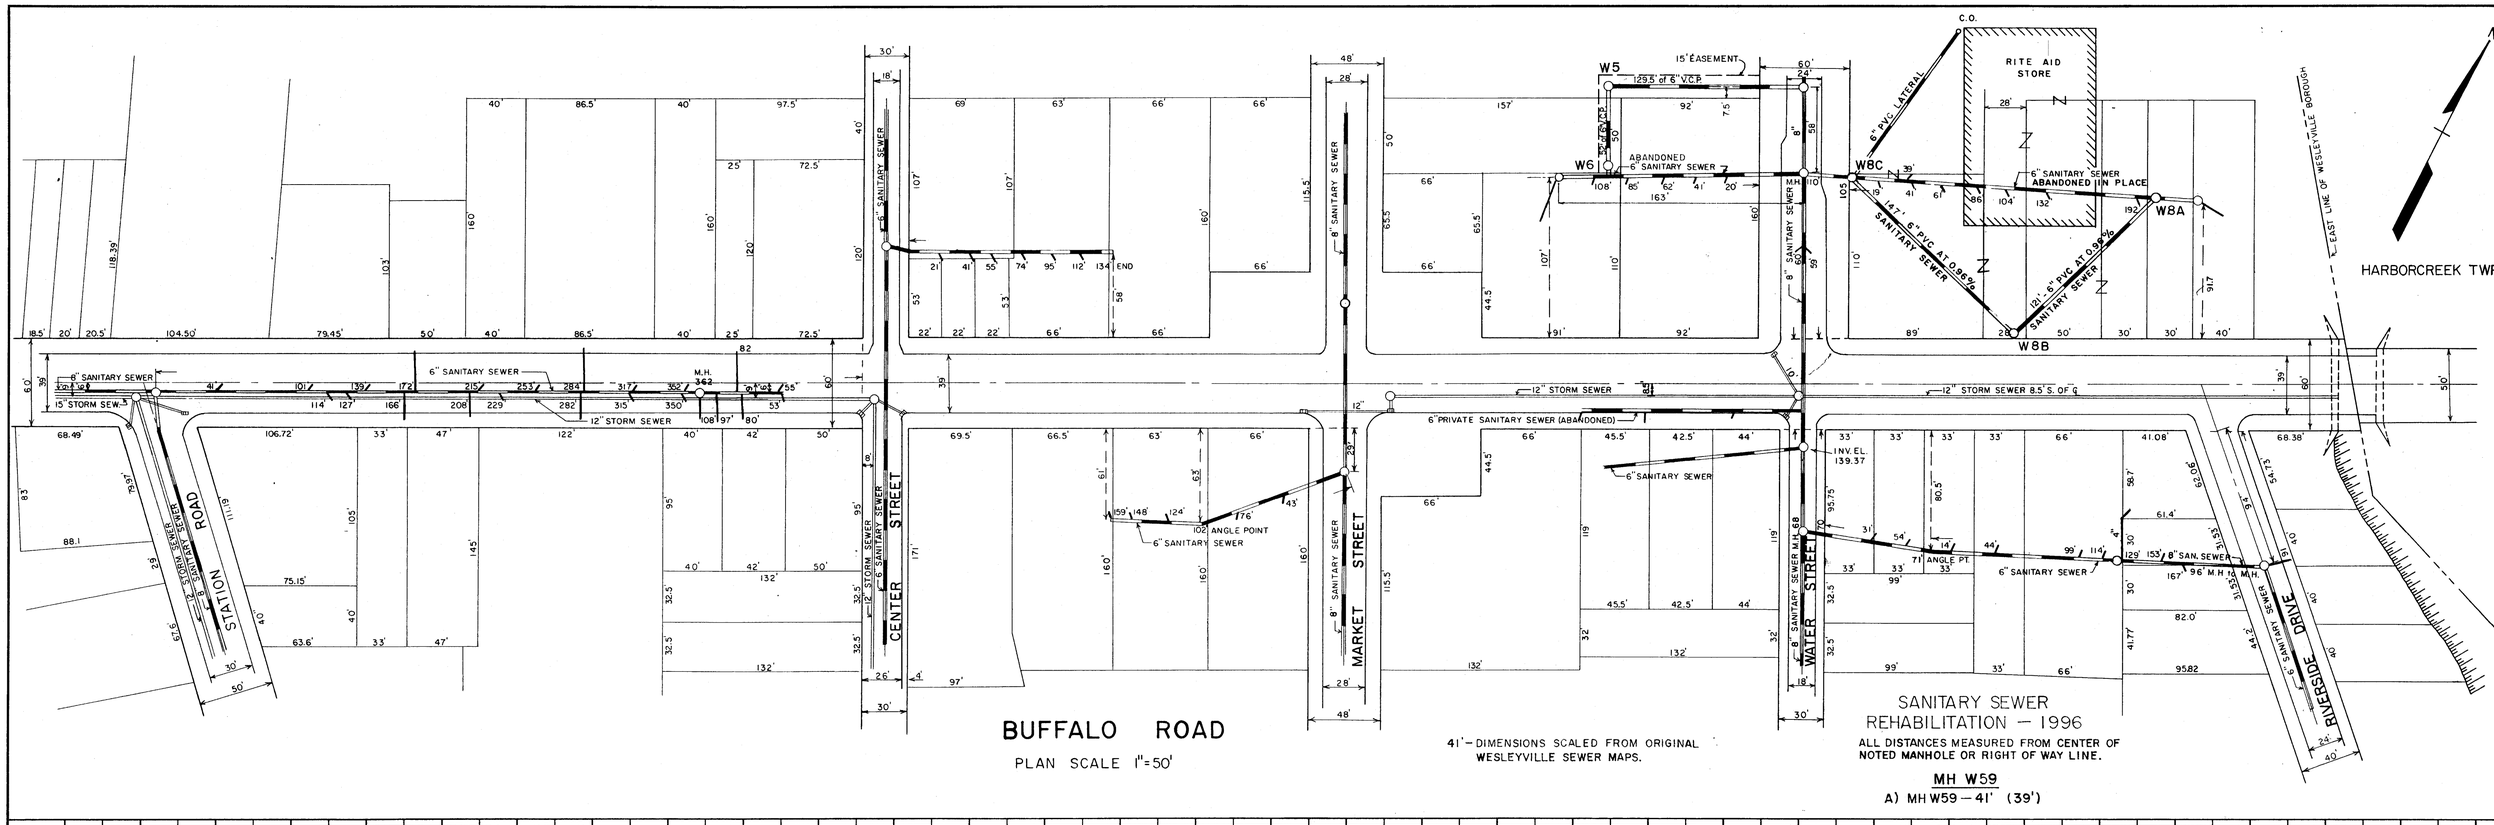

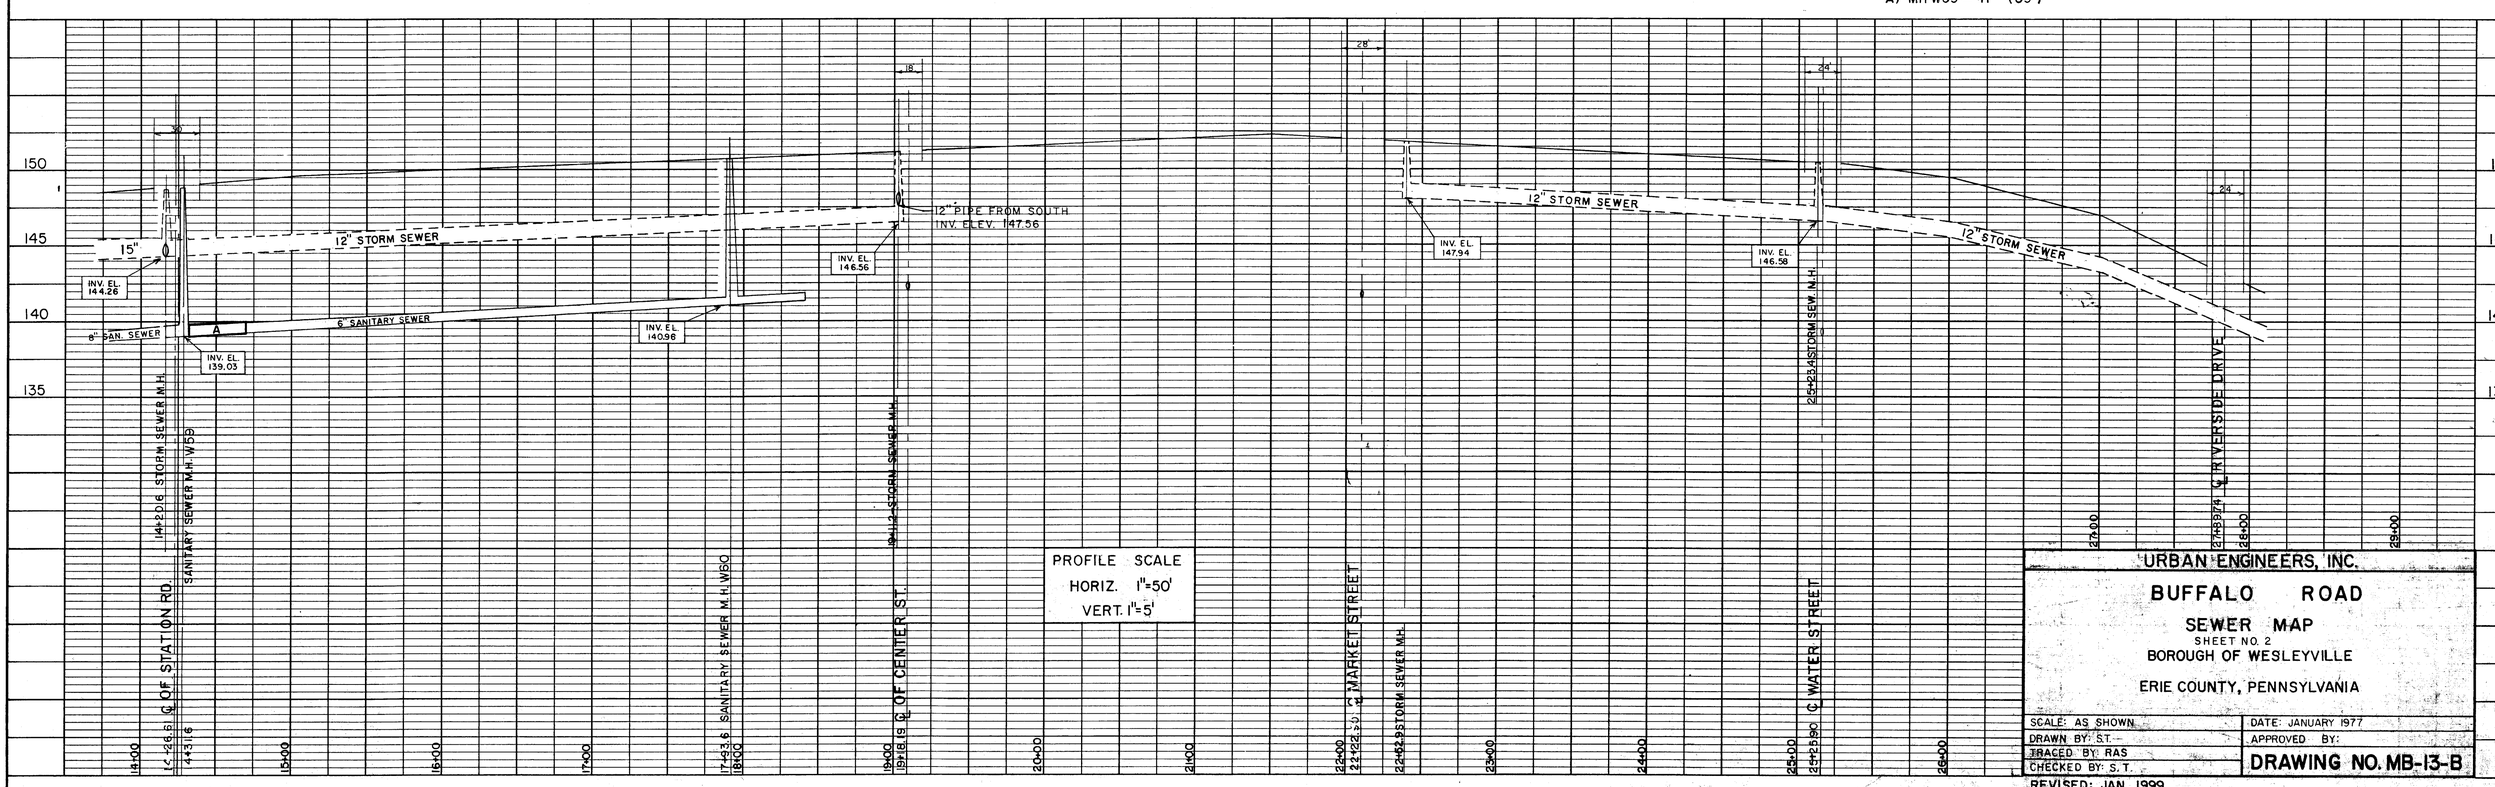

URBAN ENGINEERS, INC.

BUFFALO ROAD

SEWER MAP

SHEET NO. 2

BOROUGH OF WESLEYVILLE

ERIE COUNTY, PENNSYLVANIA

SCALE: AS SHOWN	DATE: JANUARY 1977
DRAWN BY: S.T.	APPROVED BY:
TRACED BY: RAS	DRAWING NO. MB-13-B
CHECKED BY: S.T.	

REVISED: JAN. 1999


PLAN — SURVEYED, PLOTTED, ALIGNMENT CHECKED, M.H. AND INVS. CHECKED — NOTE BOOK — No. — DATE — BY

PROFILE — SURVEYED, PLOTTED, GRADES CHECKED, M.H. NOTED, STRUCTURE NOTATIONS CHECKED — NOTE BOOK — No. — DATE — BY

Printed in U.S.A. On IMPERIAL Tracing Cloth


PLATE 1 PLAN - PROFILE B P R STANDARD
EUGENE DIETZGEN CO., CHICAGO - NEW YORK

Printed in U.S.A. On IMPERIAL Tracing

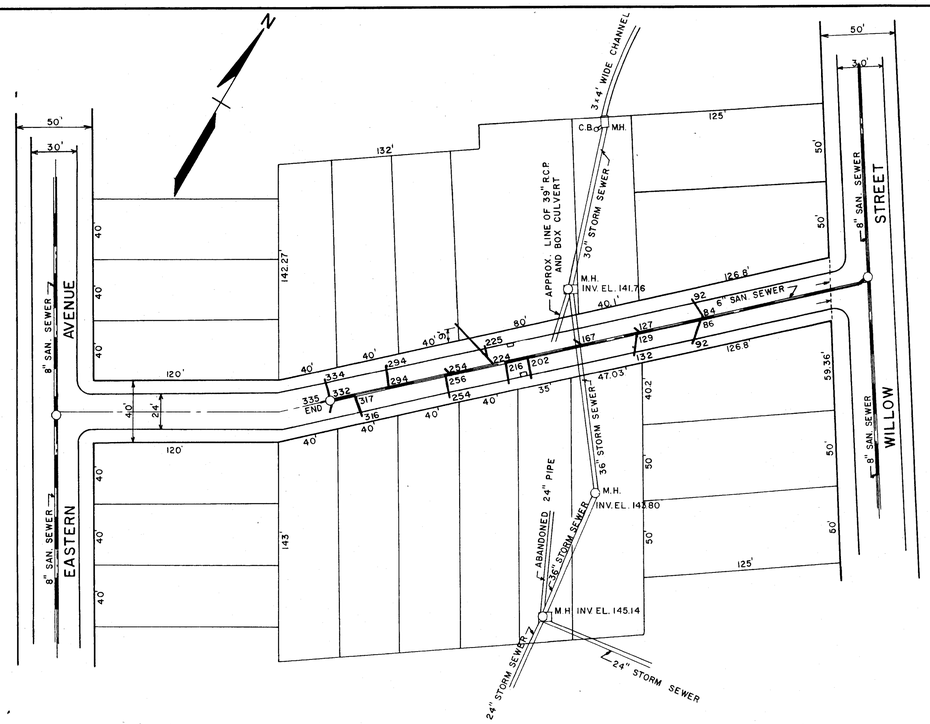


GRAY STREET

PLAN SCALE 1" = 50'

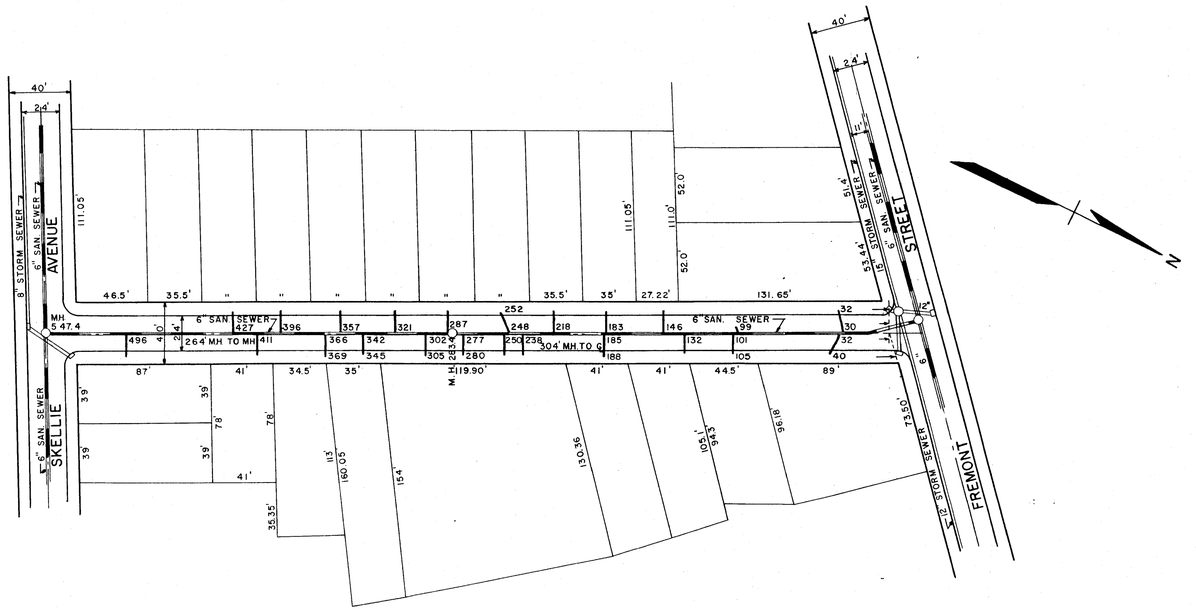

JACKSON PLACE

PLAN SCALE 1" = 50'

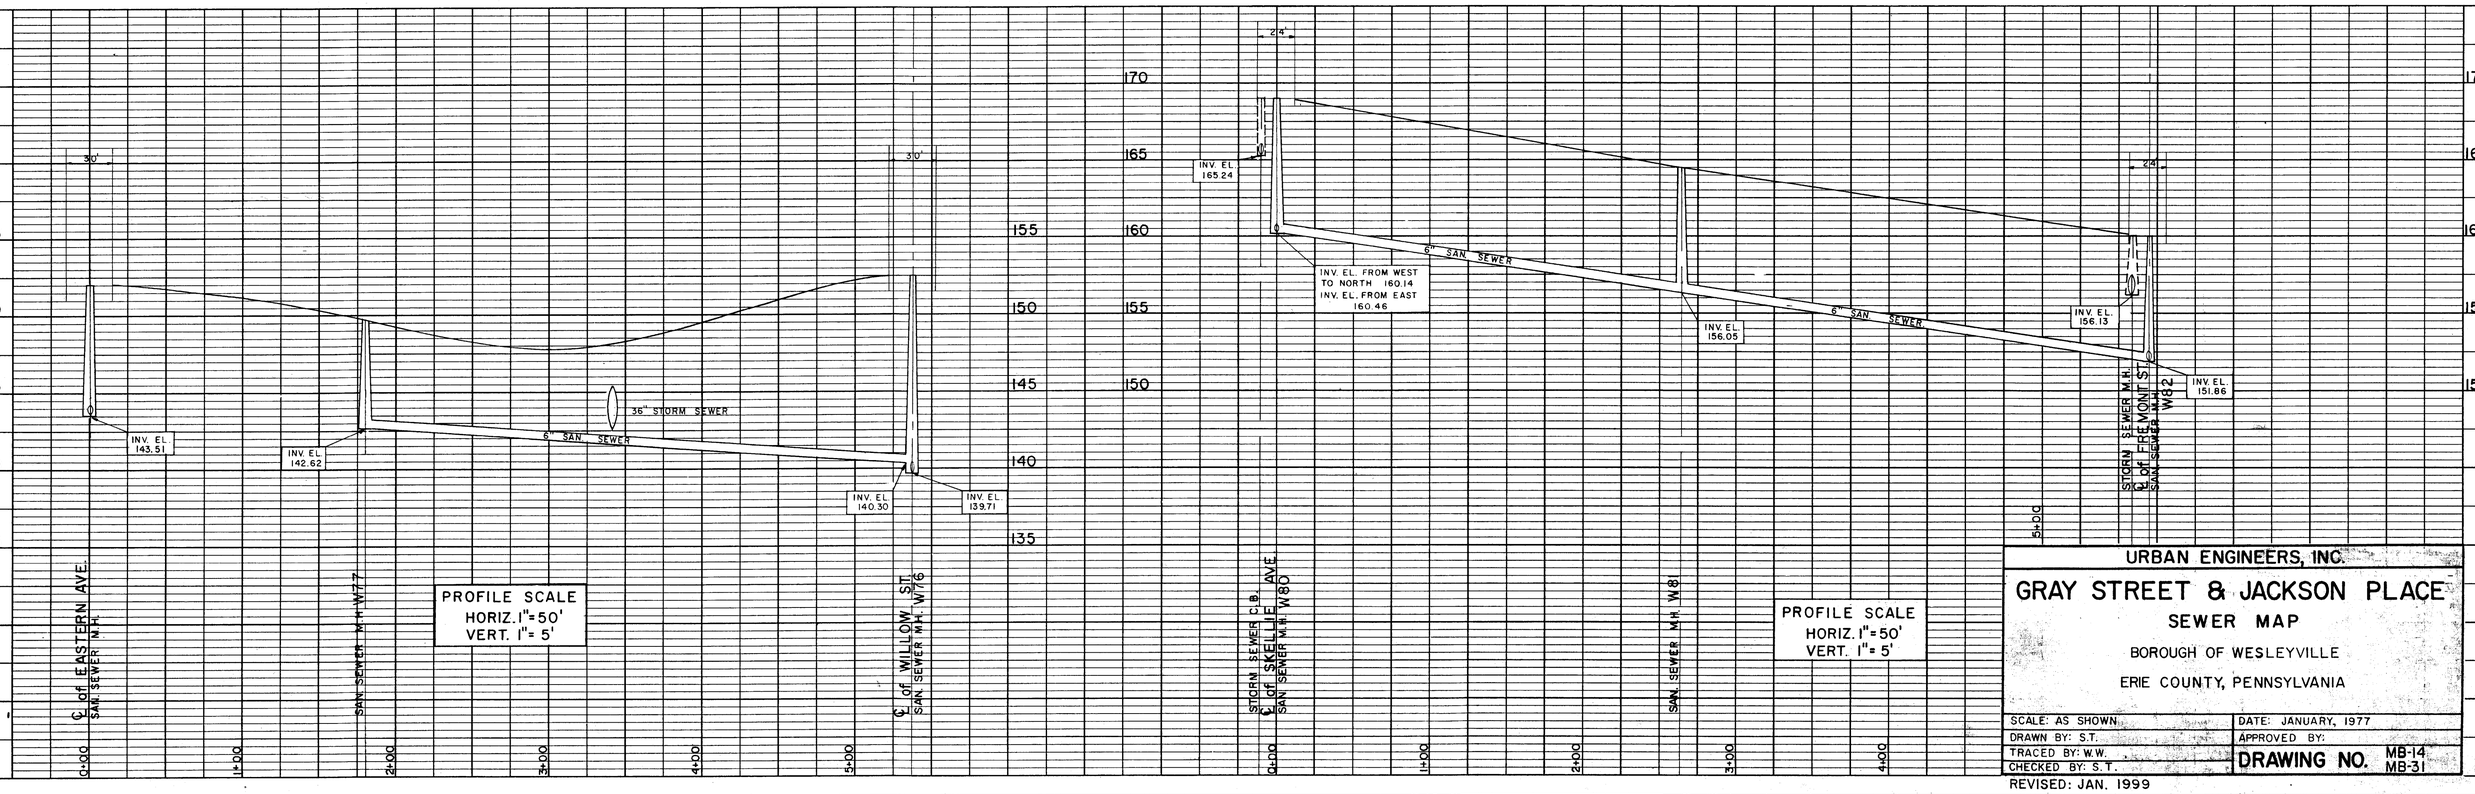

URBAN ENGINEERS, INC.

GRAY STREET & JACKSON PLACE

SEWER MAP

BOROUGH OF WESLEYVILLE

ERIE COUNTY, PENNSYLVANIA

SCALE: AS SHOWN	DATE: JANUARY, 1977
DRAWN BY: S.T.	APPROVED BY:
TRACED BY: W.W.	DRAWING NO. MB-14 MB-31
CHECKED BY: S.T.	


REVISED: JAN. 1999

NOTE BOOK
No.
PLOTTED
GRADES CHECKED
ALIGNMENT CHECKED
STRUCTURE NOTATIONS CHECKED

Printed in U. S. A.
On IMPERIAL Tracing Cloth

PLATE 1 PLAN - PROFILE B P R STANDARD
EUGENE DIETZGEN CO., CHICAGO - NEW YORK


Printed in U
On IMPERIAL Tra



Printed in U.S.A.
On IMPERIAL Tracing Cloth

PLATE 1 PLAN - PROFILE B P R STANDARD
EUGENE DIETZGEN CO., CHICAGO - NEW YORK

Printed in U.S.A.
On IMPERIAL Tracing

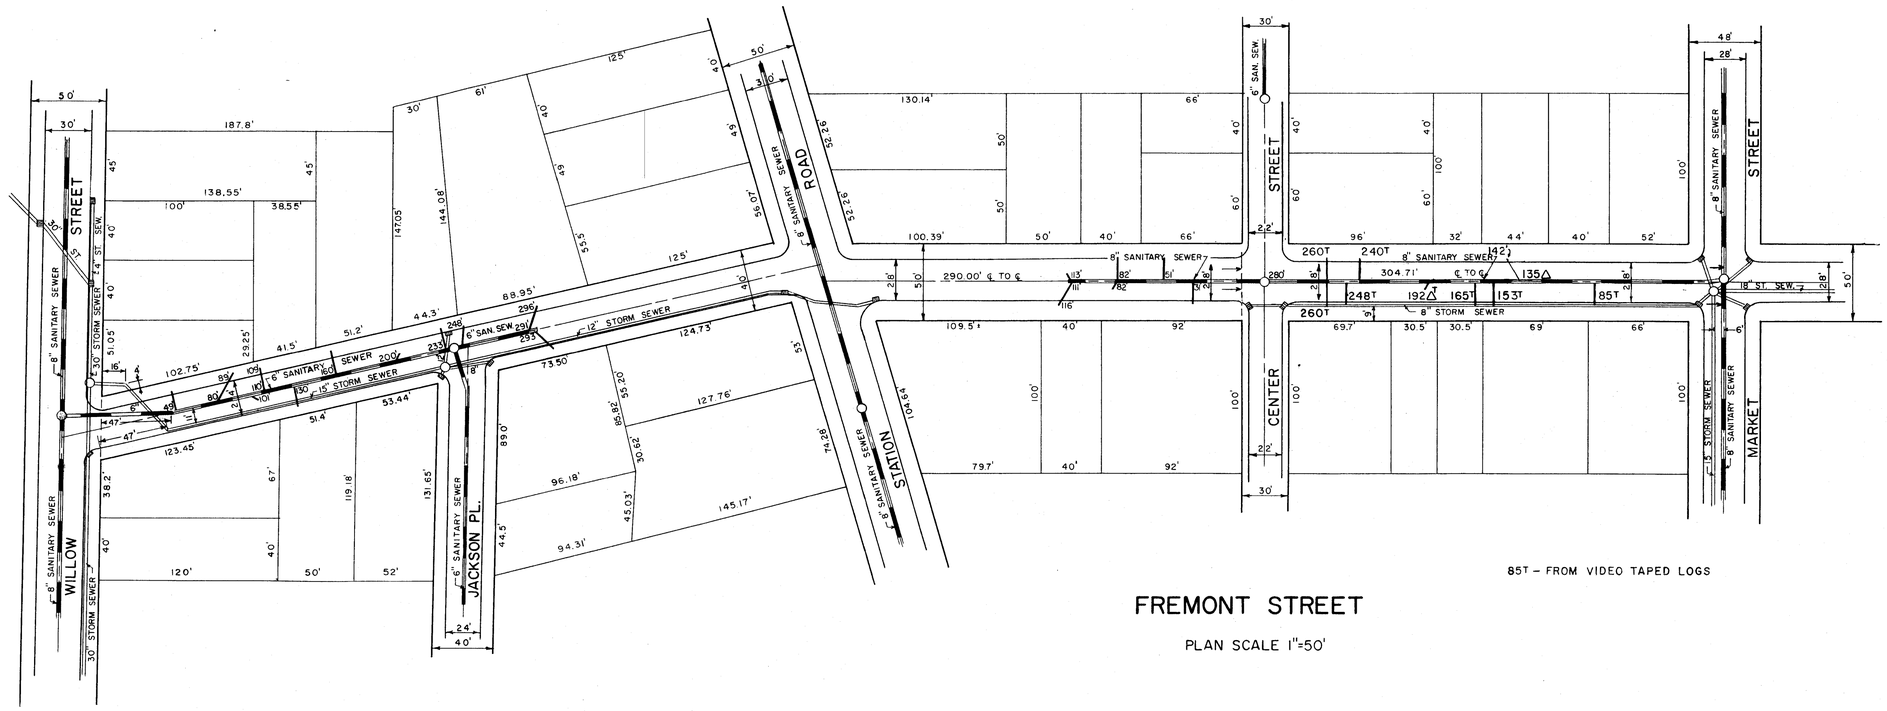

85T – FROM VIDEO TAPED LOGS

FREMONT STREET


PLAN SCALE 1"=50'

SANITARY SEWER REHABILITATION – 1996

ALL DISTANCES MEASURED FROM CENTER OF NOTED MANHOLE OR RIGHT OF WAY LINE.

LEGEND

Δ REPLACE LATERAL WYE

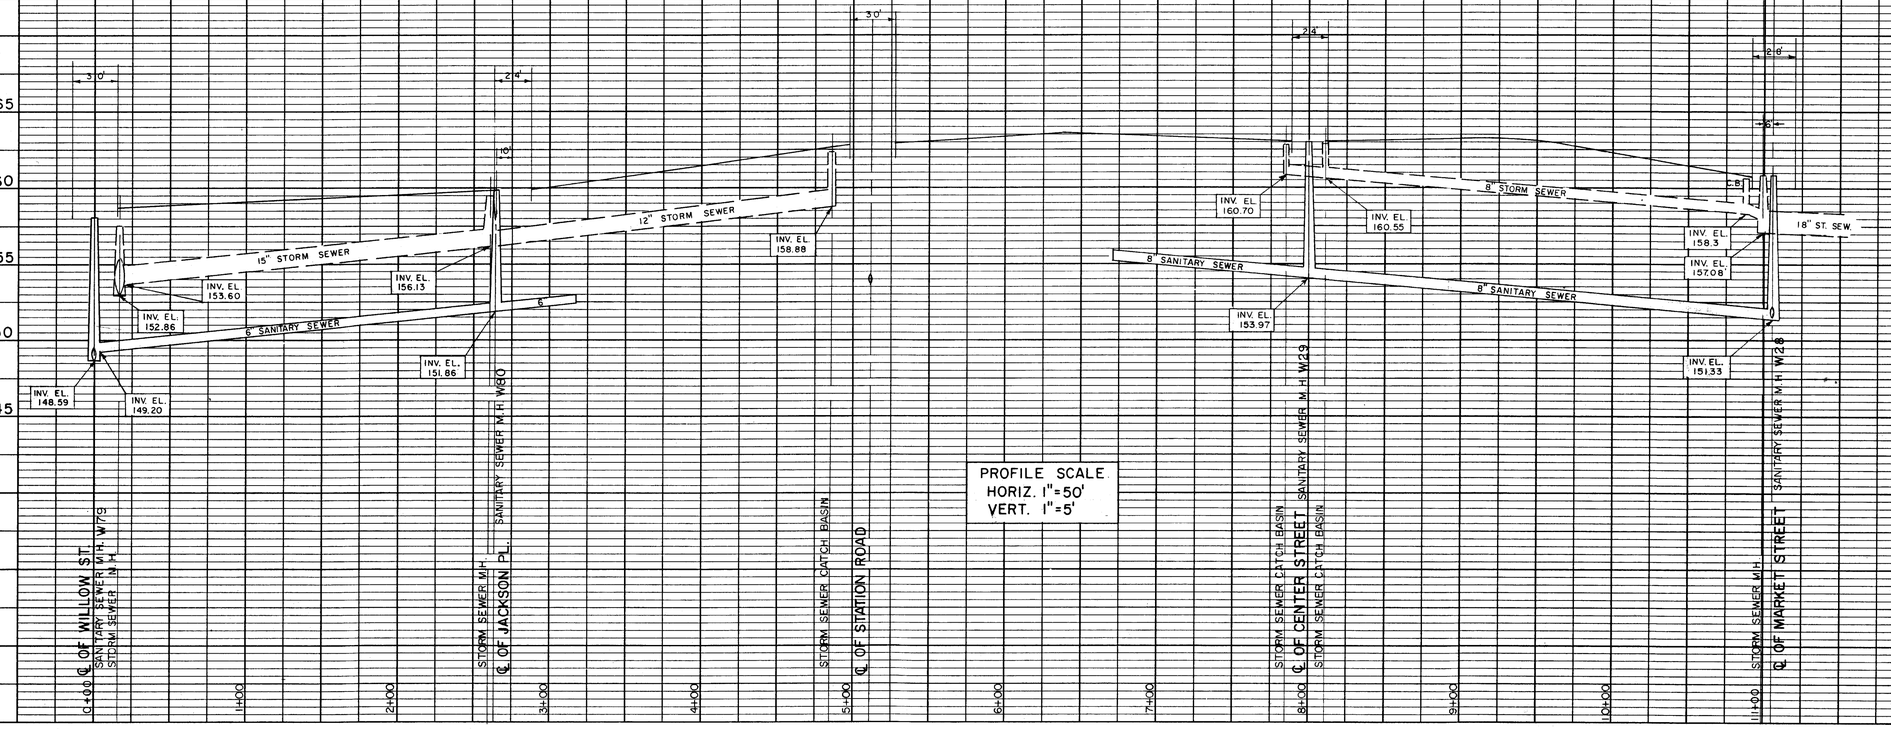

PROFILE SCALE
HORIZ. 1"=50'
VERT. 1"=5'

URBAN ENGINEERS, INC.	
FREMONT STREET SEWER MAP SHEET NO.1 BOROUGH OF WESLEYVILLE ERIE COUNTY, PENNSYLVANIA	
SCALE: AS SHOWN	DATE: FEBRUARY, 1977
DRAWN BY: S.T.	APPROVED BY:
TRACED BY: S.S.	DRAWING NO. MB-16-A
CHECKED BY: S.T.	


REVISED: JAN. 1999

NOTE BOOK No.
PLOTTED
GRADES CHECKED
ALIGNMENT CHECKED
R/W & PROPERTY
STRUCTURE NOTATIONS CHECKED

Printed in U. S. A.
On IMPERIAL Tracing Cloth

PLATE 1 PLAN - PROFILE B P R STANDARD
EUGENE DIETZGEN CO., CHICAGO - NEW YORK

Printed in U.S.A.
On IMPERIAL Tracing Cloth

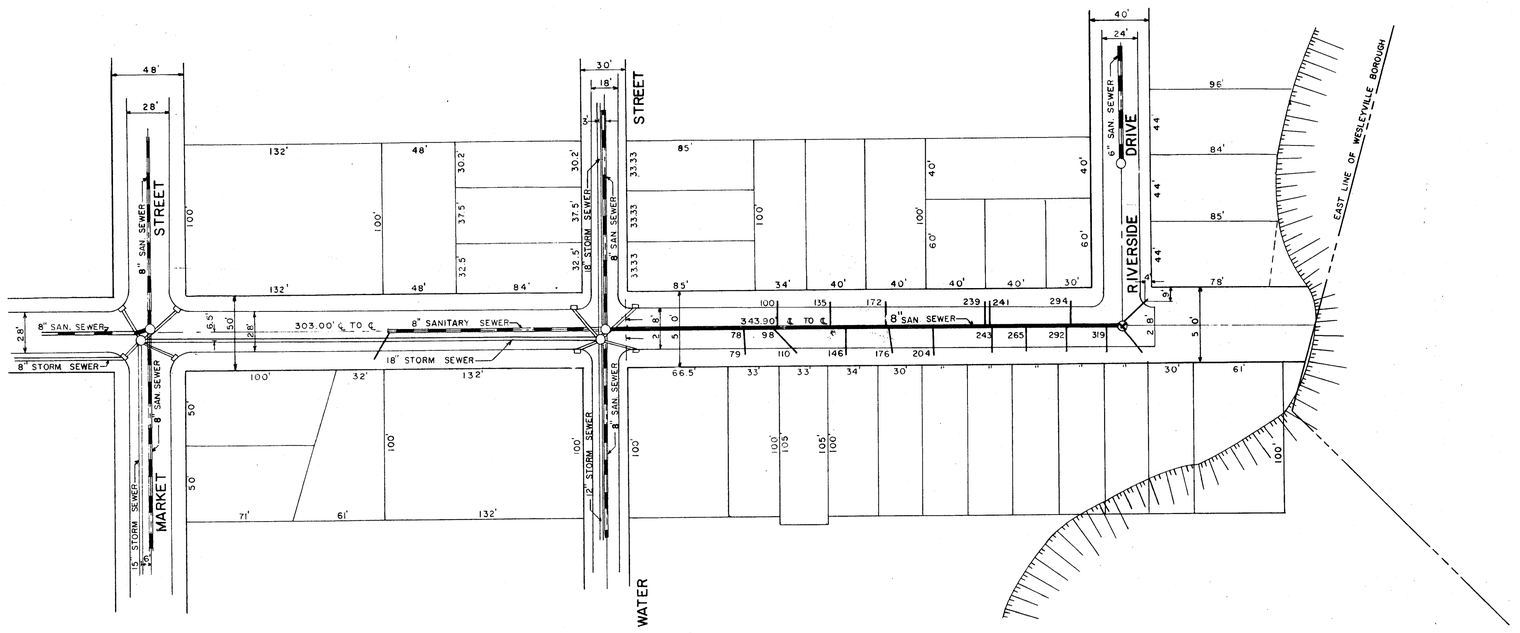

FREMONT STREET


PLAN SCALE 1"=50'

SANITARY SEWER REHABILITATION - 1993

LEGEND

⊙ REPLACED MANHOLE

NOTE: REPLACED EXISTING 6" VCP WITH 8" PVC PIPE FROM M.H. W-18 TO M.H. W-19

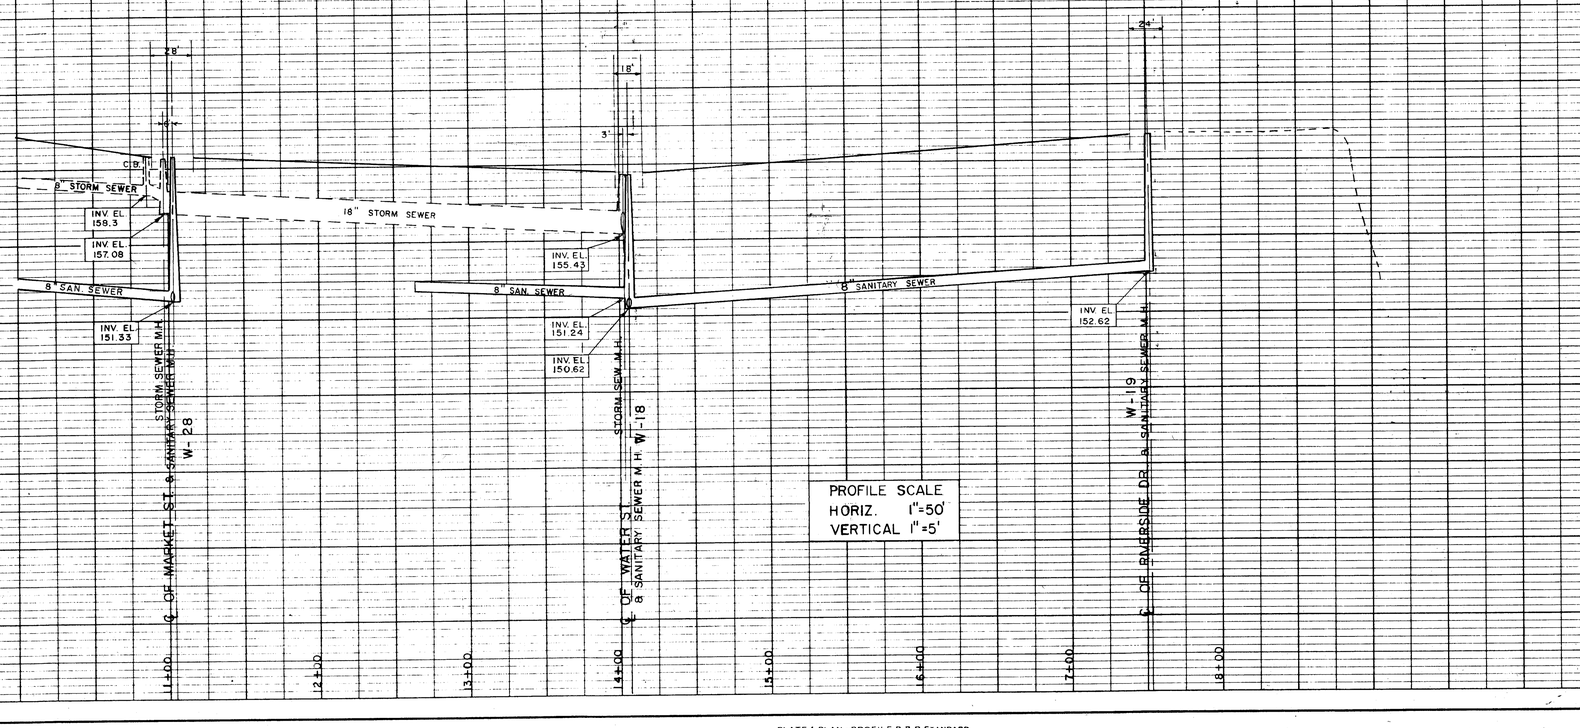

PROFILE SCALE
HORIZ. 1"=50'
VERTICAL 1"=5'

URBAN ENGINEERS, INC.

FREMONT STREET
SEWER MAP
SHEET NO.2

BOROUGH OF WESLEYVILLE

ERIE COUNTY, PENNSYLVANIA

SCALE: AS SHOWN	DATE: FEBRUARY 1977
DRAWN BY: S.T.	APPROVED BY:
TRACED BY: J.J.D.	DRAWING NO. MB-16B
CHECKED BY: S.T.	


REVISED JAN. 1999

PLAN: SURVEYED, PLOTTED, NOTE BOOK, No., ALIGNMENT CHECKED, AS BUILT, RT. OF WAY CHECKED, BY, DATE

PROFILE: SURVEYED, PLOTTED, CHECKED, NOTE BOOK, No., DRAWN, NOTED, STRUCTURE NOTATIONS CHECKED, BY, DATE

PLATE 1 PLAN - PROFILE B P R STANDARD
EUGENE DIETZGEN CO. CHICAGO-NEW YORK

Printed in U.S.A.
On IMPERIAL Tracing Cloth

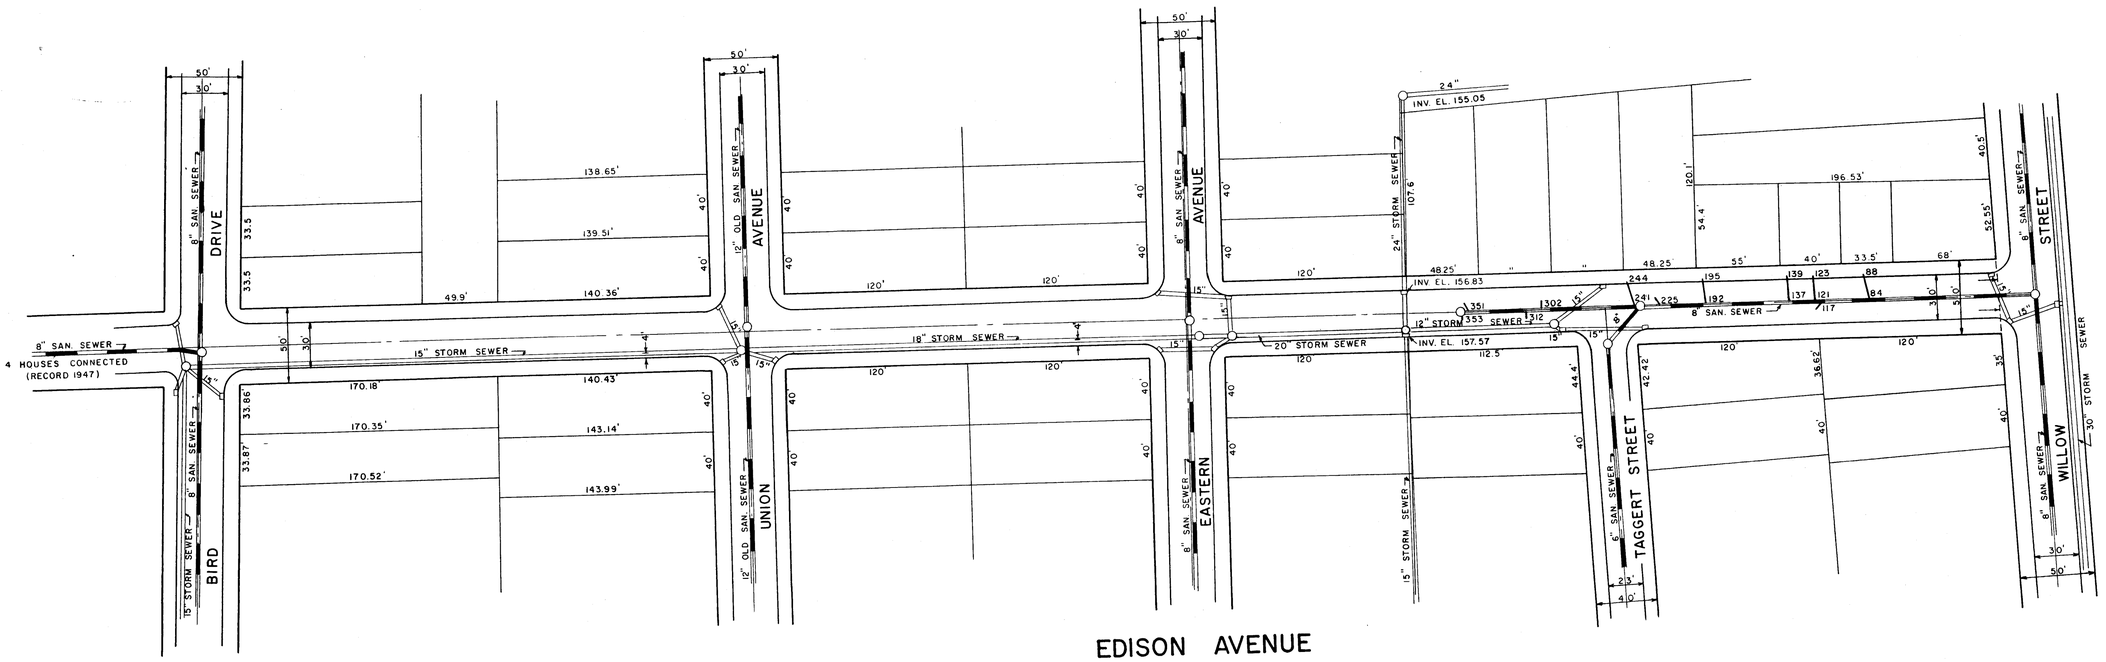

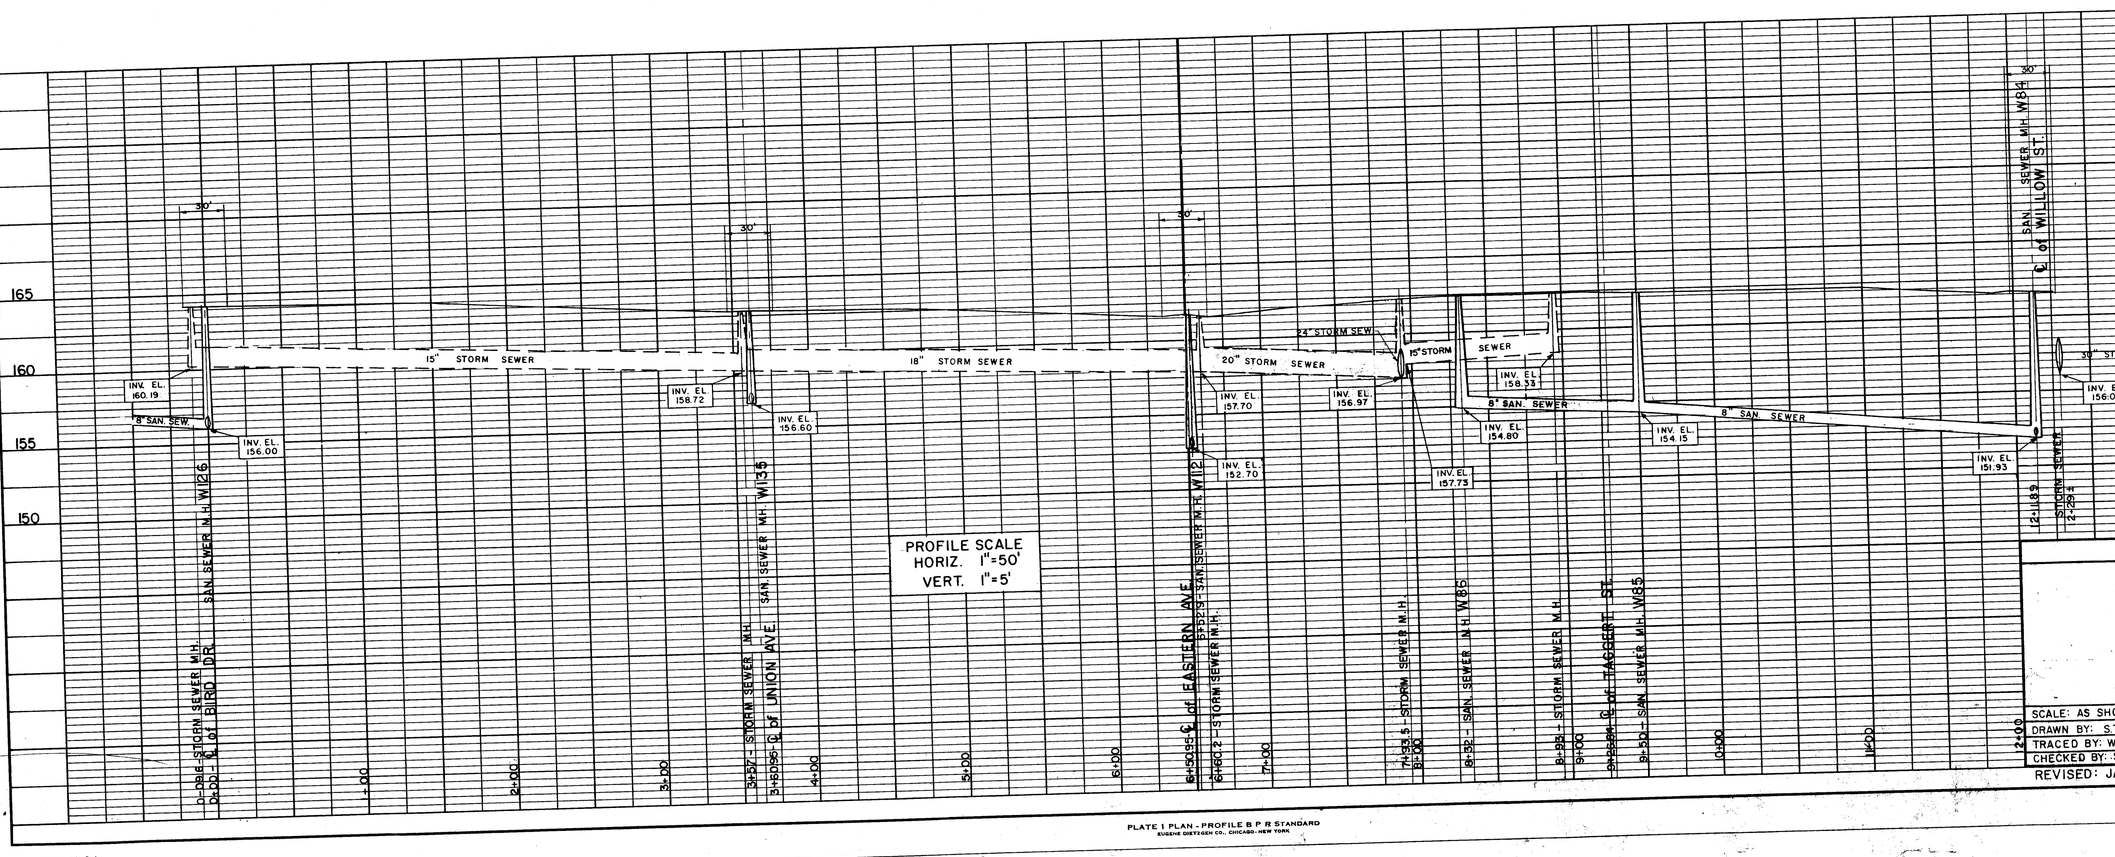


PLATE 1 PLAN - PROFILE B P R STANDARD
EUGENE DIETZGEN CO., CHICAGO - NEW YORK

URBAN ENGINEERS, INC.

EDISON AVENUE

SEWER MAP

SHEET NO. 1

BOROUGH OF WESLEYVILLE

ERIE COUNTY, PENNSYLVANIA

SCALE: AS SHOWN	DATE: FEBRUARY, 1977
DRAWN BY: S.T.	APPROVED BY:
TRACED BY: W.W.	DRAWING NO. MB-1
CHECKED BY: S.T.	


REVISED: JAN. 1999

PLAN — SURVEYED, PLOTTED, DRAWN, CHECKED, ALIGNMENT CHECKED, RT. OF WAY CHECKED, NOTE BOOK, No.

PROFILE — SURVEYED, PLOTTED, DRAWN, CHECKED, H. & V. NOTED, STRUCTURE NOTATIONS CHECKED, NOTE BOOK, No.

DATE, BY

Printed in U. S. A.
On IMPERIAL Tracing Cloth

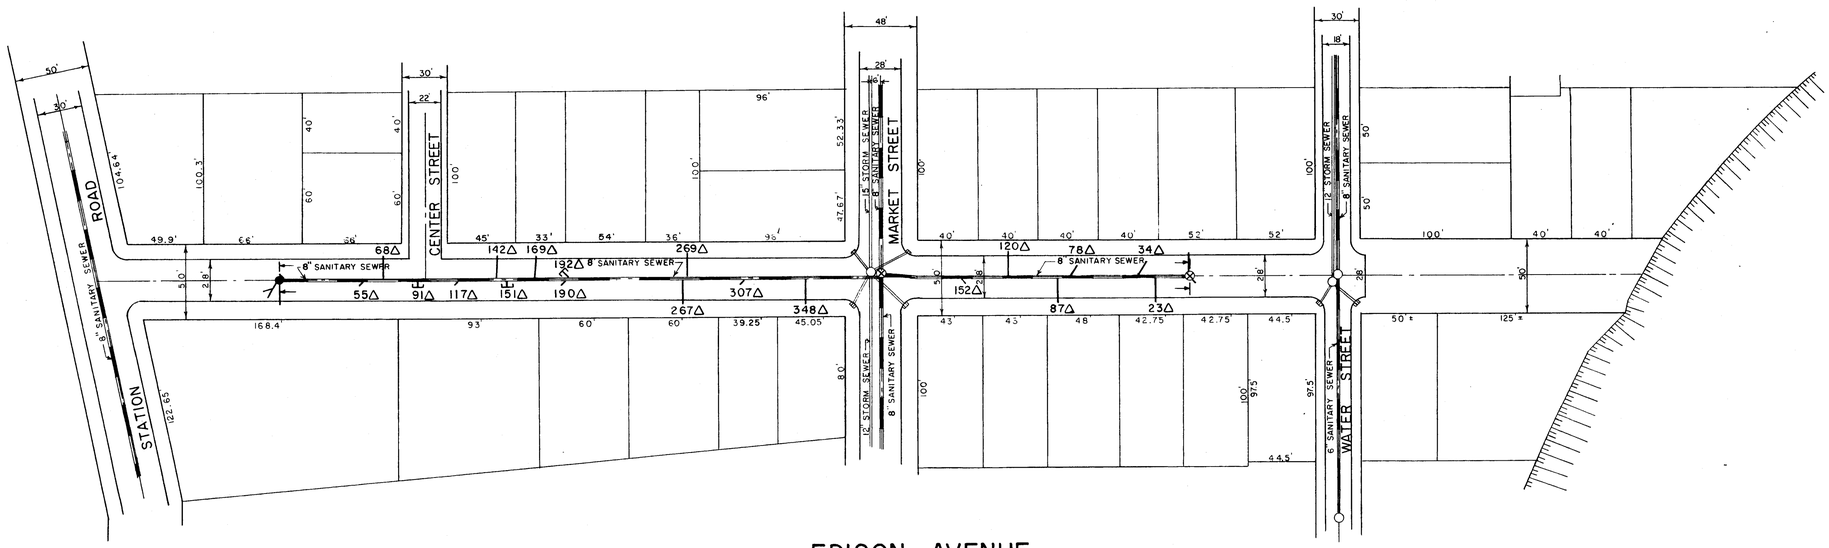

EDISON AVENUE

PLAN SCALE 1"= 50'

SANITARY SEWER
REHABILITATION — 1997


ALL DISTANCES MEASURED FROM
CENTER OF NOTED MANHOLE

LEGEND

- Δ REPLACED LATERAL WYE
- ⊗ REPLACED MANHOLE
- ● NEW MANHOLE
- T LATERAL CAPPED AT WYE

NOTE : REPLACED EXISTING 6" VCP WITH 8" PVC PIPE FROM MH W31 TO MH W30 AND MH W30 TO MH W32.

PLAN
SURVEYED
PLOTTED
NOTE BOOK
No.
ALIGNMENT CHECKED
RT. OF WAY CHECKED
DATE
BY

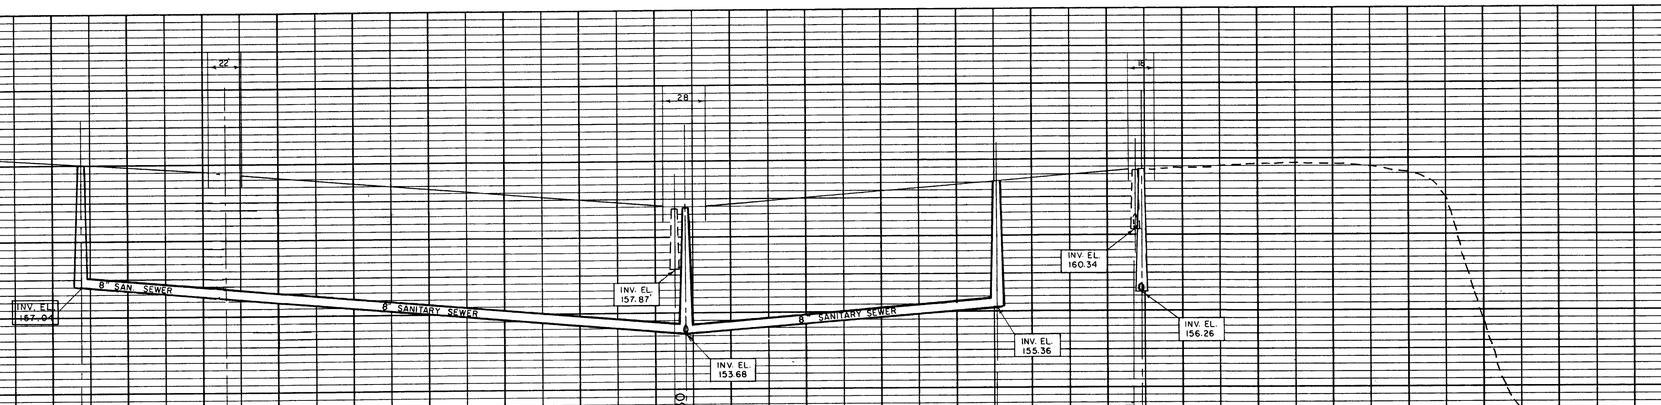

PROFILE SCALE
HORIZ. 1"=50'
VERT. 1"=5'

0+00 - ℄ OF STATION ROAD
1+00
1+19 ± SANITARY SEWER MH W32
2+00
2+15.45 ℄ OF CENTER STREET
3+00
4+00
5+00
5+20.16 - ℄ OF MARKET STREET - SANITARY SEWER M.H. W30
5+44 - STORM SEWER M.H.
6+00
7+00
7+25 - SANITARY SEWER M.H. W31
8+00
8+23.16 - ℄ OF WATER STREET - SANITARY SEWER M.H. W21
8+20.5 - STORM SEWER M.H.

PROFILE
SURVEYED
PLOTTED
NOTE BOOK
No.
DRAWN CHECKED
R. W.'s NOTED
STRUCTURE NOTATIONS CHECKED
DATE
BY

URBAN ENGINEERS, INC.

EDISON AVENUE

SEWER MAP

SHEET NO. 2

BOROUGH OF WESLEYVILLE

ERIE COUNTY, PENNSYLVANIA

SCALE: AS SHOWN	DATE: FEBRUARY 1977
DRAWN BY: S.T.	APPROVED BY:
TRACED BY: J.F.	DRAWING NO. MB-17-B
CHECKED BY: S.T.	


REVISED: JAN. 1999

Printed in U. S. A.
On IMPERIAL Tracing Cloth


PLATE I PLAN - PROFILE B P R STANDARD
EUGENE DIETZGEN CO., CHICAGO - NEW YORK

Printed in U.S.A.
On IMPERIAL Tracing Cloth

PLAN
SURVEYED
PLOTTED
NOTE BOOK
ALIGNMENT CHECKED
R.T. OF WAY CHECKED
No.
DATE
BY

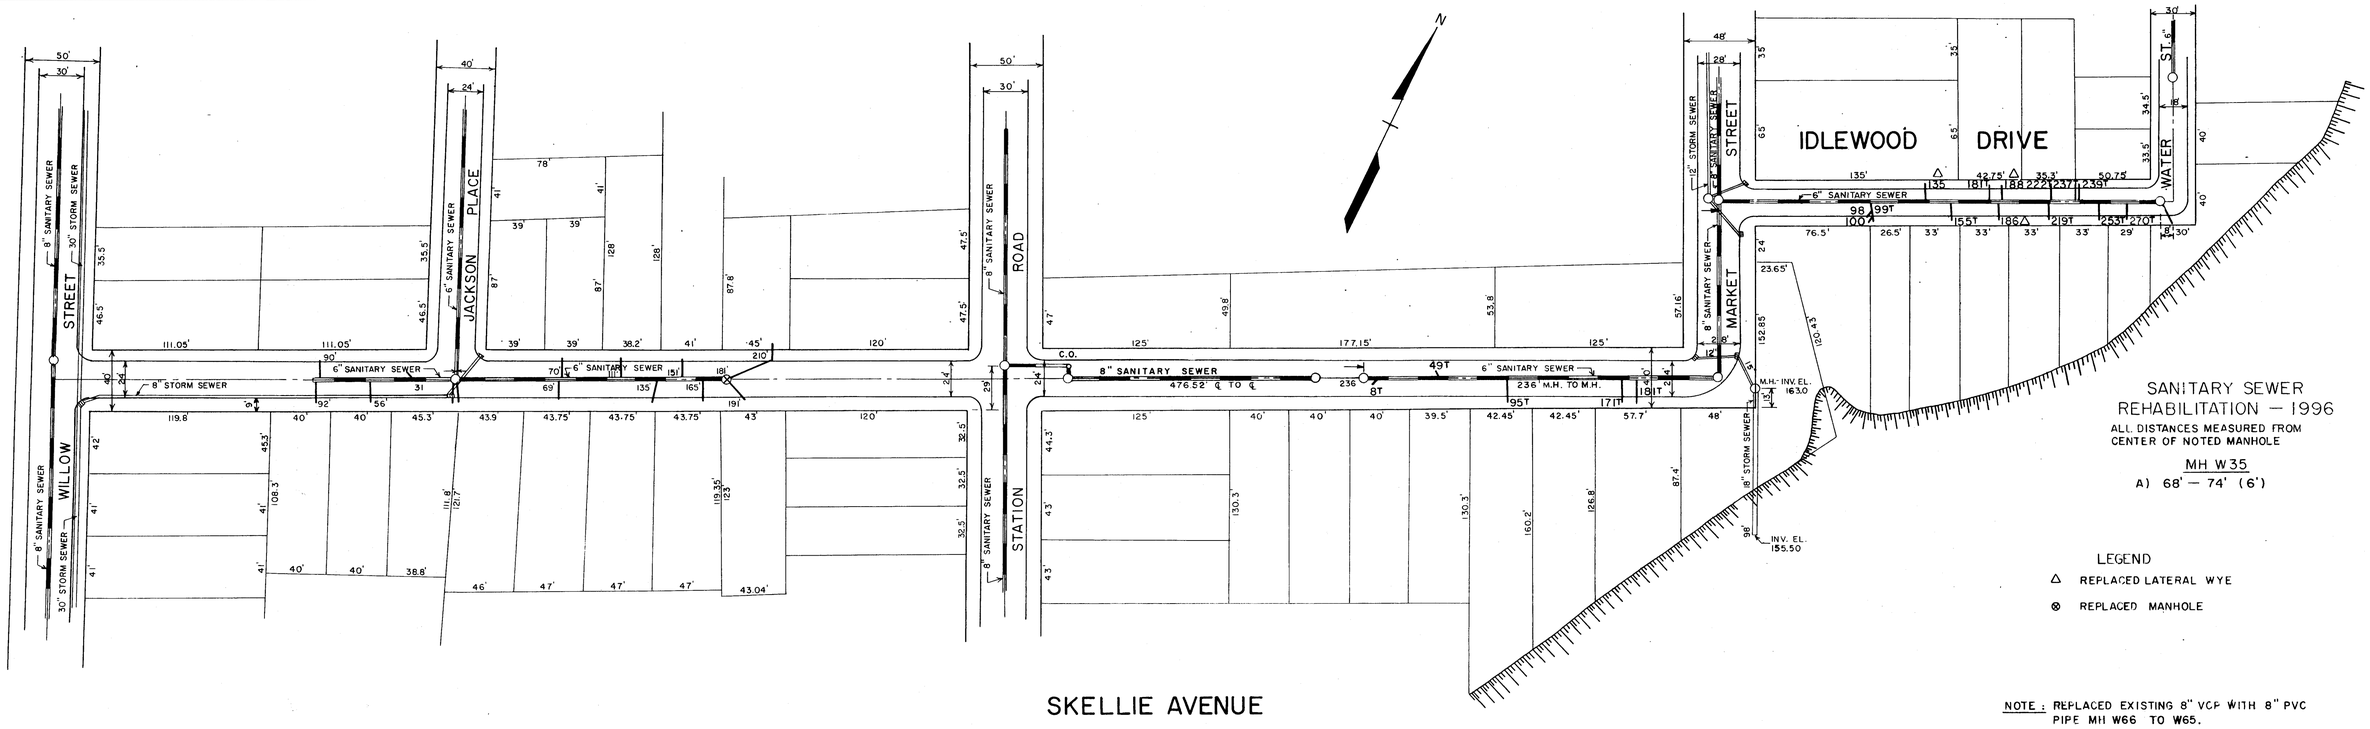

PROFILE
SURVEYED
PLOTTED
GRADES CHECKED
R.T. OF WAY CHECKED
No.
DATE
BY

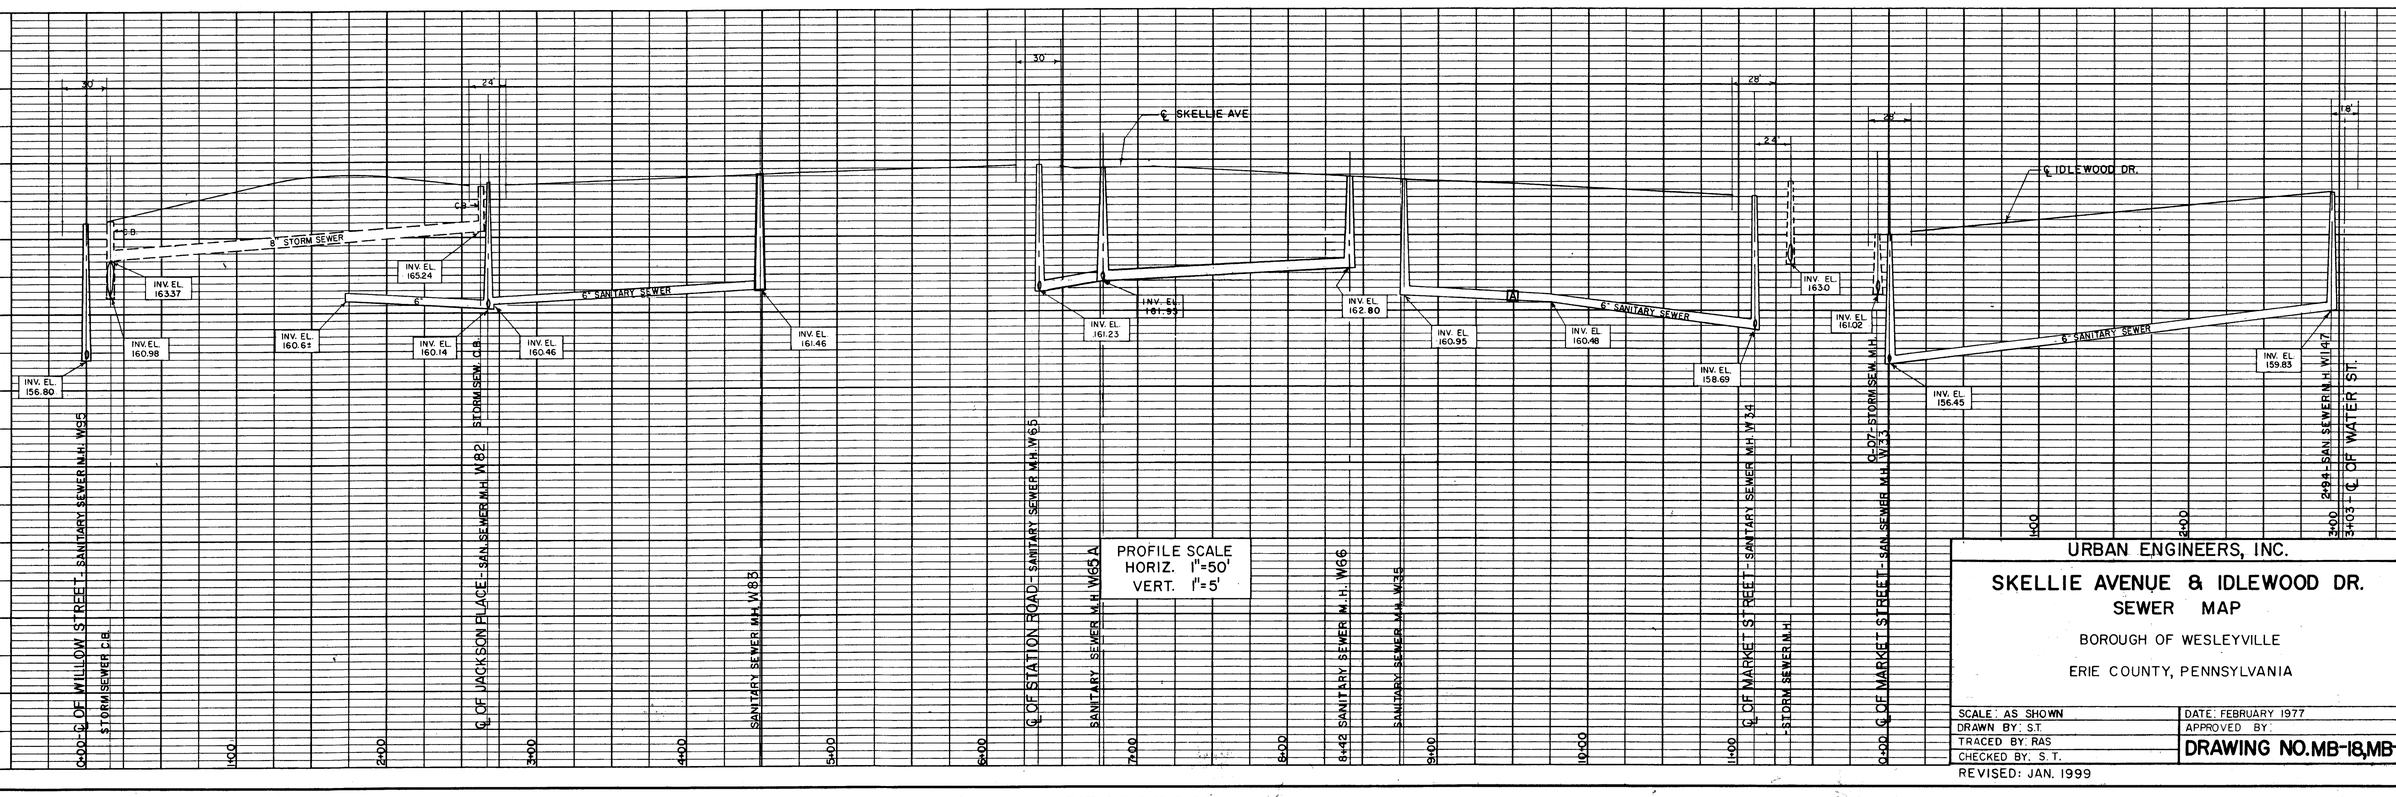

URBAN ENGINEERS, INC.

SKELLIE AVENUE & IDLEWOOD DR.
SEWER MAP

BOROUGH OF WESLEYVILLE

ERIE COUNTY, PENNSYLVANIA


SCALE: AS SHOWN	DATE: FEBRUARY 1977
DRAWN BY: S.T.	APPROVED BY:
TRACED BY: RAS	DRAWING NO. MB-18, MB-19
CHECKED BY: S.T.	

REVISED: JAN. 1999

Printed in U. S. A.
On IMPERIAL Tracing Cloth

PLATE 1 PLAN - PROFILE B P R STANDARD
EUGENE DIETZGEN CO., CHICAGO: NEW YORK

Printed in U.S.A.
On IMPERIAL Tracing C

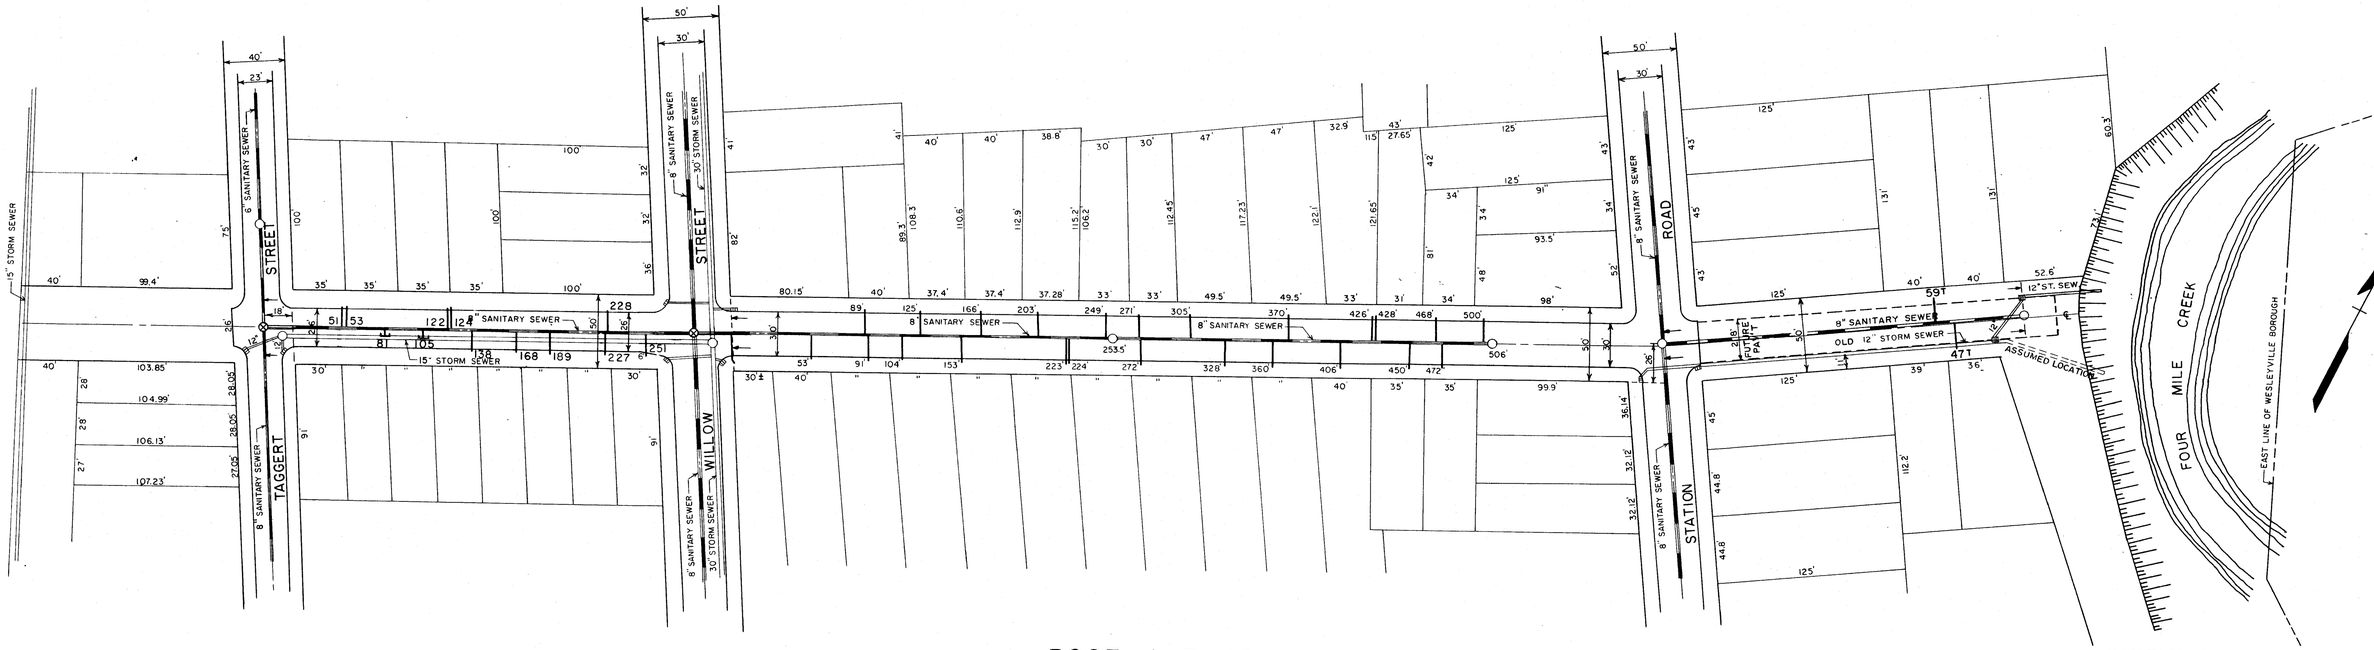

ROSE AVENUE

PLAN SCALE 1"=50'

47T FROM VIDEO TAPE LOGS

LEGEND

- T — LATERAL CAPPED AT WYE
- ⊗ — MANHOLE REPLACED

SANITARY SEWER REHABILITATION – 1997


ALL DISTANCES MEASURED FROM CENTER OF NOTED MANHOLE OR RIGHT OF WAY LINE

MH W67

A) MH W67 TO 26' (24')

B) 185' – 191' (6')

C) MH W96 TO 17' (15')

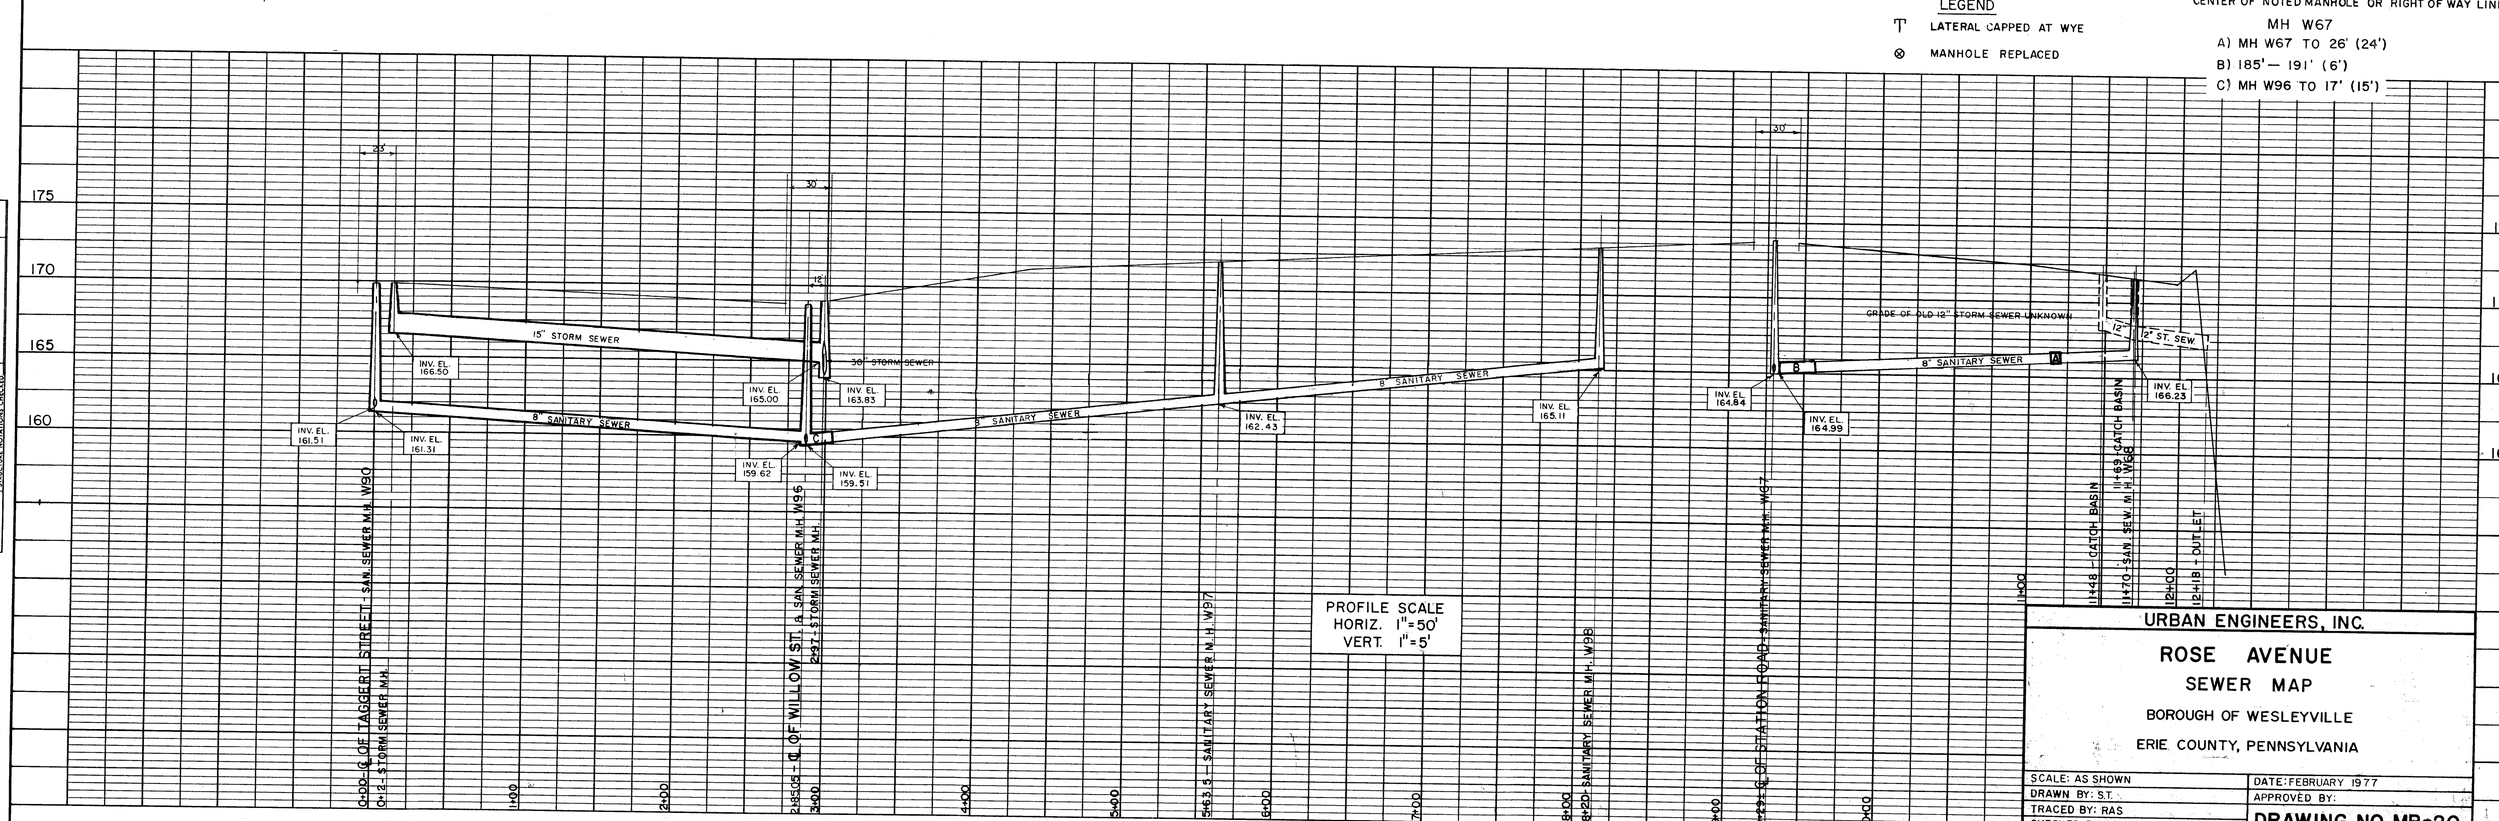

PROFILE SCALE
HORIZ. 1"=50'
VERT. 1"=5'

URBAN ENGINEERS, INC.

ROSE AVENUE
SEWER MAP

BOROUGH OF WESLEYVILLE

ERIE COUNTY, PENNSYLVANIA

SCALE: AS SHOWN	DATE: FEBRUARY 1977
DRAWN BY: S.T.	APPROVED BY:
TRACED BY: RAS	DRAWING NO. MB-20
CHECKED BY: S.T.	

REVISED: JAN. 1999

PLAN — SURVEYED, PLOTTED, NOTE BOOK, No., ALIGNMENT CHECKED, RT. OF WAY CHECKED, BY, DATE


PROFILE — SURVEYED, PLOTTED, GRADES CHECKED, S. M.'s NOTED, STRUCTURE NOTATIONS CHECKED, BY, DATE

Printed in U. S. A.
On IMPERIAL Tracing Cloth

PLATE 1 PLAN - PROFILE B P R STANDARD
EUGENE DIETZGEN CO., CHICAGO - NEW YORK

Printed in U.S.A.
On IMPERIAL Tracing Cloth


PLAN
SURVEYED
PLOTTED
NOTE BOOK
No.
DATE
BY
ALIGNMENT CHECKED
R/ OF WAY CHECKED

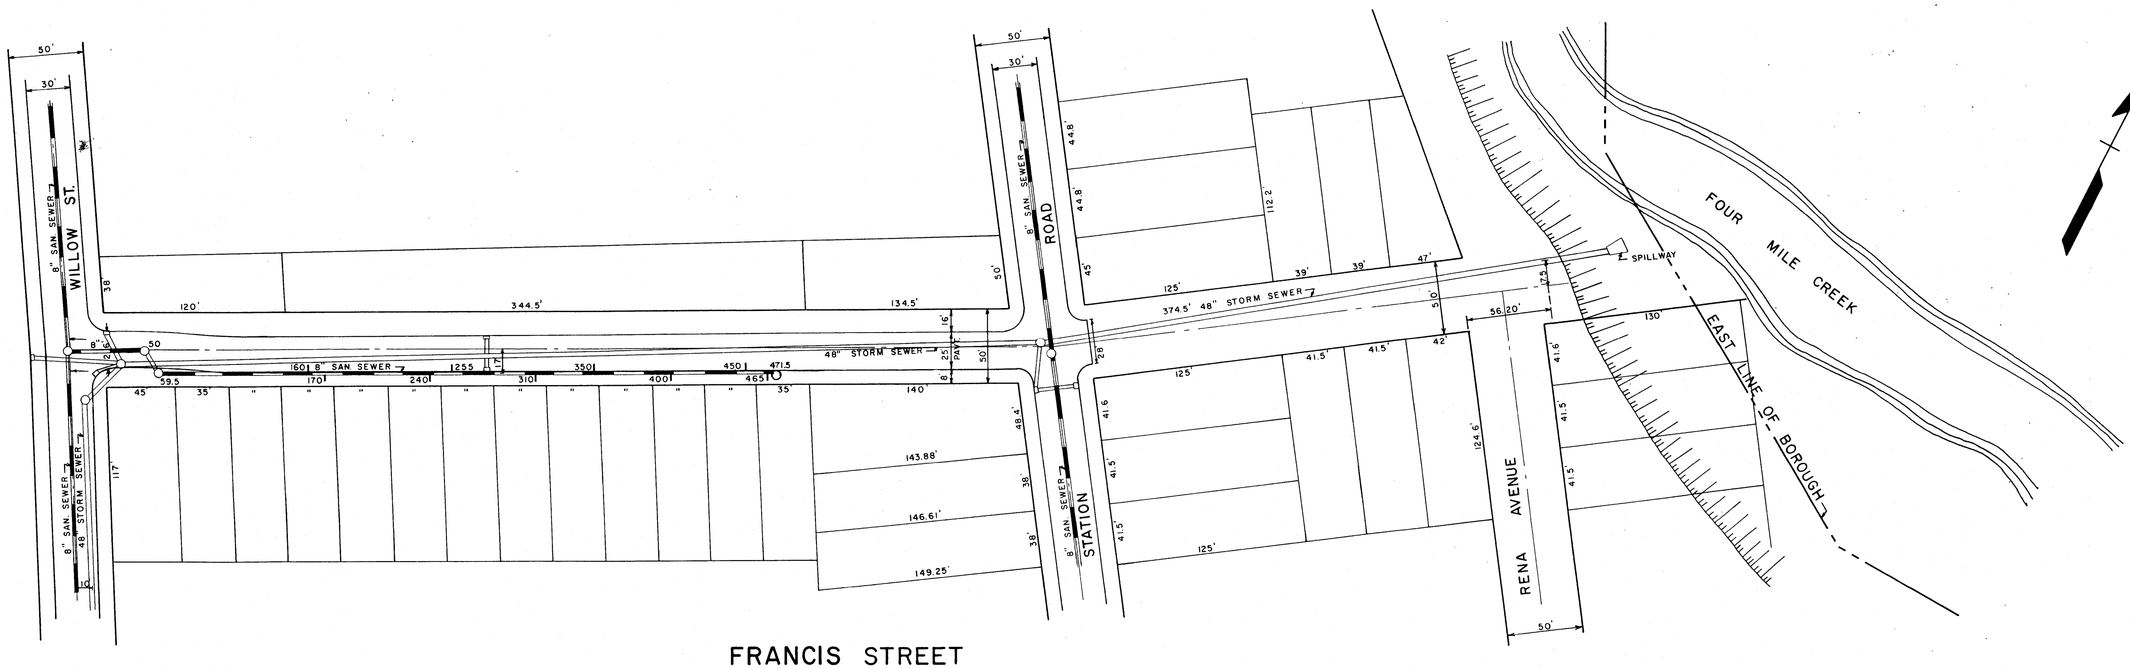

FRANCIS STREET

PLAN SCALE 1" = 50'

PROFILE
SURVEYED
PLOTTED
NOTE BOOK
No.
DATE
BY
CURVE CHECKED
R. R.'s NOTED
STRUCTURE NOTATIONS CHECKED

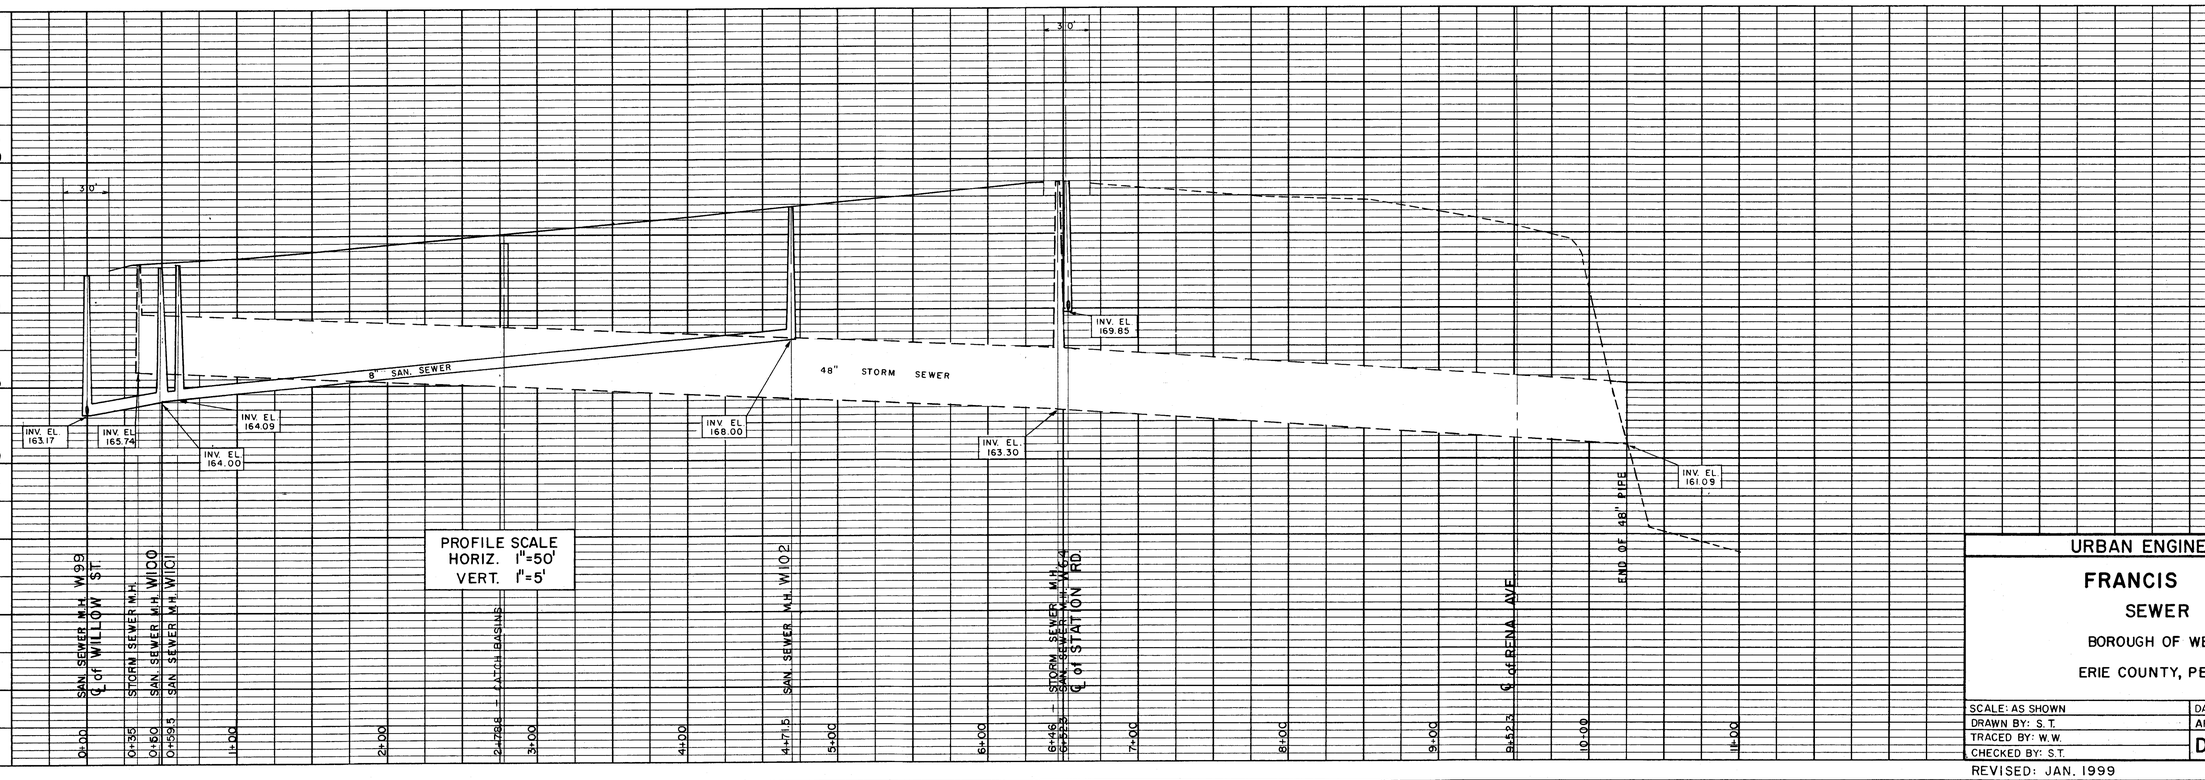

PROFILE SCALE
HORIZ. 1"=50'
VERT. 1"=5'

URBAN ENGINEERS, INC.

FRANCIS STREET
SEWER MAP
BOROUGH OF WESLEYVILLE
ERIE COUNTY, PENNSYLVANIA

SCALE: AS SHOWN	DATE: FEBRUARY, 1977
DRAWN BY: S. T.	APPROVED BY:
TRACED BY: W. W.	DRAWING NO. MB-21
CHECKED BY: S. T.	

REVISED: JAN. 1999

Printed in U. S. A.
On IMPERIAL Tracing Cloth

PLATE 1 PLAN - PROFILE B P R STANDARD
EUGENE DIETZGEN CO., CHICAGO, NEW YORK

Printed in U.S.A.
On IMPERIAL Tracing

PLAN
NOTE BOOK
No.
SURVEYED
PLOTTED
ALIGNMENT CHECKED
RT. OF WAY CHECKED
BY
DATE

PROFILE
NOTE BOOK
No.
SURVEYED
PLOTTED
GRADES CHECKED
B. M.'s NOTED
STRUCTURE NOTATIONS CHECKED

CITY OF ERIE
BOROUGH OF WESLEYVILLE

M.H. NOT FOUND

BIRD DRIVE

8" SANITARY SEWER

12" STORM SEWER

6" SANITARY SEWER

4" SAN. SEWER

UNION AVENUE

6" SANITARY SEWER

EASTERN AVENUE

8" SANITARY SEWER

15" STORM SEWER (ABANDONED)

12" STORM SEWER

6" SANITARY SEWER

15" STORM SEWER

24" R.C.P. STORM SEWER

TAGGERT STREET

6" SANITARY SEWER

FLUSH SPILL UNDER PAV'T

6" SANITARY SEWER

6" SANITARY SEWER

208.5 FLUSH SPILL

WILLOW STREET

8" SANITARY SEWER

15" STORM SEWER 10' E. OF ℄

8" SAN. SEW. 1' N. FROM ℄

18" STORM SEWER 4' S. FROM ℄

36" STORM SEWER 18' S. FROM ℄

4" TILE FROM SEPTIC TANK

12" STORM SEWER

INV. EL. 177.38

OPEN DITCH

INV. EL. 179.72

OPEN DITCH

12" STORM SEWER

15" STORM SEWER

GROVELAND AVENUE (NOT OPEN)

WOODLAWN AVENUE

PLAN SCALE 1"=50'

N

PROFILE SCALE
HORIZ. 1"=50'
VERT. 1"=5'

℄ OF BIRD DRIVE SANITARY SEWER M.H.

STORM SEWER M.H.

SANITARY SEWER M.H. W140

℄ OF UNION AVENUE SANITARY SEWER M.H. W139

STORM SEWER M.H.

℄ OF EASTERN AVENUE SANITARY SEWER M.H. W110

STORM SEWER M.H.

STORM SEWER M.H.
FLUSH SPILL W94

℄ OF TAGGERT STREET SANITARY SEWER M.H. W92

FLUSH SPILL W93

STORM SEWER M.H.

℄ OF WILLOW STREET

STORM SEWER M.H.

STORM SEWER M.H.

SAN. SEW. M.H. W103

INV. EL. 182.79
INV. EL. 179.31
INV. EL. 175.54
INV. EL. 172.99
INV. EL. 177.10
INV. EL. 172.52
INV. EL. 174.03
INV. EL. 170.19
INV. EL. 173.01
INV. EL. 168.57
INV. EL. 171.92
INV. EL. 171.85
INV. EL. 173.3±
INV. EL. 171.0±
INV. EL. 167.62
INV. EL. 169.07

6" SANITARY SEWER
12" STORM SEWER
15" STORM SEWER
24" STORM SEWER
18" STORM SEWER
36" STORM SEWER
8" SANITARY SEWER

190 185 180 175 170 165 160

0+00 1+00 2+00 3+00 3+40.28 4+00 5+00 6+00 6+80.00 7+00 8+00 9+00 10+00 11+00 12+00 13+00

URBAN ENGINEERS, INC.

WOODLAWN AVENUE
SEWER MAP
SHEET NO. I
BOROUGH OF WESLEYVILLE
ERIE COUNTY, PENNSYLVANIA


SCALE: AS SHOWN	DATE: FEBRUARY, 1977
DRAWN BY: S.T.	APPROVED BY:
TRACED BY: S.S.	
CHECKED BY: S.T.	DRAWING NO. MB-22-A

REVISED: JAN. 1999

HIGHWAY FEDERAL AID SHEET
PLATE 1-SINGLE PLAN AND PROFILE-FULL LINE
TELEDYNE
PRINTED IN U.S.A.

PLAN
SURVEYED
PLOTTED
ALIGNMENT CHECKED
NOTE BOOK
R.O.W. ADDED
No.
ST. OF WAY CHECKED
DATE
BY

PROFILE
SURVEYED
PLOTTED
ALIGNMENT CHECKED
NOTE BOOK
R.O.W. ADDED
No.
STRUCTURE NOTATIONS CHECKED
DATE

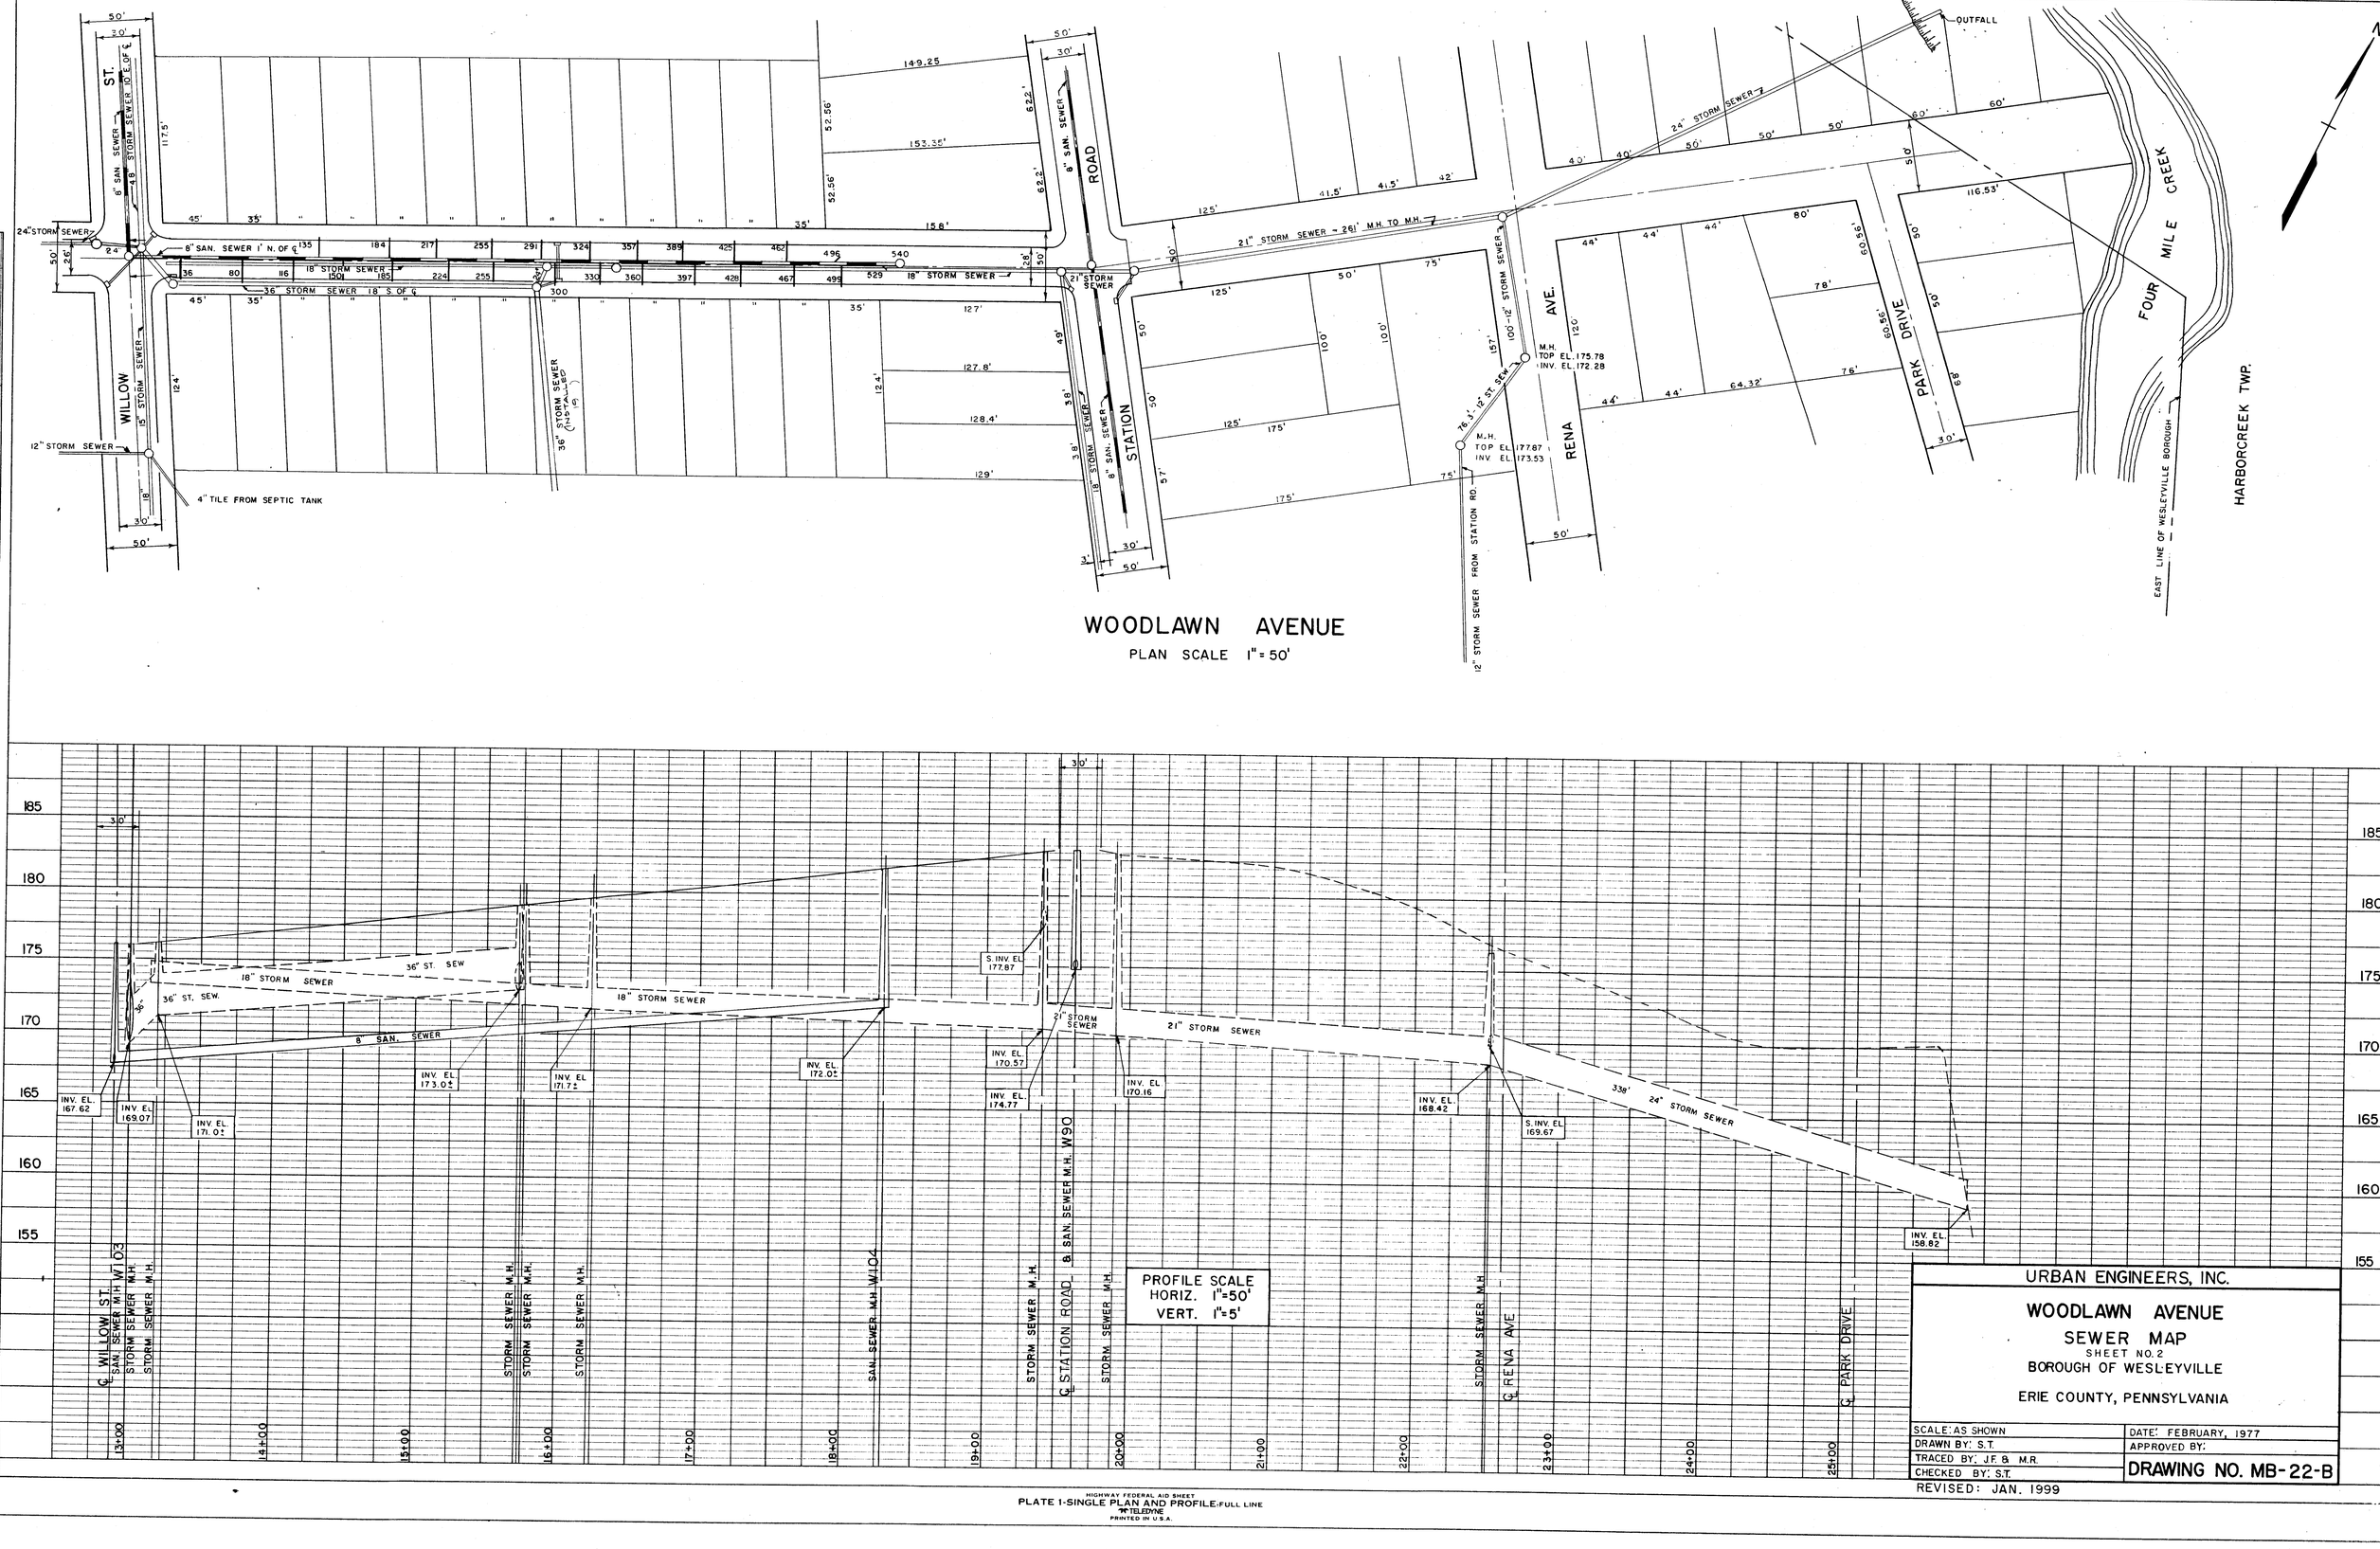

URBAN ENGINEERS, INC.


WOODLAWN AVENUE
SEWER MAP
SHEET NO. 2
BOROUGH OF WESLEYVILLE

ERIE COUNTY, PENNSYLVANIA

SCALE: AS SHOWN	DATE: FEBRUARY, 1977
DRAWN BY: S.T.	APPROVED BY:
TRACED BY: J.F. & M.R.	DRAWING NO. MB-22-B
CHECKED BY: S.T.	

REVISED: JAN. 1999

HIGHWAY FEDERAL AID SHEET
PLATE 1-SINGLE PLAN AND PROFILE-FULL LINE
TELEDYNE
PRINTED IN U.S.A.

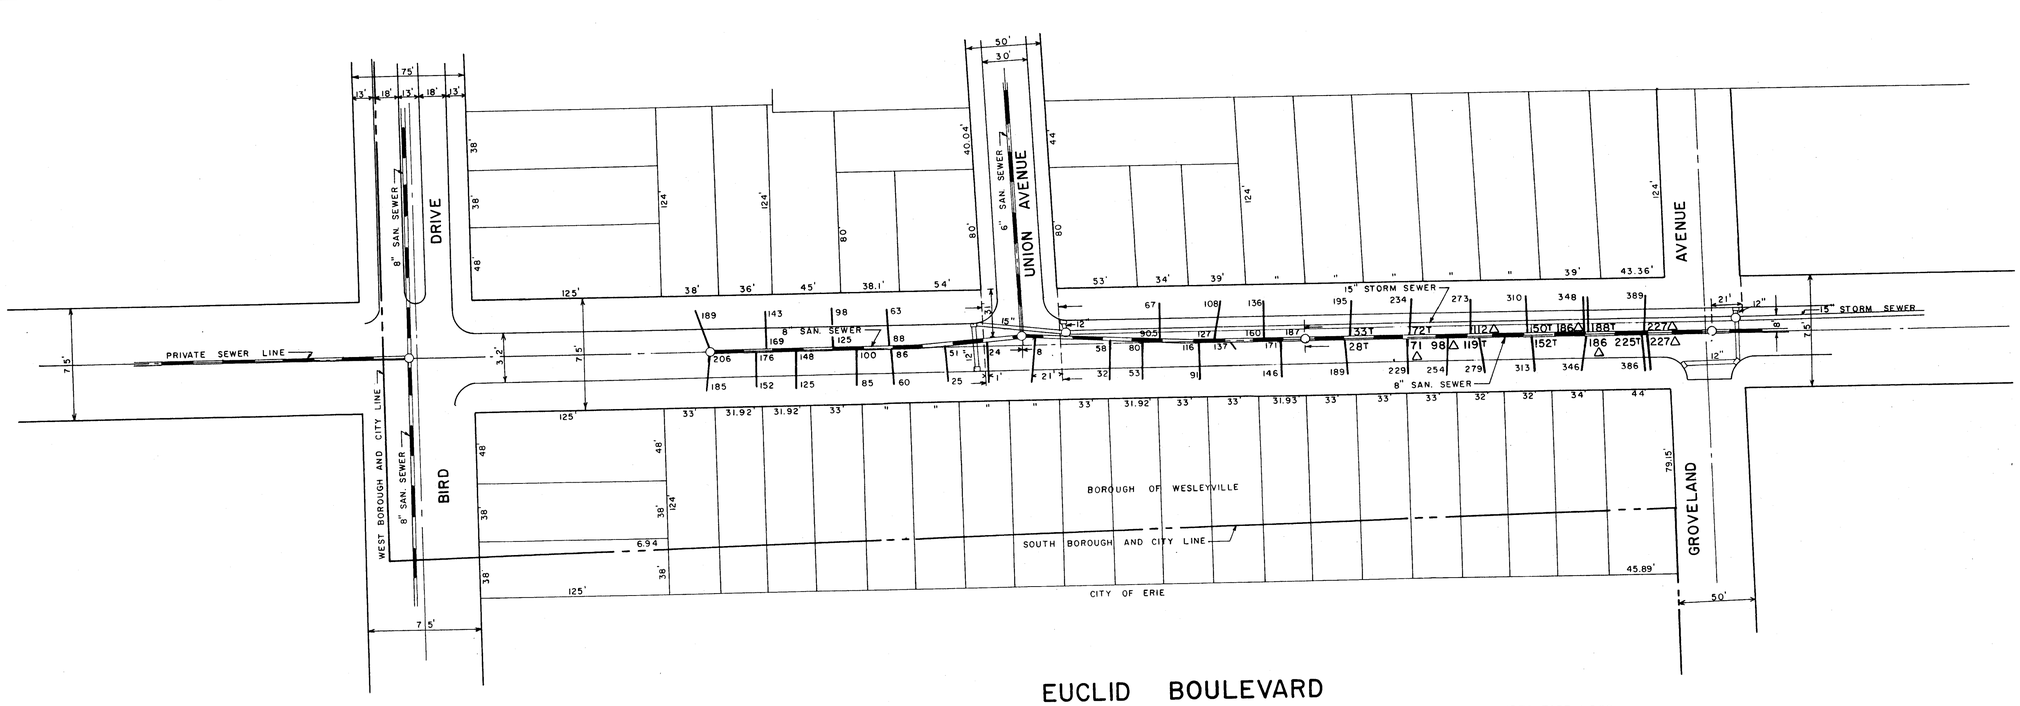

N

SANITARY SEWER
REHABILITATION — 1996

ALL DISTANCES MEASURED FROM CENTER OF NOTED MANHOLE OR RIGHT OF WAY LINE.


LEGEND

△ REPLACED LATERAL WYE

EUCLID BOULEVARD

PLAN SCALE 1" = 50'

33T — FROM VIDEO TAPE LOGS

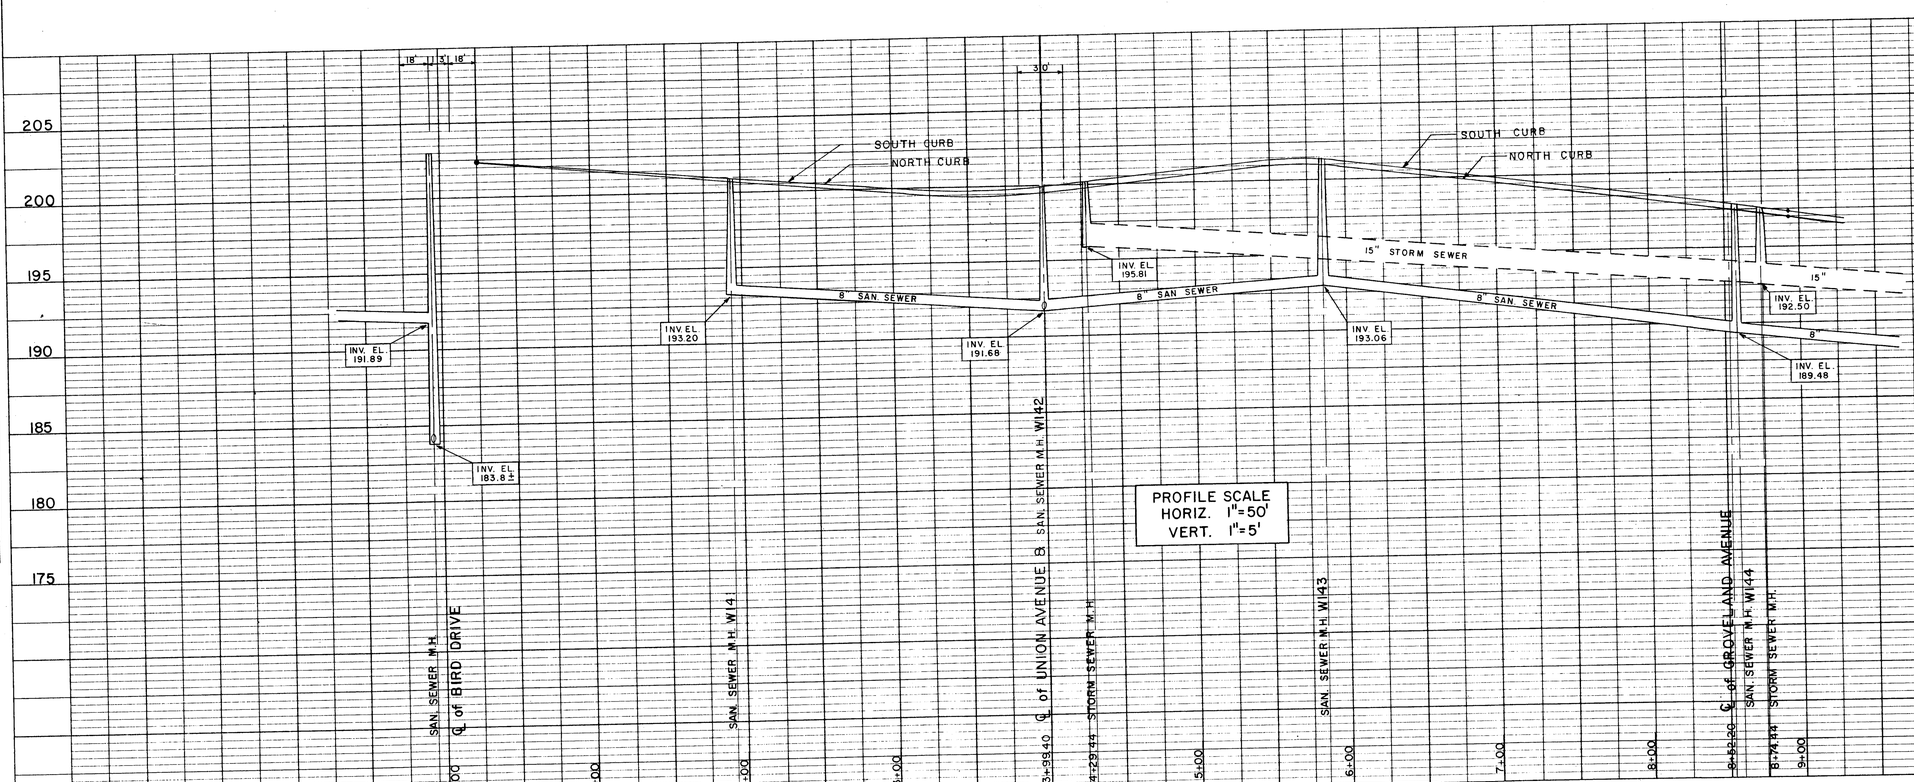

PROFILE SCALE
HORIZ. 1"=50'
VERT. 1"=5'

URBAN ENGINEERS, INC.

EUCLID BOULEVARD

SEWER MAP
SHEET NO. 1
BOROUGH OF WESLEYVILLE

ERIE COUNTY, PENNSYLVANIA


SCALE: AS SHOWN	DATE: FEBRUARY, 1977
DRAWN BY: S.T.	APPROVED BY:
TRACED BY: W.W.	DRAWING NO. MB-23A
CHECKED BY: S.T.	

REVISED: JAN. 1999

PLAN — SURVEYED, PLOTTED, ALIGNMENT CHECKED, RT. OF WAY CHECKED, NOTE BOOK, No., DATE, BY


PROFILE — SURVEYED, PLOTTED, GRADES CHECKED, AS-BUILT NOTED, STRUCTURE NOTATIONS CHECKED, NOTE BOOK, No., DATE, BY

HIGHWAY FEDERAL AID SHEET
PLATE 1-SINGLE PLAN AND PROFILE-FULL LINE
TELEDYNE
PRINTED IN U.S.A.

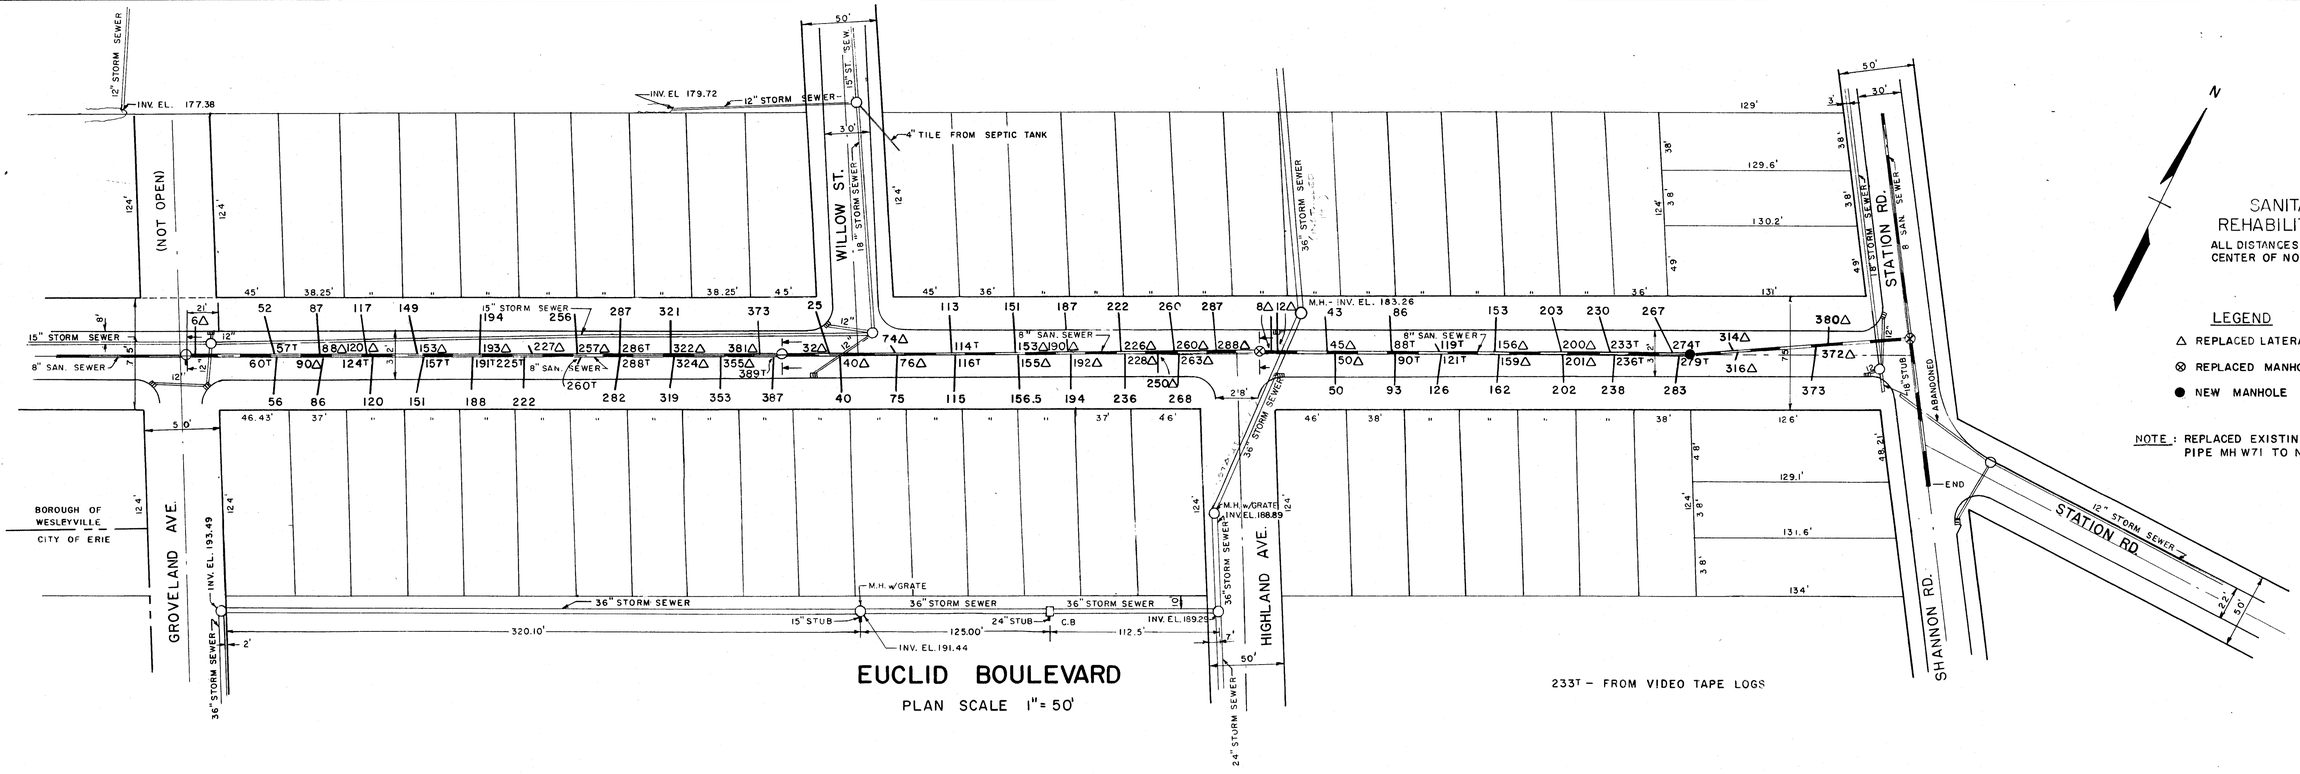

EUCLID BOULEVARD

PLAN SCALE 1" = 50'

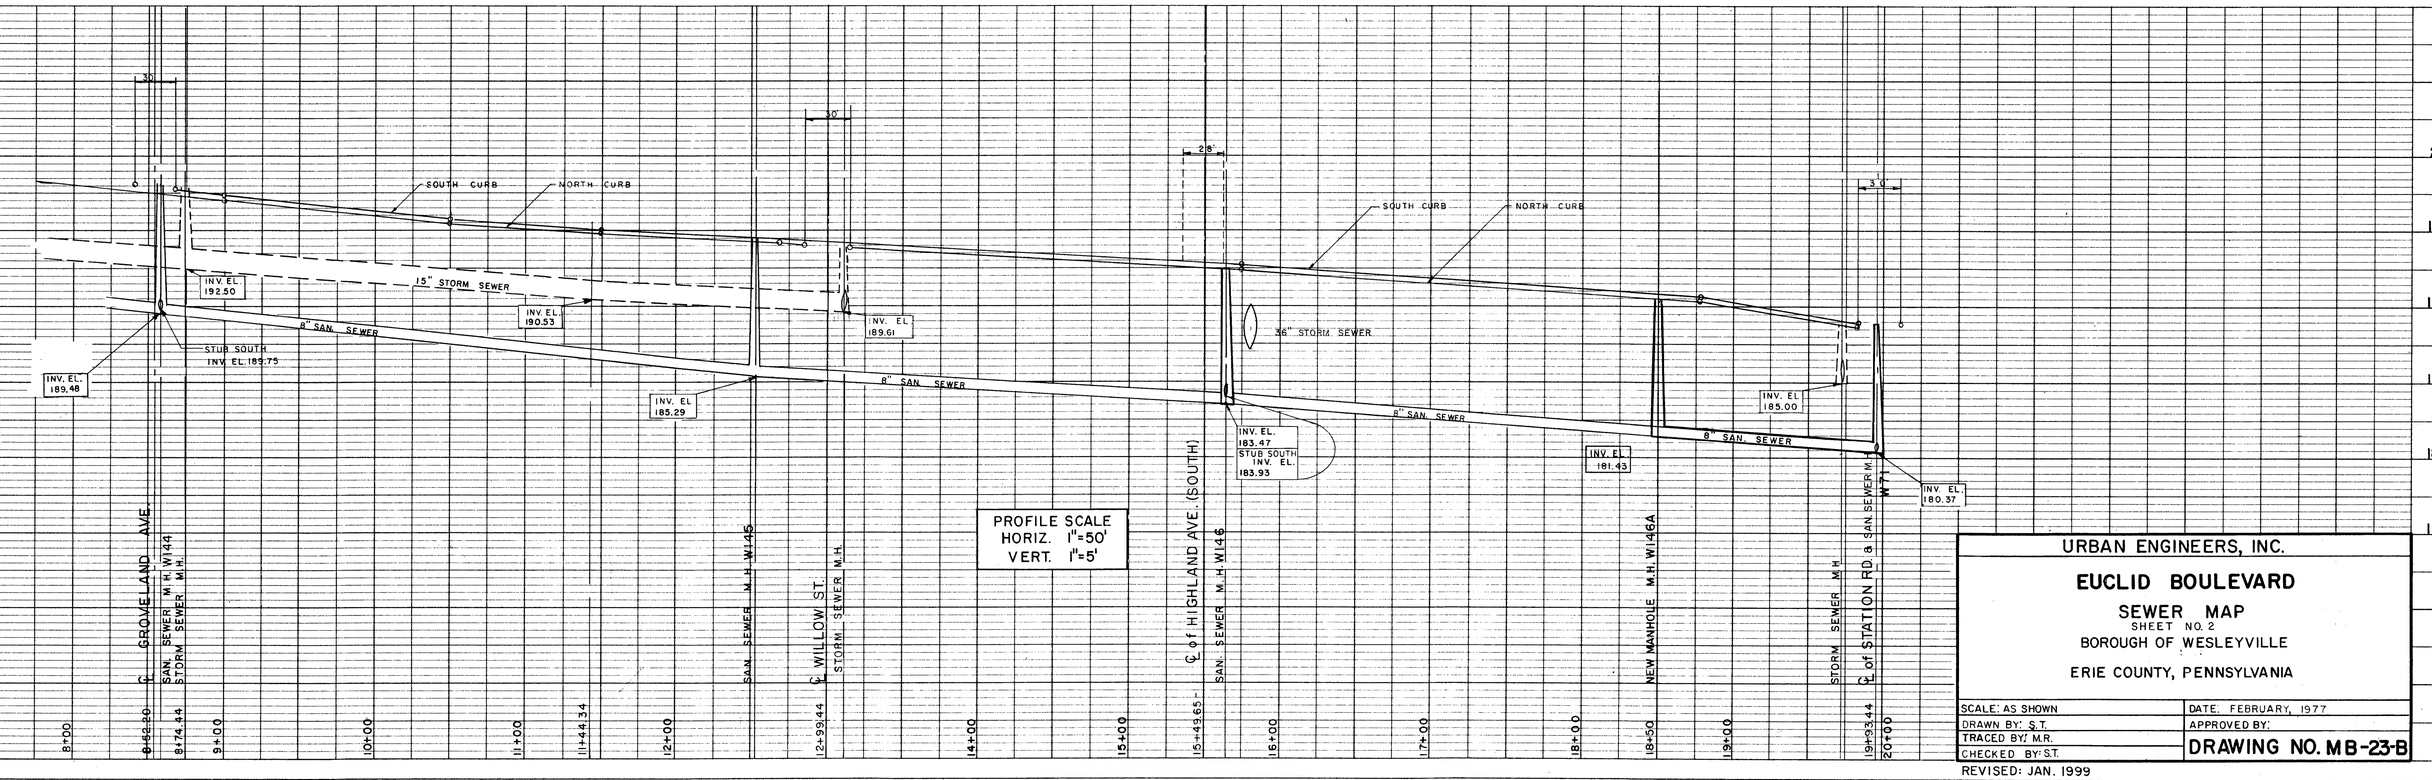

URBAN ENGINEERS, INC.

EUCLID BOULEVARD

SEWER MAP
SHEET NO. 2
BOROUGH OF WESLEYVILLE

ERIE COUNTY, PENNSYLVANIA


SCALE: AS SHOWN	DATE: FEBRUARY, 1977
DRAWN BY: S.T.	APPROVED BY:
TRACED BY: M.R.	DRAWING NO. MB-23-B
CHECKED BY: S.T.	


REVISED: JAN. 1999

PLAN — SURVEYED, PLOTTED, ALIGNMENT CHECKED, BY, OF MAT CHECKED — NOTE BOOK — No.

PROFILE — SURVEYED, PLOTTED, ELEVATIONS CHECKED, STRUCTURE NOTATIONS CHECKED — NOTE BOOK — No.

HIGHWAY FEDERAL AID SHEET
PLATE 1-SINGLE PLAN AND PROFILE-FULL LINE
TELEDYNE
PRINTED IN U.S.A.

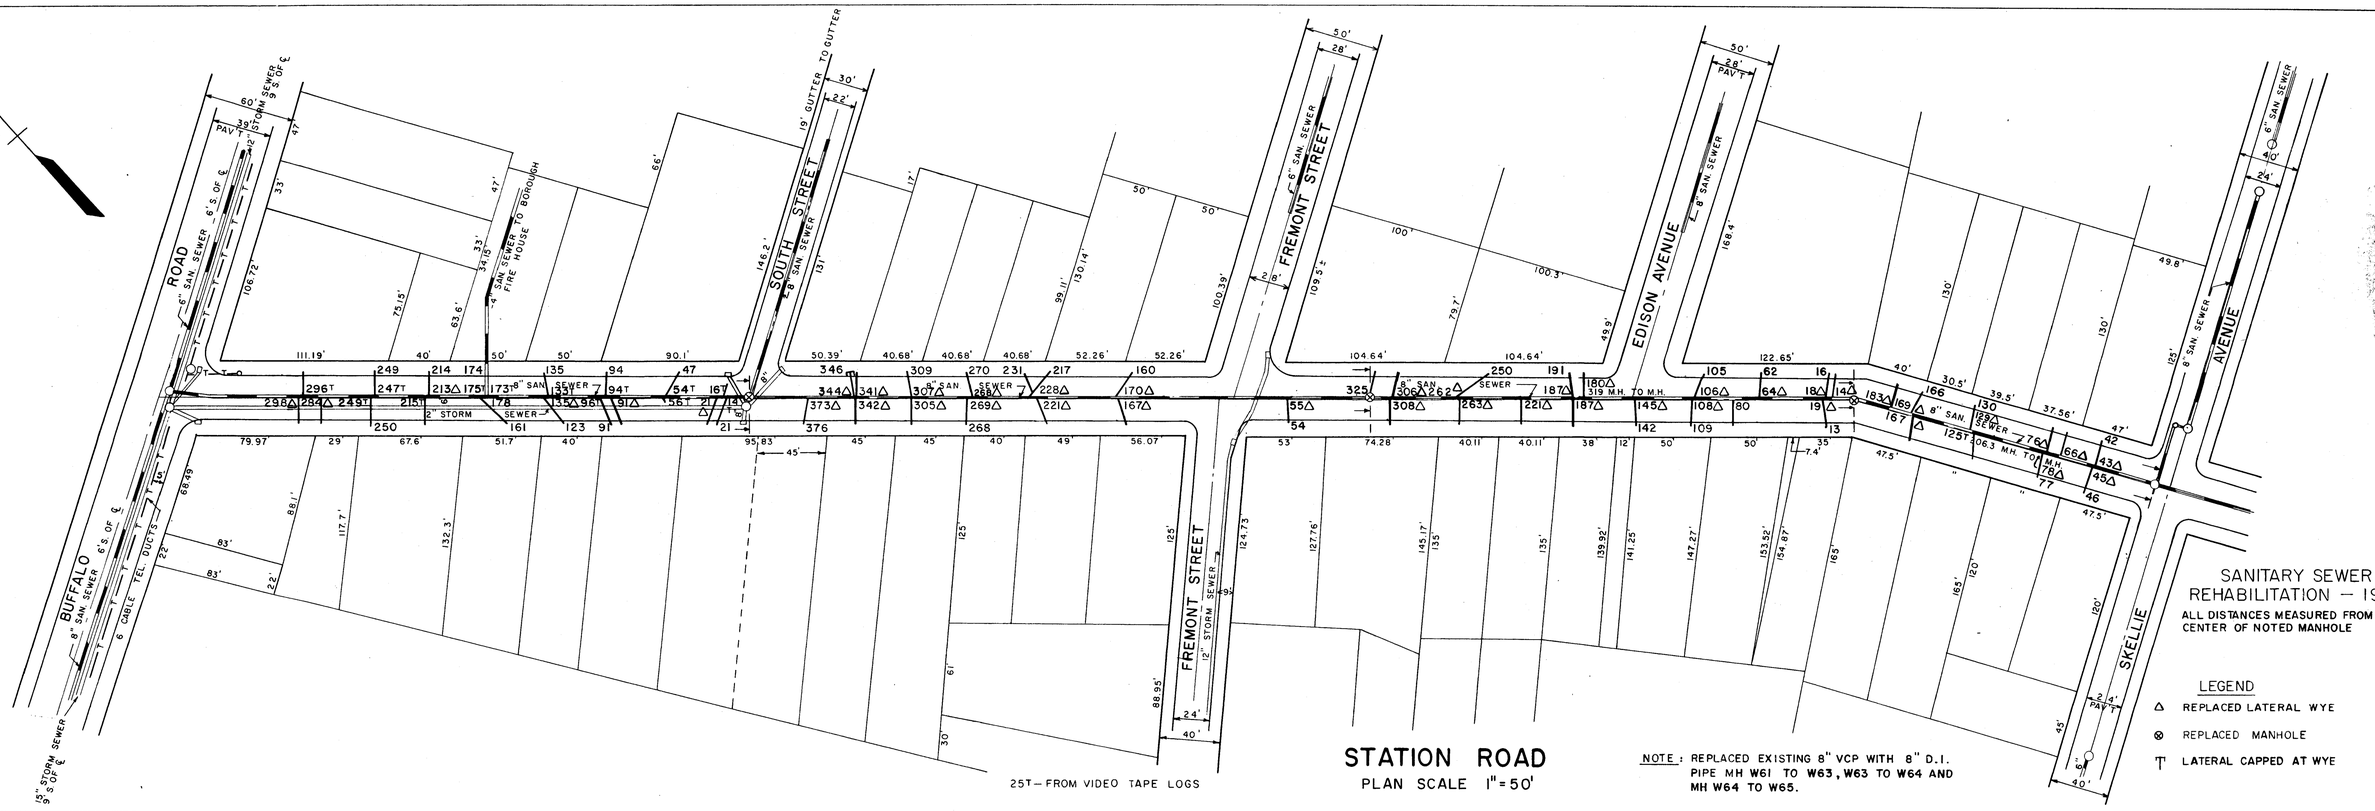

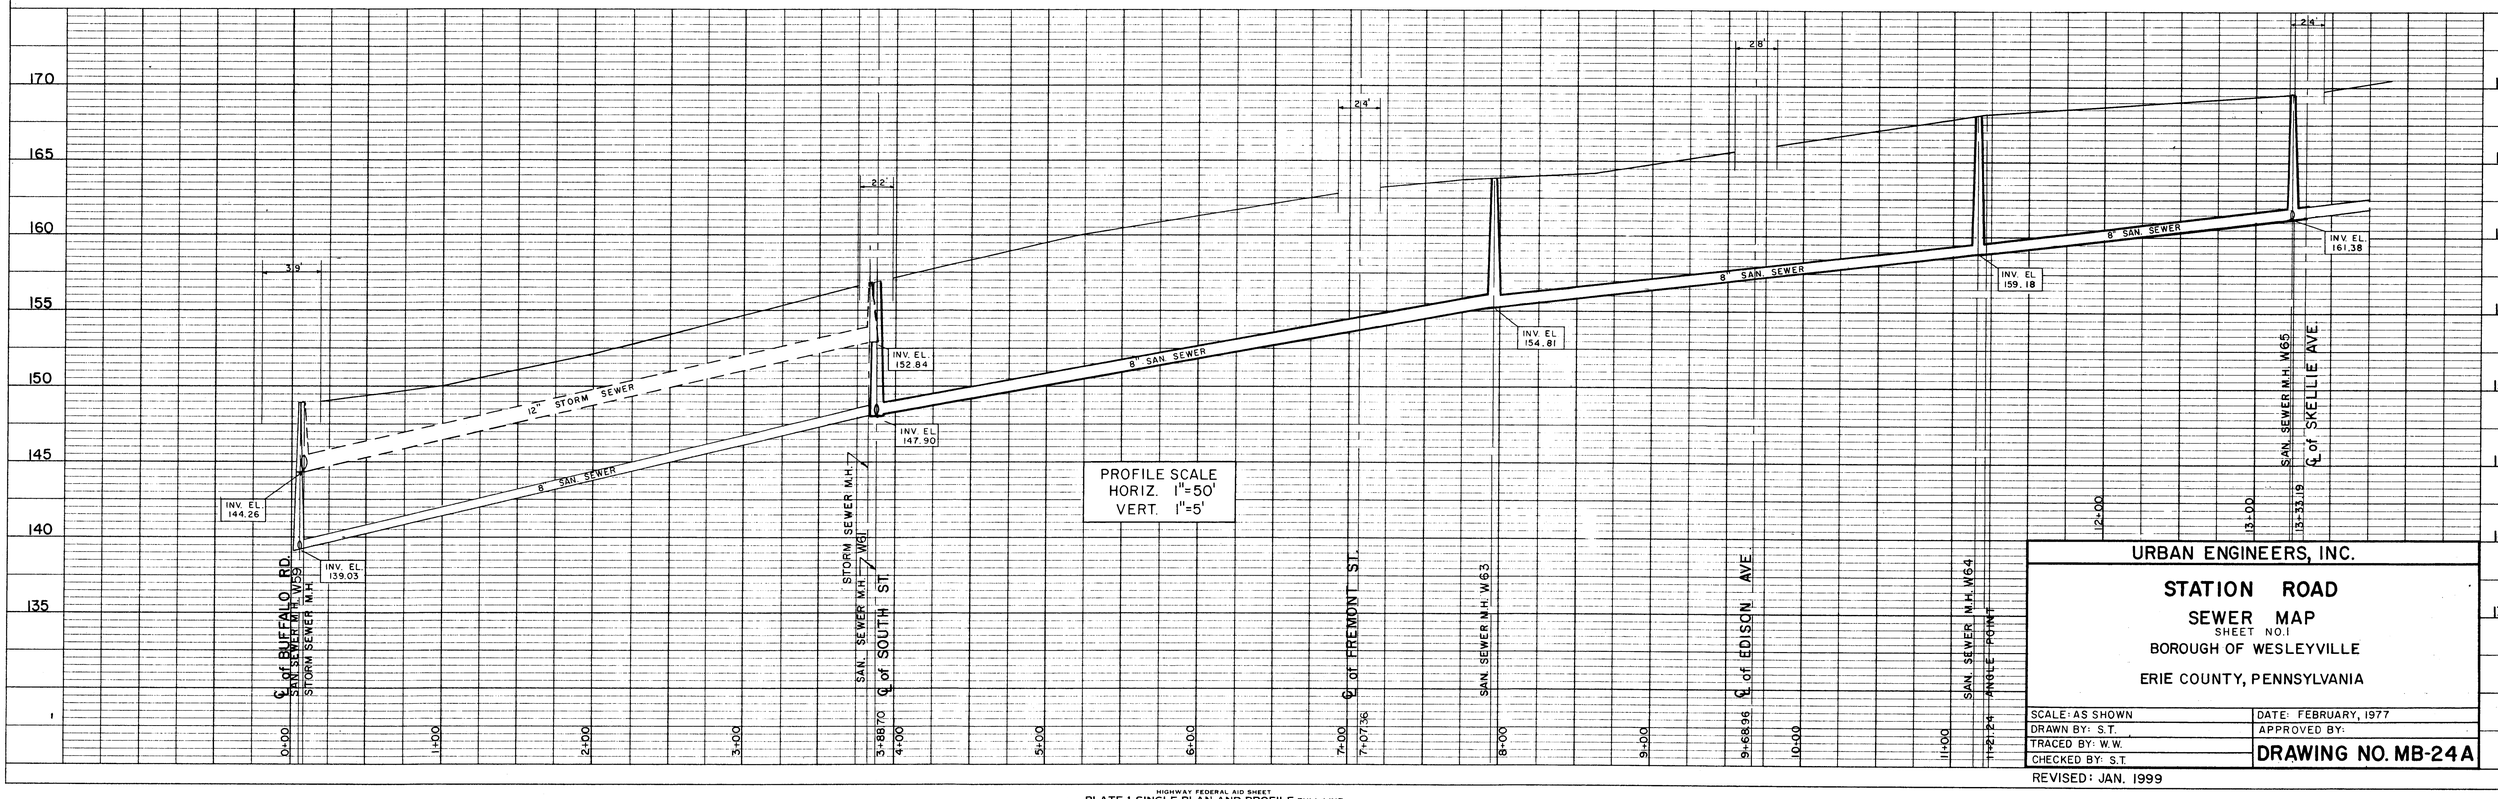

URBAN ENGINEERS, INC.

STATION ROAD

SEWER MAP

SHEET NO.1

BOROUGH OF WESLEYVILLE


ERIE COUNTY, PENNSYLVANIA

SCALE: AS SHOWN	DATE: FEBRUARY, 1977
DRAWN BY: S.T.	APPROVED BY:
TRACED BY: W.W.	DRAWING NO. MB-24A
CHECKED BY: S.T.	


REVISED: JAN. 1999

PLAN: SURVEYED, PLOTTED, NOTE BOOK, No., ALIGNMENT CHECKED, RT. OF WAY CHECKED

PROFILE: PLOTTED, GRADES CHECKED, B. M.'s NOTED, STRUCTURE NOTATIONS CHECKED

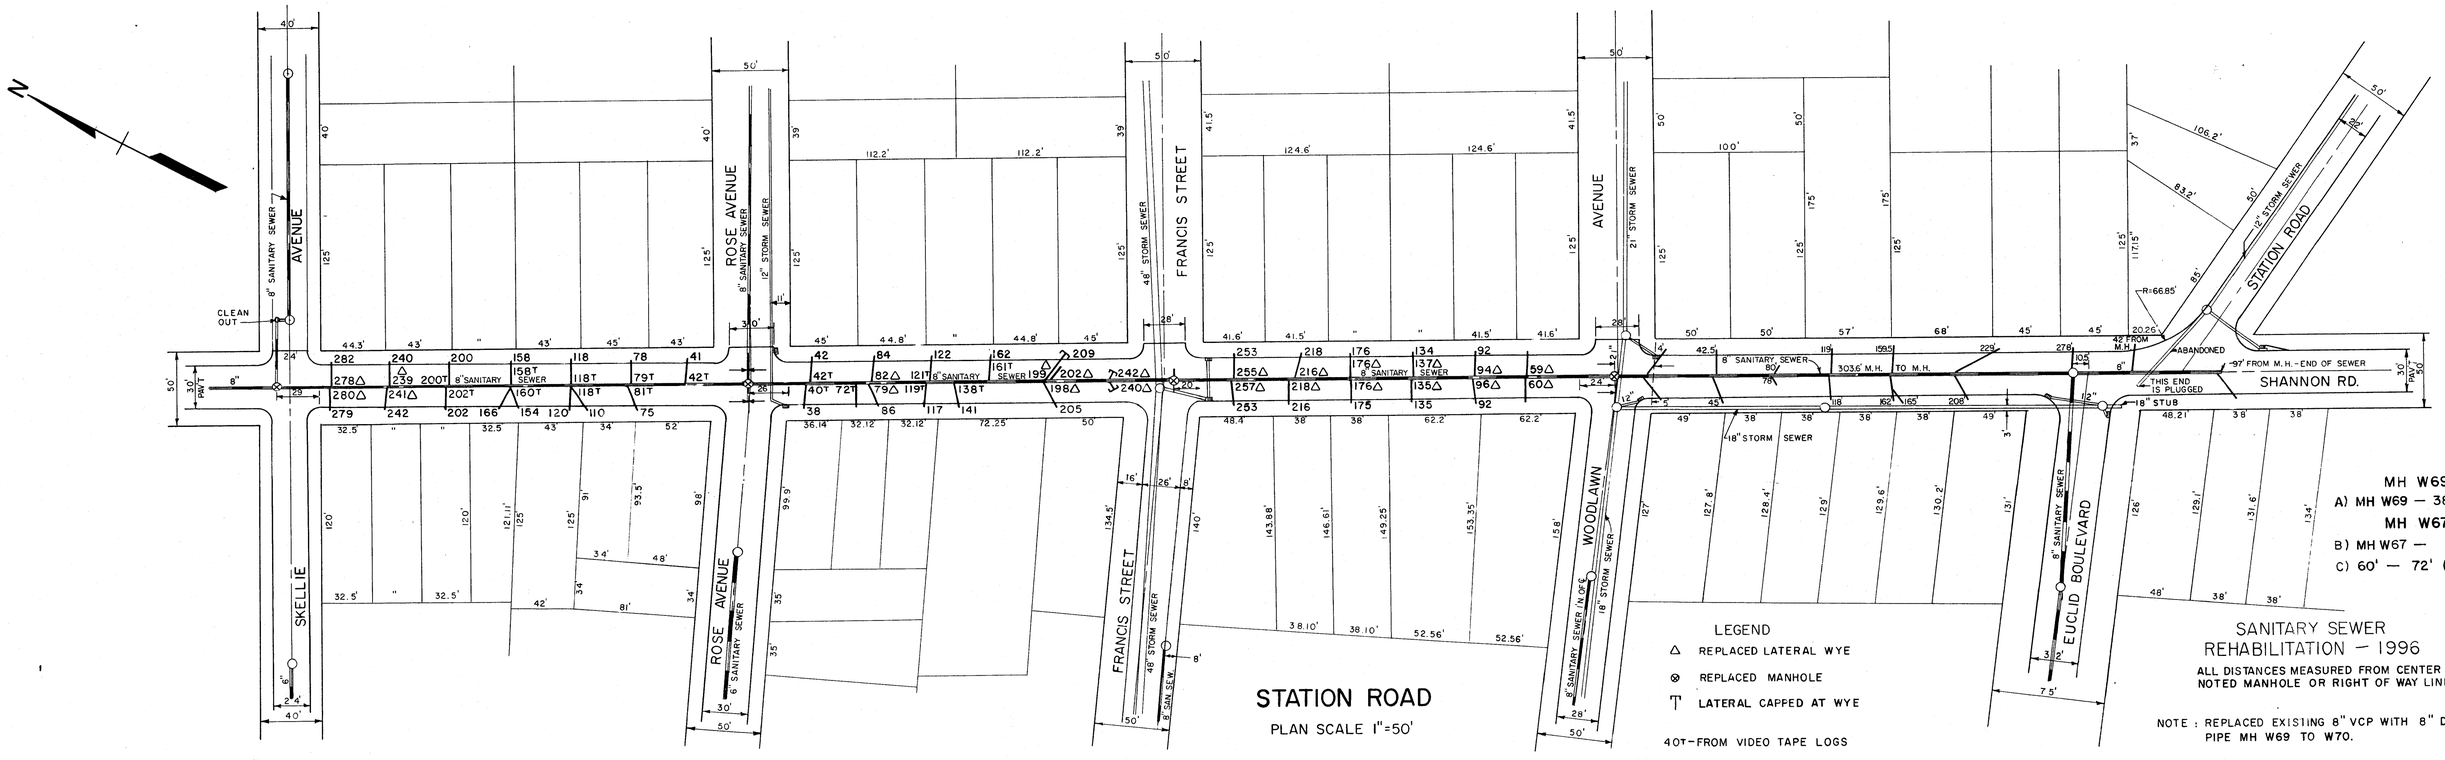

PLAN — SURVEYED, PLOTTED, NOTE BOOK, No., ALIGNMENT CHECKED, RT. OF WAY CHECKED, DATE, BY

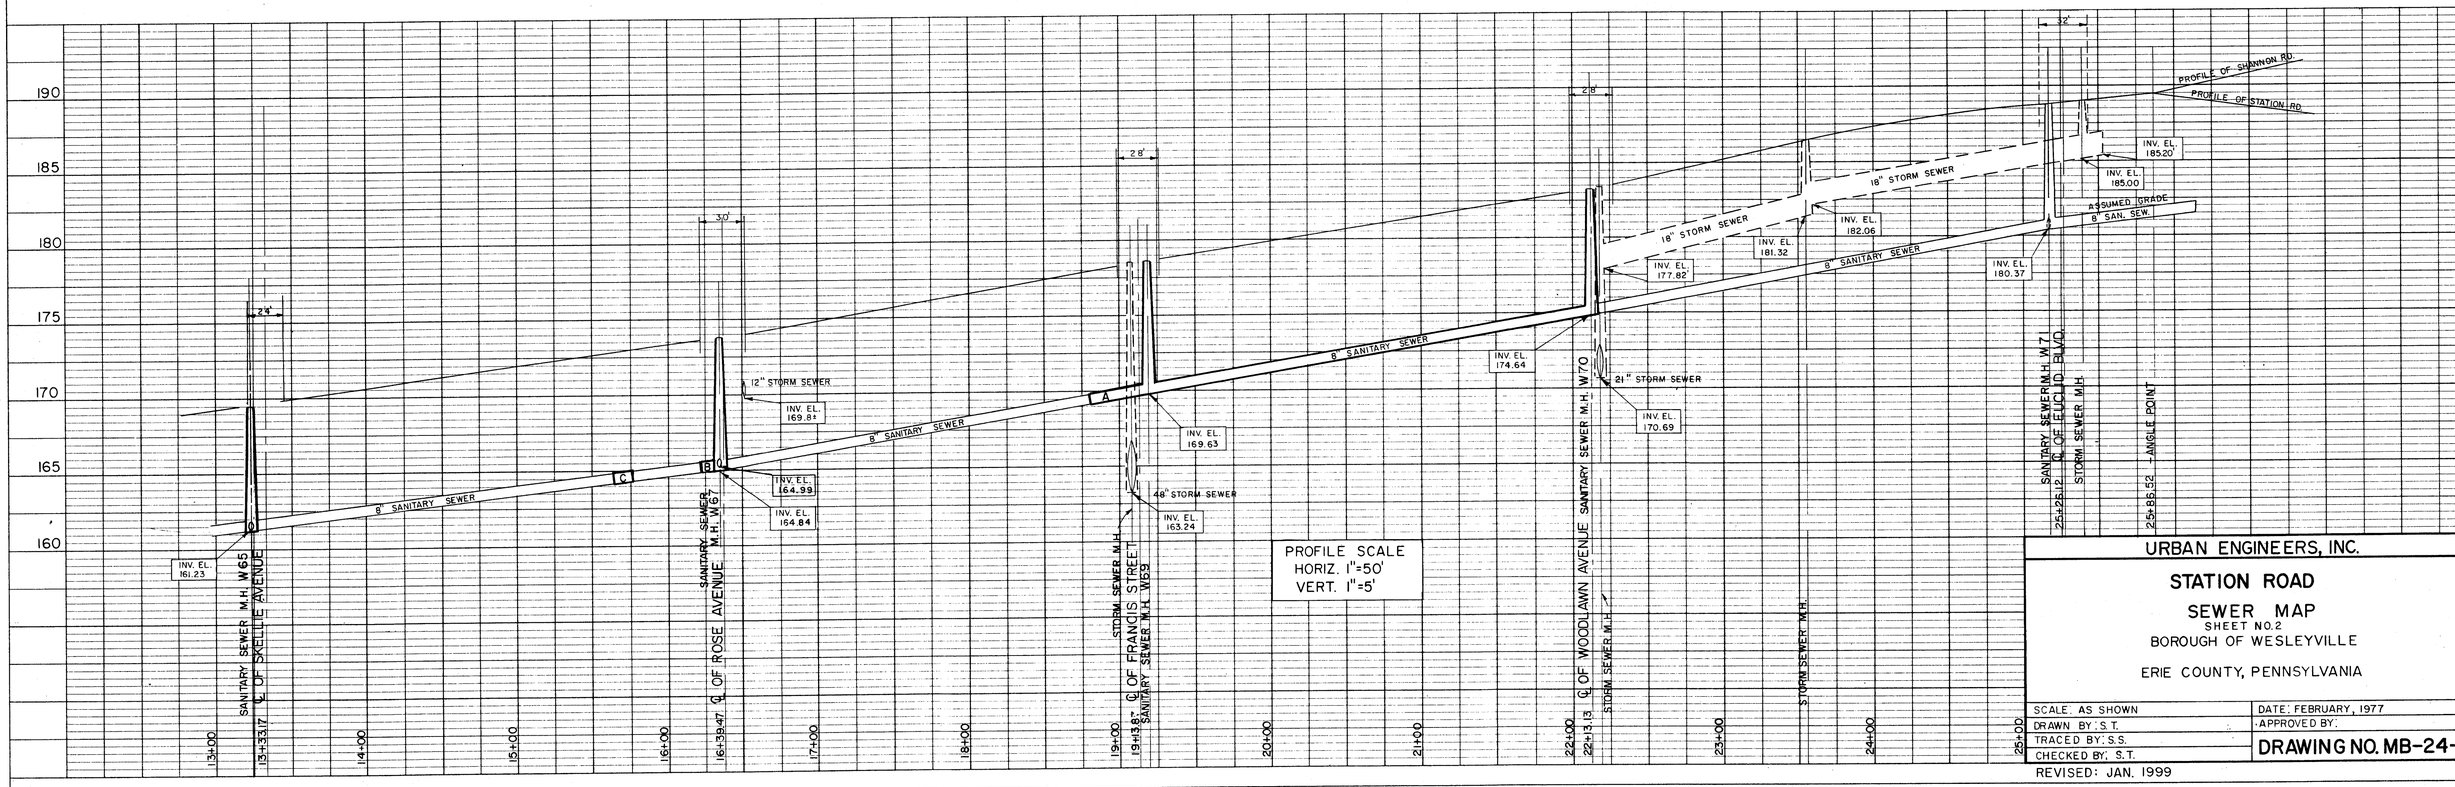

PROFILE — SURVEYED, PLOTTED, NOTE BOOK, No., FIGURES CHECKED, & M.'s NOTED, STRUCTURE NOTATIONS CHECKED, DATE, BY


URBAN ENGINEERS, INC.


STATION ROAD
SEWER MAP
SHEET NO.2
BOROUGH OF WESLEYVILLE

ERIE COUNTY, PENNSYLVANIA

SCALE: AS SHOWN	DATE: FEBRUARY, 1977
DRAWN BY: S.T.	APPROVED BY:
TRACED BY: S.S.	DRAWING NO. MB-24-B
CHECKED BY: S.T.	

REVISED: JAN. 1999

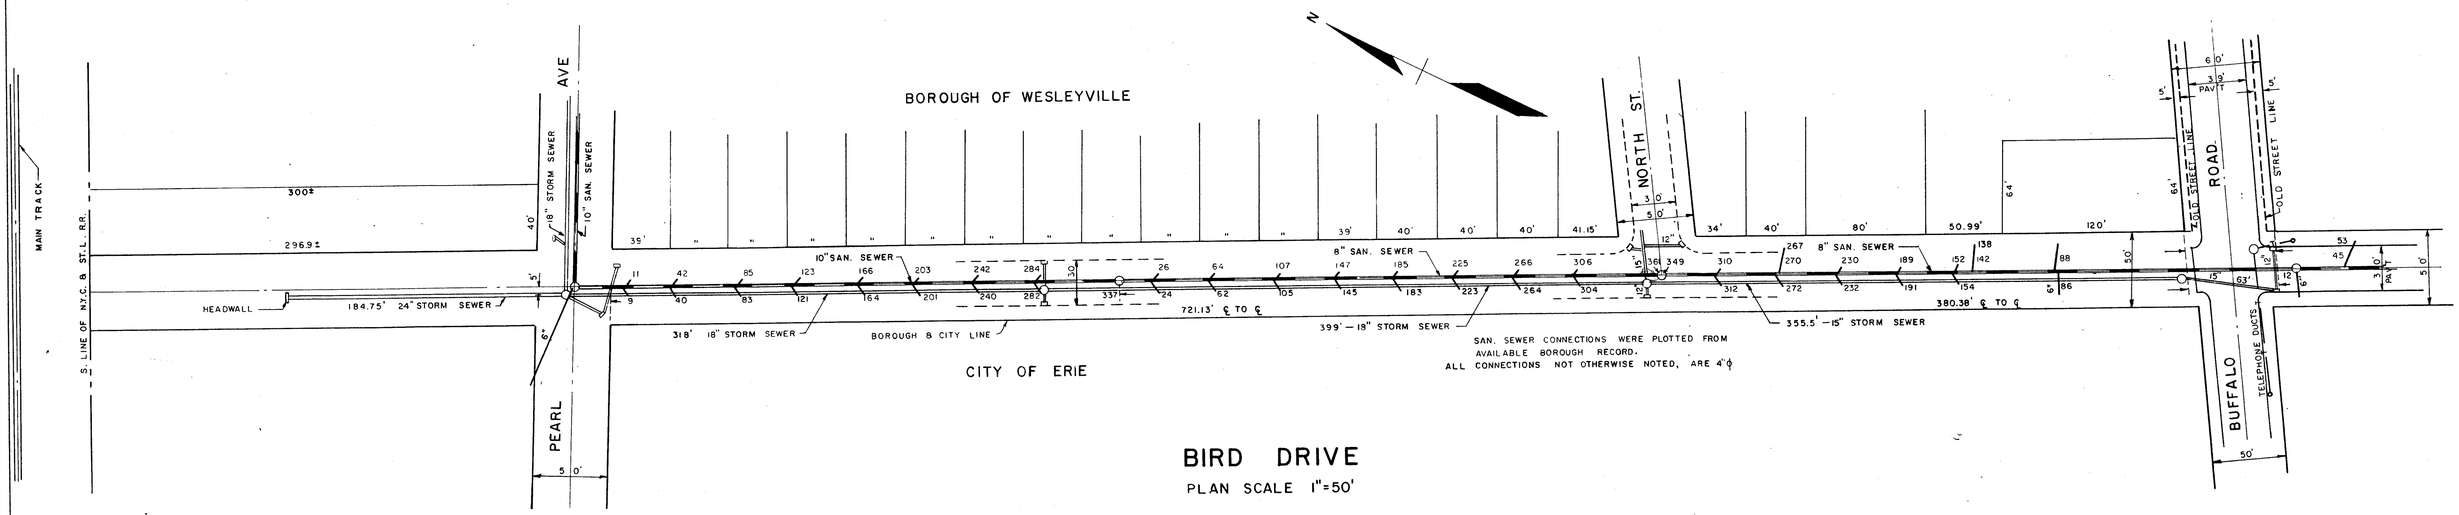

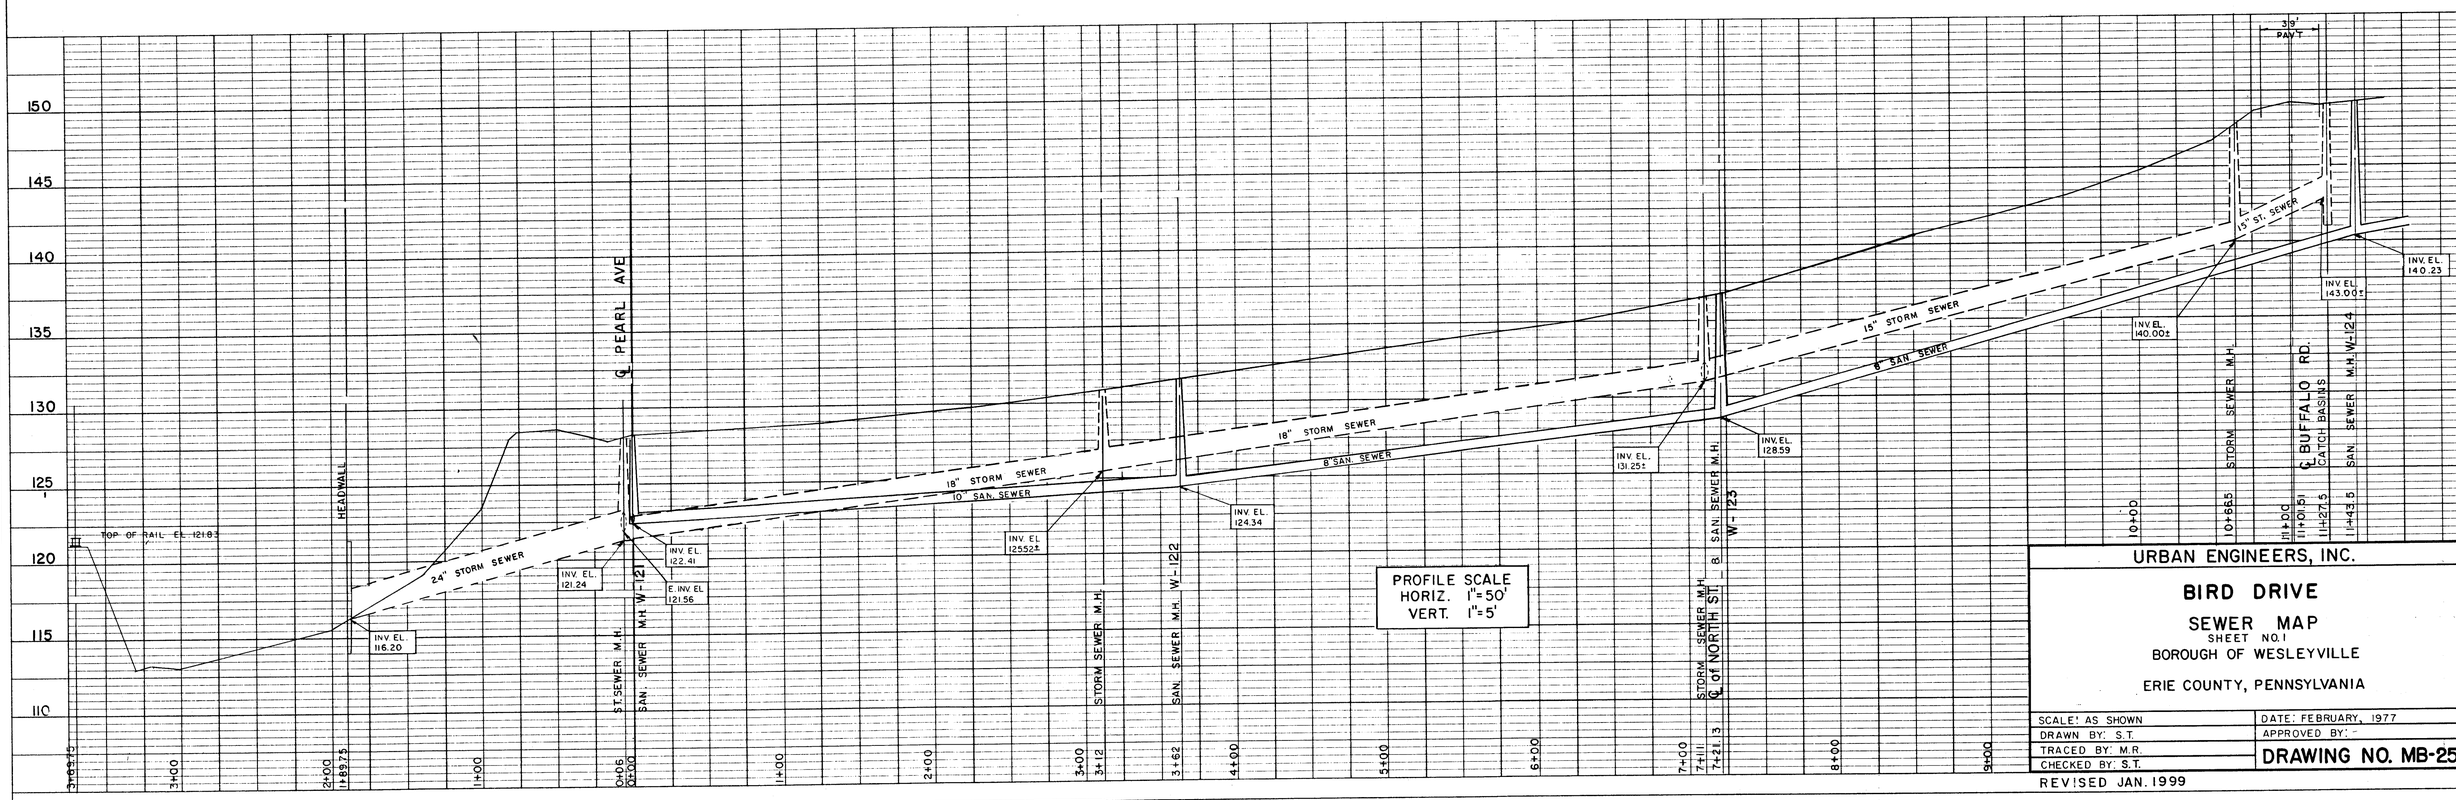

URBAN ENGINEERS, INC.

BIRD DRIVE

SEWER MAP

SHEET NO.1

BOROUGH OF WESLEYVILLE

ERIE COUNTY, PENNSYLVANIA

SCALE: AS SHOWN	DATE: FEBRUARY, 1977
DRAWN BY: S.T.	APPROVED BY: -
TRACED BY: M.R.	DRAWING NO. MB-25-A
CHECKED BY: S.T.	

REVISED JAN. 1999

PLAN: SURVEYED, PLOTTED, NOTE BOOK, No., ALIGNMENT CHECKED, R/ OF WAY CHECKED

PROFILE: SURVEYED, PLOTTED, GRADES CHECKED, R. M.'s NOTED, STRUCTURE NOTATIONS CHECKED, BY, DATE

BOROUGH OF WESLEYVILLE

CITY OF ERIE

BUFFALO ROAD — OLD STREET LINES — 60' — 39' PAVT — 5' — 30'

PROSPECT AVENUE — 50' — FLOW — 8" SANITARY SEWER — 11 HOUSES CONNECTED (RECORD 1947)

EDISON AVENUE — 50' — 30' — 15" STORM SEWER

FAIRMOUNT PARKWAY — 57.5' — FLOW — 8" SANITARY SEWER — 4 HOUSES CONNECTED (RECORD 1947)

LINWOOD AVENUE — 50' — 26'

GLENDALE AVE. — 40.5' — 24' — SANITARY SEWER — FLOW

BORDER AND CITY LINE

480.82' — 284.29' — 329.24' — 260'

15" STORM SEWER — 12" STORM SEWER

8" SANITARY SEWER

ANGLE POINT

BIRD DRIVE

PLAN SCALE 1"= 50'

SANITARY SEWER REHABILITATION — 1997

ALL DISTANCES MEASURED FROM CENTER OF NOTED MANHOLE OR RIGHT OF WAY LINE

NOTE : REPLACED EXISTING 8" VCP WITH 8" PVC PIPE MH W128 TO W127 AND W127 TO W126.

NOTE: SANITARY SEWER CONNECTIONS WERE PLOTTED FROM AVAILABLE BOROUGH RECORDS.
ALL CONNECTIONS NOT OTHERWISE MARKED ARE 4" DIA.

LEGEND

△ REPLACED LATERAL WYE

⊗ REPLACED MANHOLE

PLAN — SURVEYED — PLOTTED — ALIGNMENT CHECKED — R/T. OF WAY CHECKED — NOTE BOOK — No.

PROFILE — SURVEYED — PLOTTED — GRADES CHECKED — NOTE BOOK — No. — STRUCTURE NOTATIONS CHECKED

170 / 165 / 160 / 155 / 150 / 145 / 140

1+01.5 ℄ OF BUFFALO RD.

INV. EL. 140.23

1+43.5 SANITARY SEWER M.H. W124

8" SANITARY SEWER

INV. EL. 142.5 ±

1+61.51

12+00 — 13+00 — 14+00 — 15+00 — 16+00

16+34.4 ± ℄ OF PROSPECT AVE.

SAN. SEWER M.H. W125

INV. EL. 147.67

17+00 — 18+00 — 19+00

19+76.52 ℄ OF EDISON AVENUE

19+79.5 SANITARY SEWER M.H. W126

19+89 STORM SEWER M.H.

INV. EL. 155.96

INV. EL. 160.19

15" STORM SEWER

INV. EL. 163.09

8" SANITARY SEWER

INV. EL. 158.84

20+00 — 21+00 — 22+00 — 23+00

STORM SEWER M.H.

23+56.5 ℄ OF LINWOOD AVENUE

SANITARY SEWER M.H. W127

12" STORM SEWER

INV. EL. 167.76

8" SANITARY SEWER

INV. EL. 164.44

24+00 — 25+00 — 26+00

STORM SEWER M.H.

26+60.69 ± ℄ OF GLENDALE AVENUE — SAN. SEW. M.H. W128

PROFILE SCALE
HORIZ. 1"= 50'
VERT. 1"= 5'

URBAN ENGINEERS, INC.


BIRD DRIVE

SEWER MAP
SHEET NO. 2
BOROUGH OF WESLEYVILLE


ERIE COUNTY, PENNSYLVANIA

SCALE: AS SHOWN	DATE: JANUARY, 1977
DRAWN BY: S.T.	APPROVED BY:
TRACED BY: RAS	DRAWING NO. MB-25-B
CHECKED BY: S.T.	

REVISED: JAN. 1999

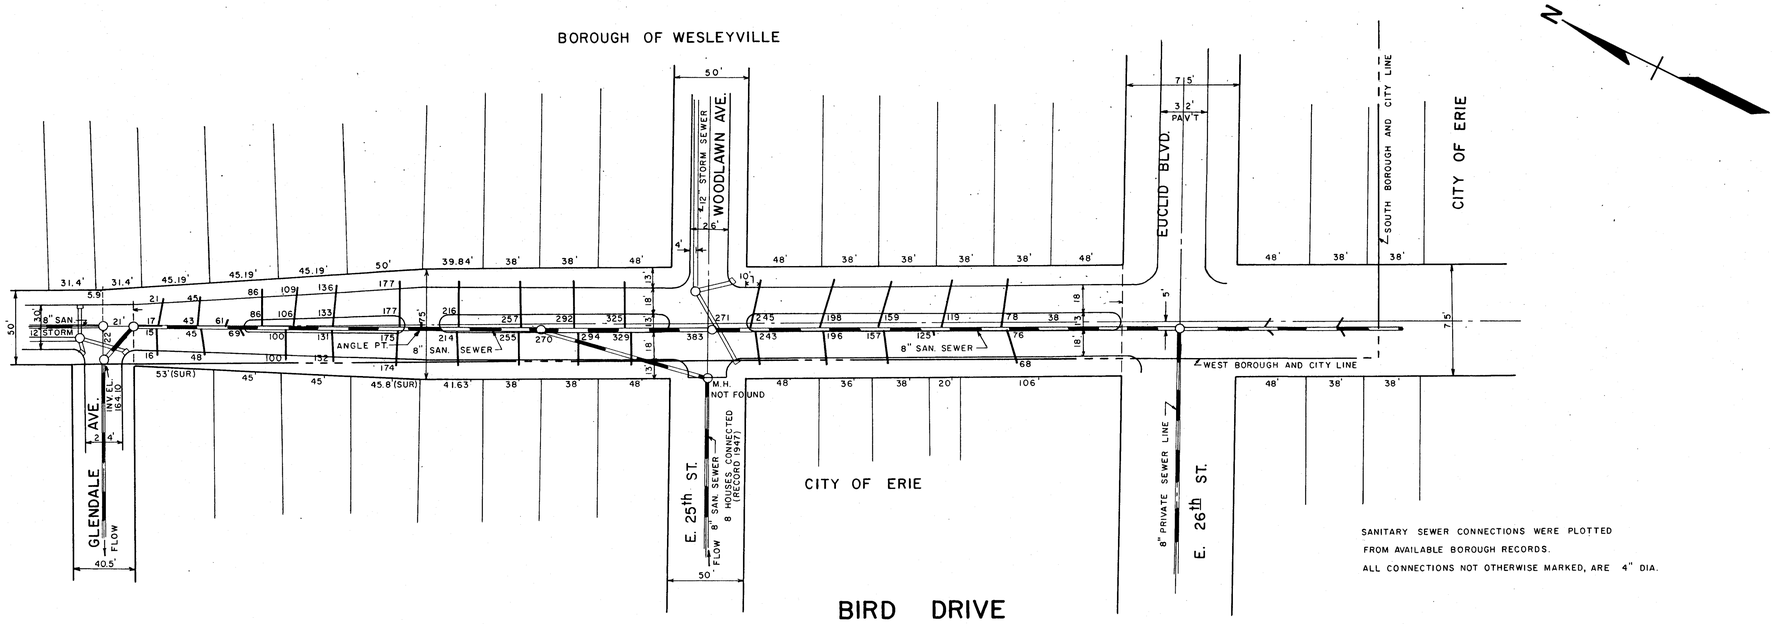

SANITARY SEWER CONNECTIONS WERE PLOTTED FROM AVAILABLE BOROUGH RECORDS.
ALL CONNECTIONS NOT OTHERWISE MARKED, ARE 4" DIA.

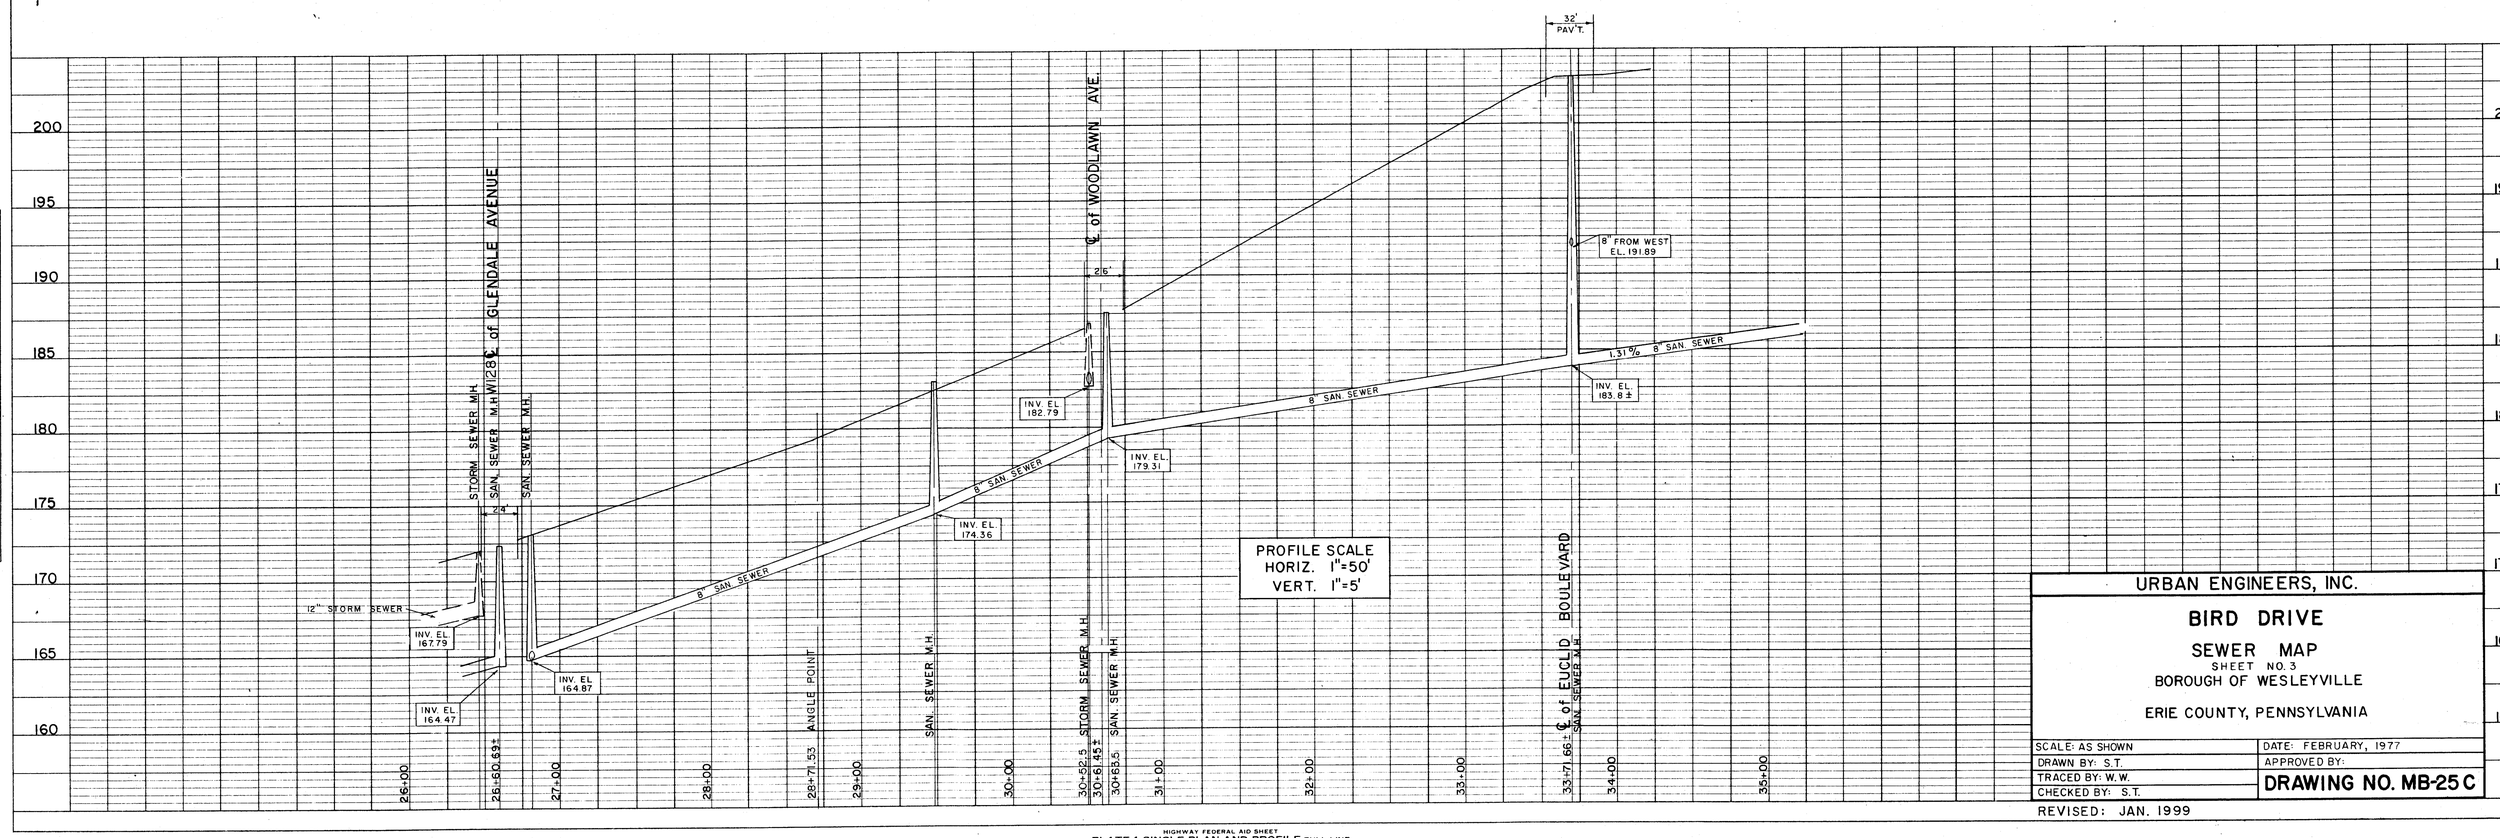

PROFILE SCALE
HORIZ. 1"=50'
VERT. 1"=5'

URBAN ENGINEERS, INC.

BIRD DRIVE

SEWER MAP

SHEET NO. 3
BOROUGH OF WESLEYVILLE

ERIE COUNTY, PENNSYLVANIA


SCALE: AS SHOWN	DATE: FEBRUARY, 1977
DRAWN BY: S.T.	APPROVED BY:
TRACED BY: W.W.	DRAWING NO. MB-25C
CHECKED BY: S.T.	


REVISED: JAN. 1999

PLAN — NOTE BOOK — No. — SURVEYED — PLOTTED — GRADES CHECKED — QUANTITIES CHECKED — RT. OF WAY CHECKED

PROFILE — NOTE BOOK — No. — SURVEYED — PLOTTED — GRADES CHECKED — QUANTITIES CHECKED — STRUCTURE NOTATIONS CHECKED

HIGHWAY FEDERAL AID SHEET
PLATE 1-SINGLE PLAN AND PROFILE-FULL LINE
TEKTELDYNE
PRINTED IN U.S.A.

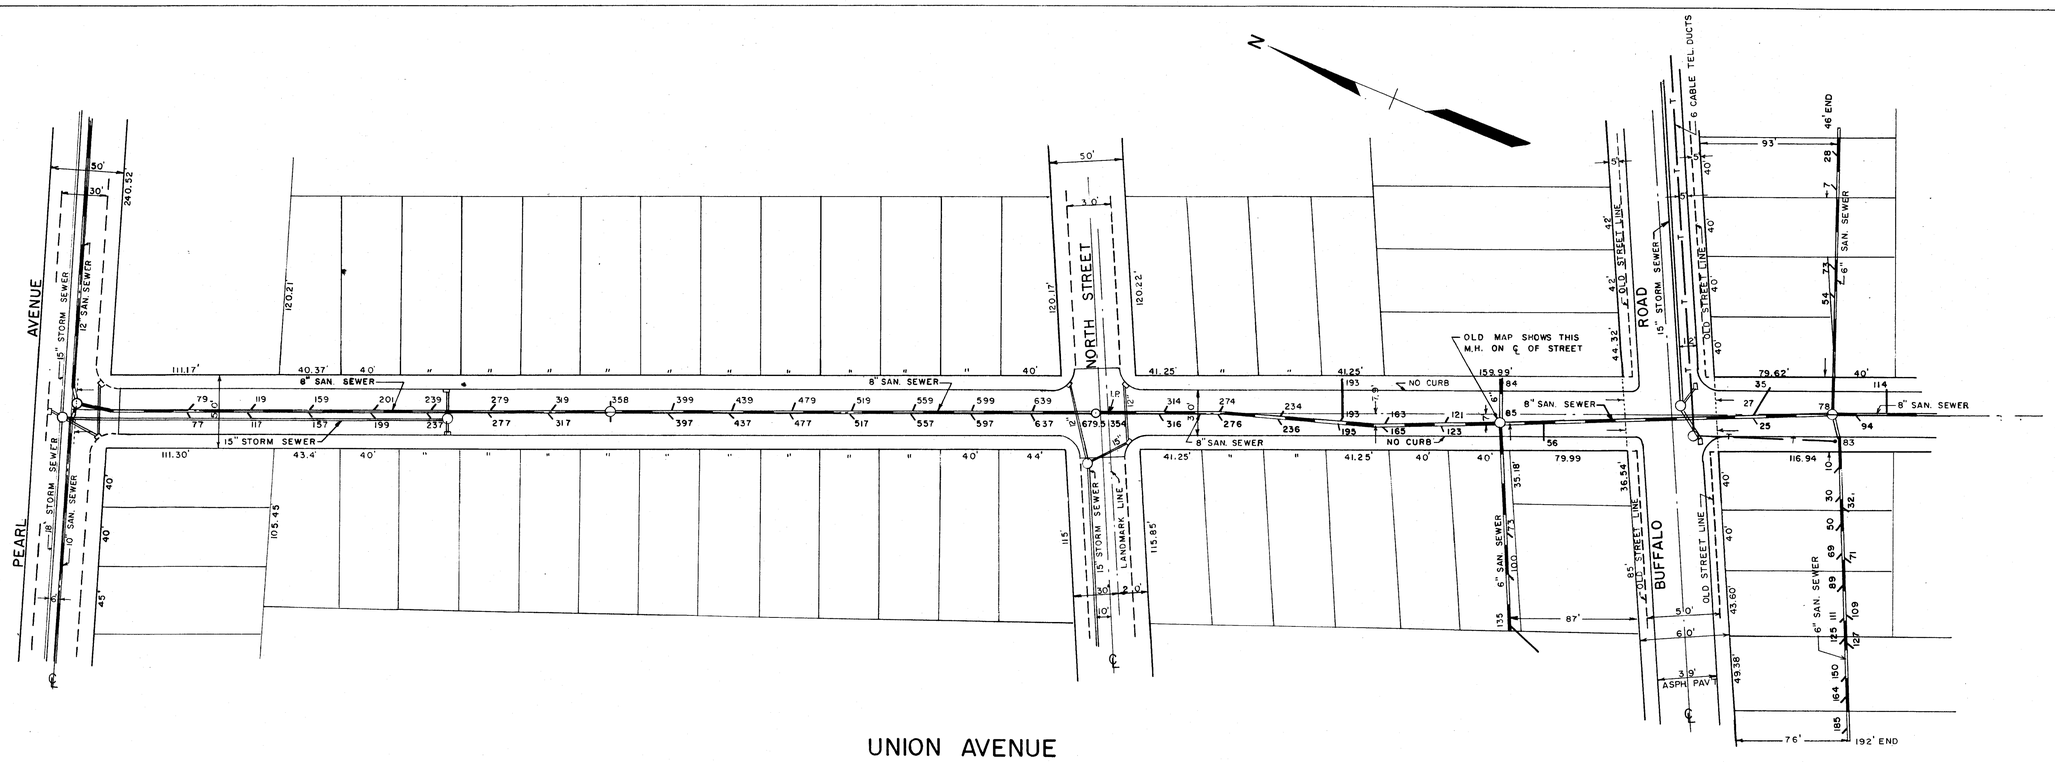

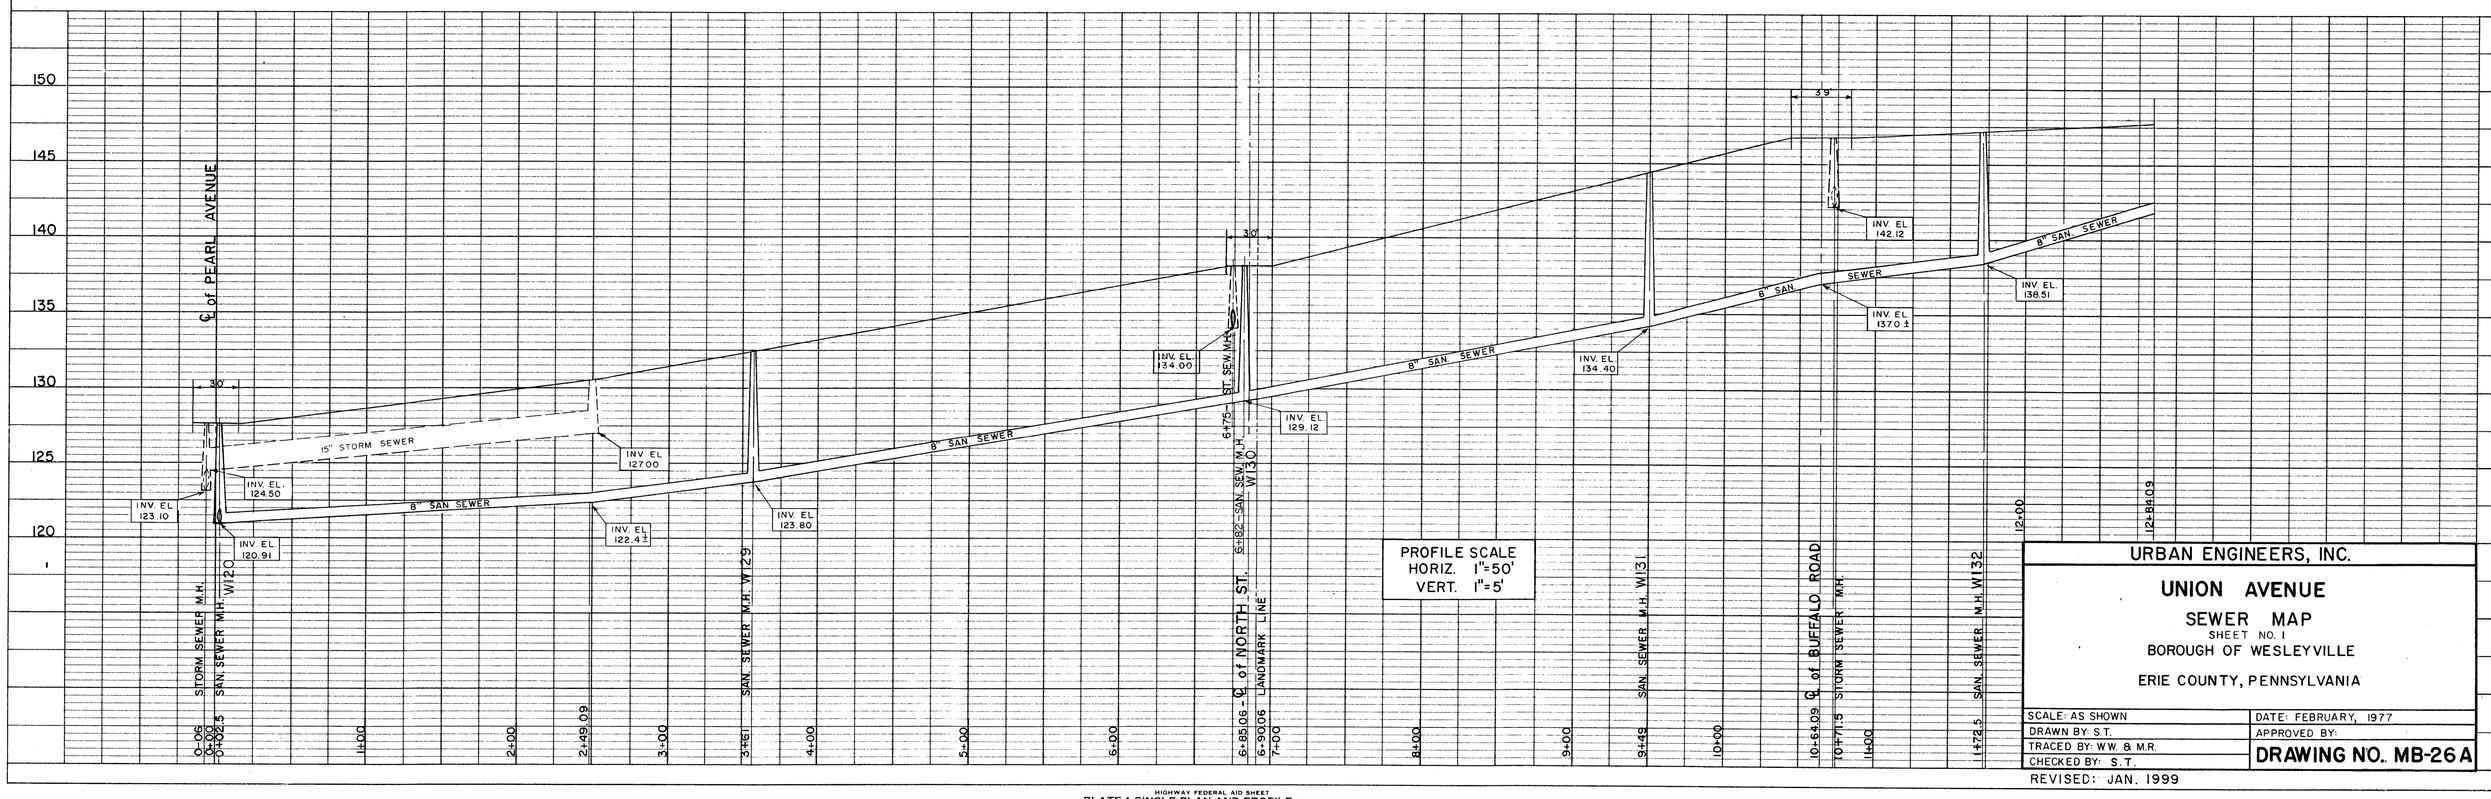

PLAN	SURVEYED: DATE
	PLOTTED
NOTE BOOK	GRADES CHECKED
	ALIGNMENT CHECKED
No.	RT. OF WAY CHECKED

PROFILE	SURVEYED
	PLOTTED
NOTE BOOK	GRADES CHECKED
	ALIGNMENT CHECKED
No.	STRUCTURE NOTATIONS CHECKED

URBAN ENGINEERS, INC.

UNION AVENUE

SEWER MAP

SHEET NO. 1


BOROUGH OF WESLEYVILLE

ERIE COUNTY, PENNSYLVANIA

SCALE: AS SHOWN	DATE: FEBRUARY, 1977
DRAWN BY: S.T.	APPROVED BY:
TRACED BY: WW. & M.R.	DRAWING NO. MB-26A
CHECKED BY: S.T.	


REVISED: JAN. 1999

HIGHWAY FEDERAL AID SHEET
PLATE 1-SINGLE PLAN AND PROFILE-FULL LINE
TELEDYNE
PRINTED IN U.S.A.

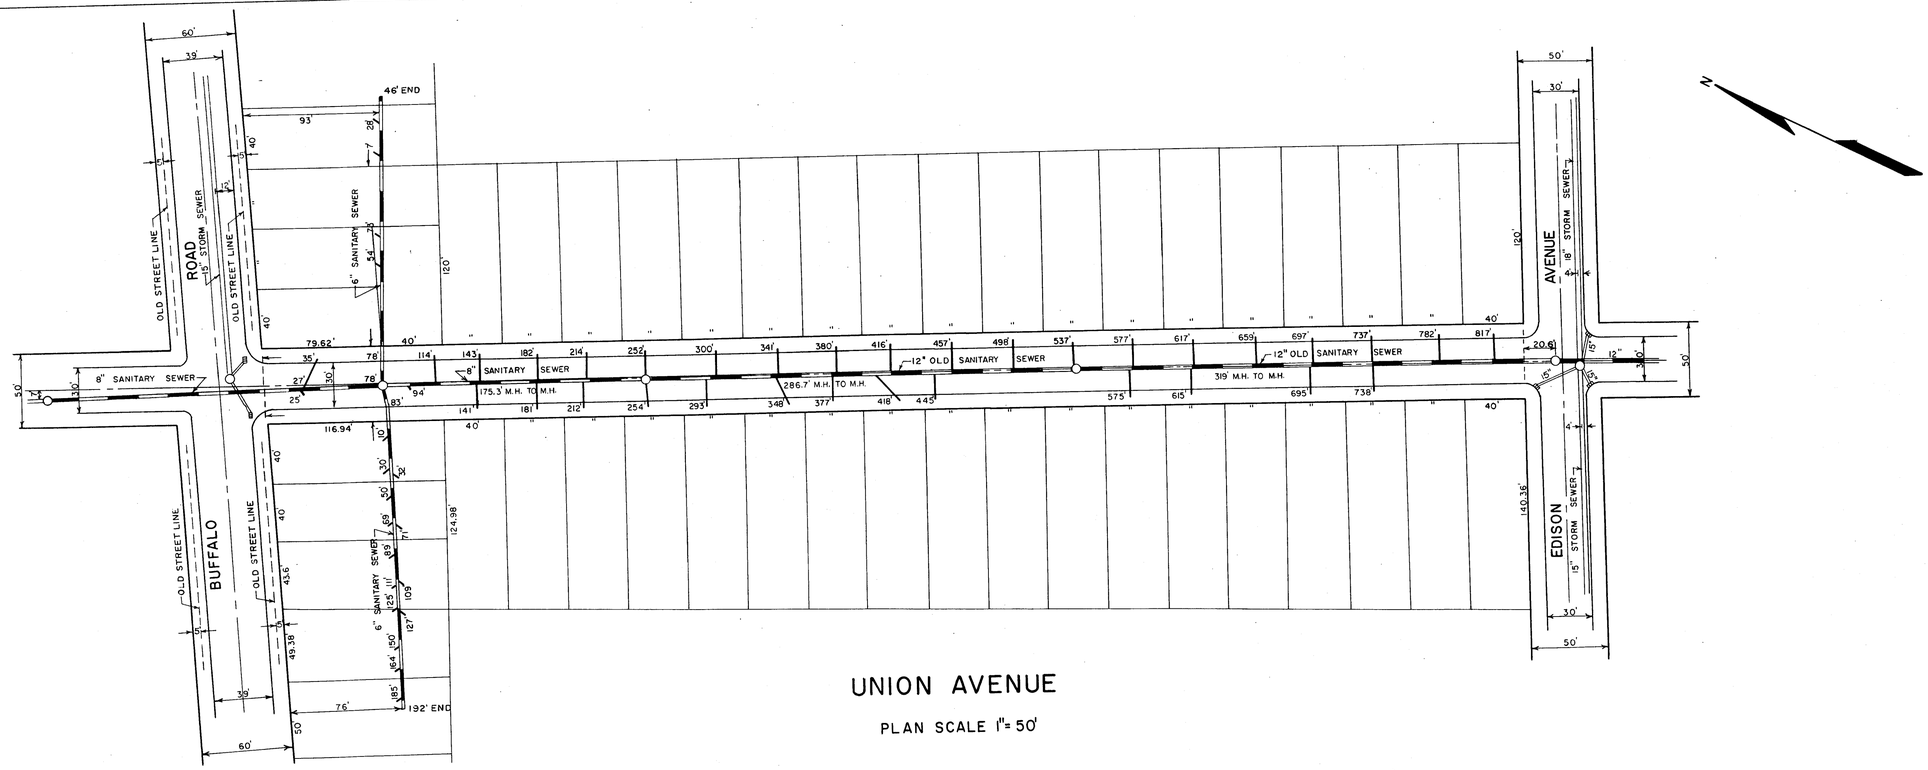

UNION AVENUE

PLAN SCALE 1"= 50'

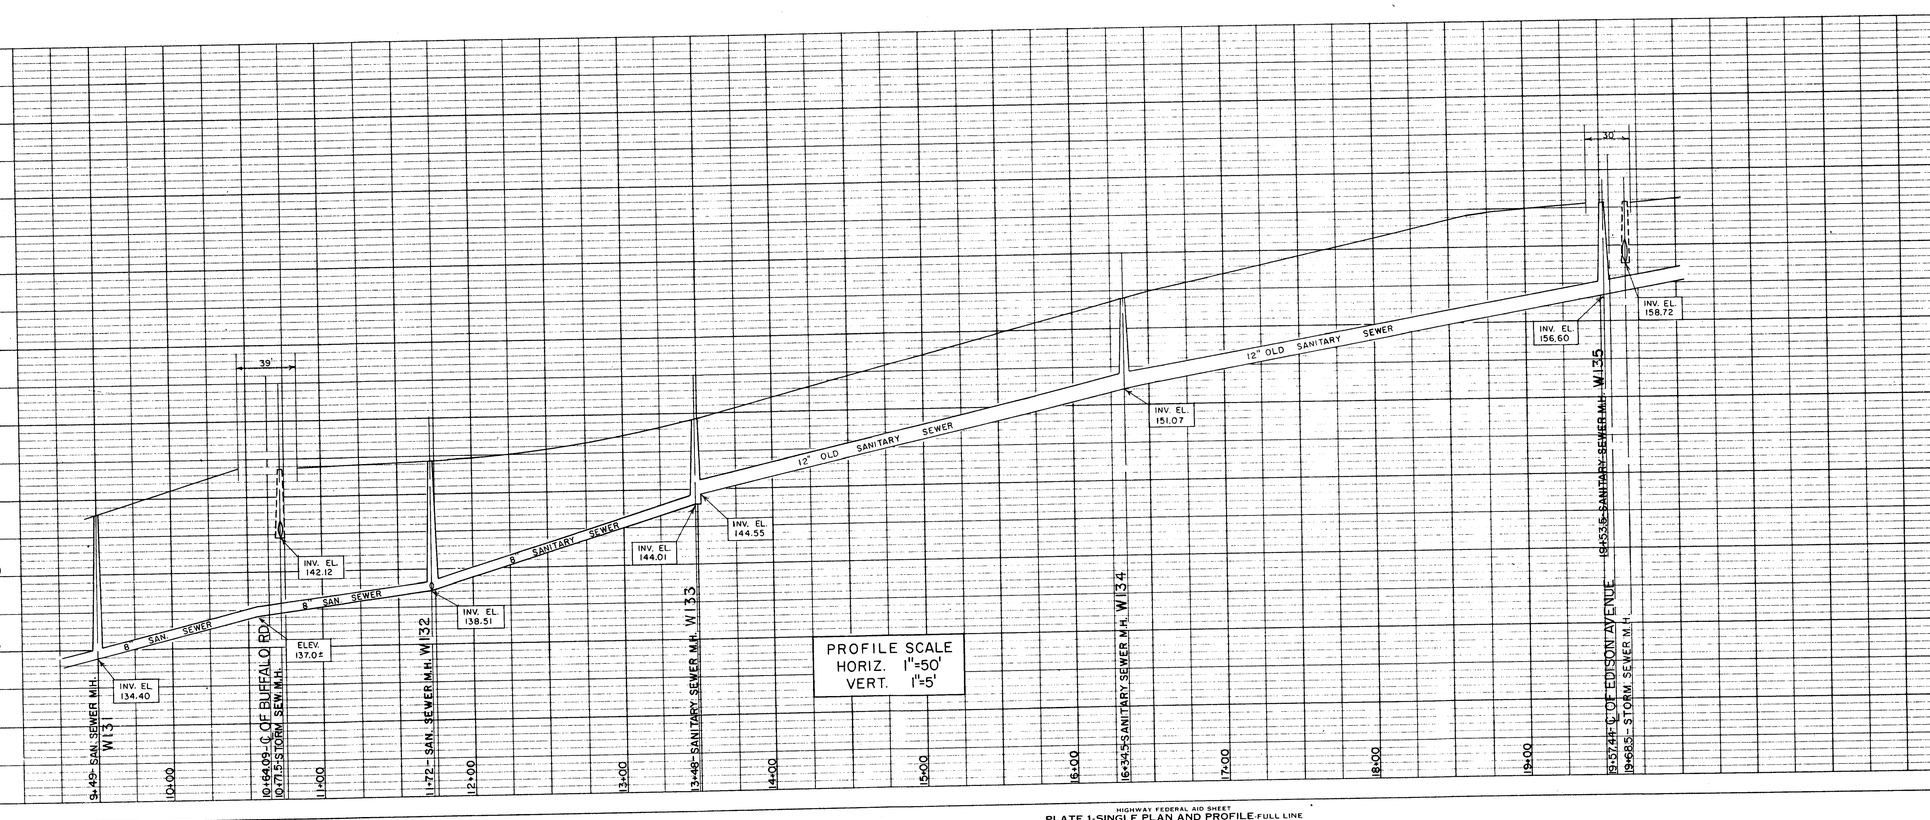

PROFILE SCALE
HORIZ. 1"=50'
VERT. 1"=5'

URBAN ENGINEERS, INC.

UNION AVENUE

SEWER MAP

SHEET NO. 2

BOROUGH OF WESLEYVILLE

ERIE COUNTY, PENNSYLVANIA

SCALE: AS SHOWN	DATE: JANUARY, 1977
DRAWN BY: S.T.	APPROVED BY:
TRACED BY: RAS	DRAWING NO. MB-26-B
CHECKED BY: S.T.	


REVISED: JAN. 1999

PLAN
SURVEYED
PLOTTED
NOTE BOOK
No.
ALIGNMENT CHECKED
RT. OF WAY CHECKED

PROFILE
SURVEYED
PLOTTED
GRADES CHECKED
B. M.'s NOTED
STRUCTURE LOCATIONS CHECKED
NOTE BOOK
No.


TELEDYNE
PRINTED IN U.S.A.

PLAN | SURVEYED | PLOTTED | NOTE BOOK | ALIGNMENT CHECKED | No. | RT. OF WAY CHECKED | STRUCTURE NOTATIONS CHECKED

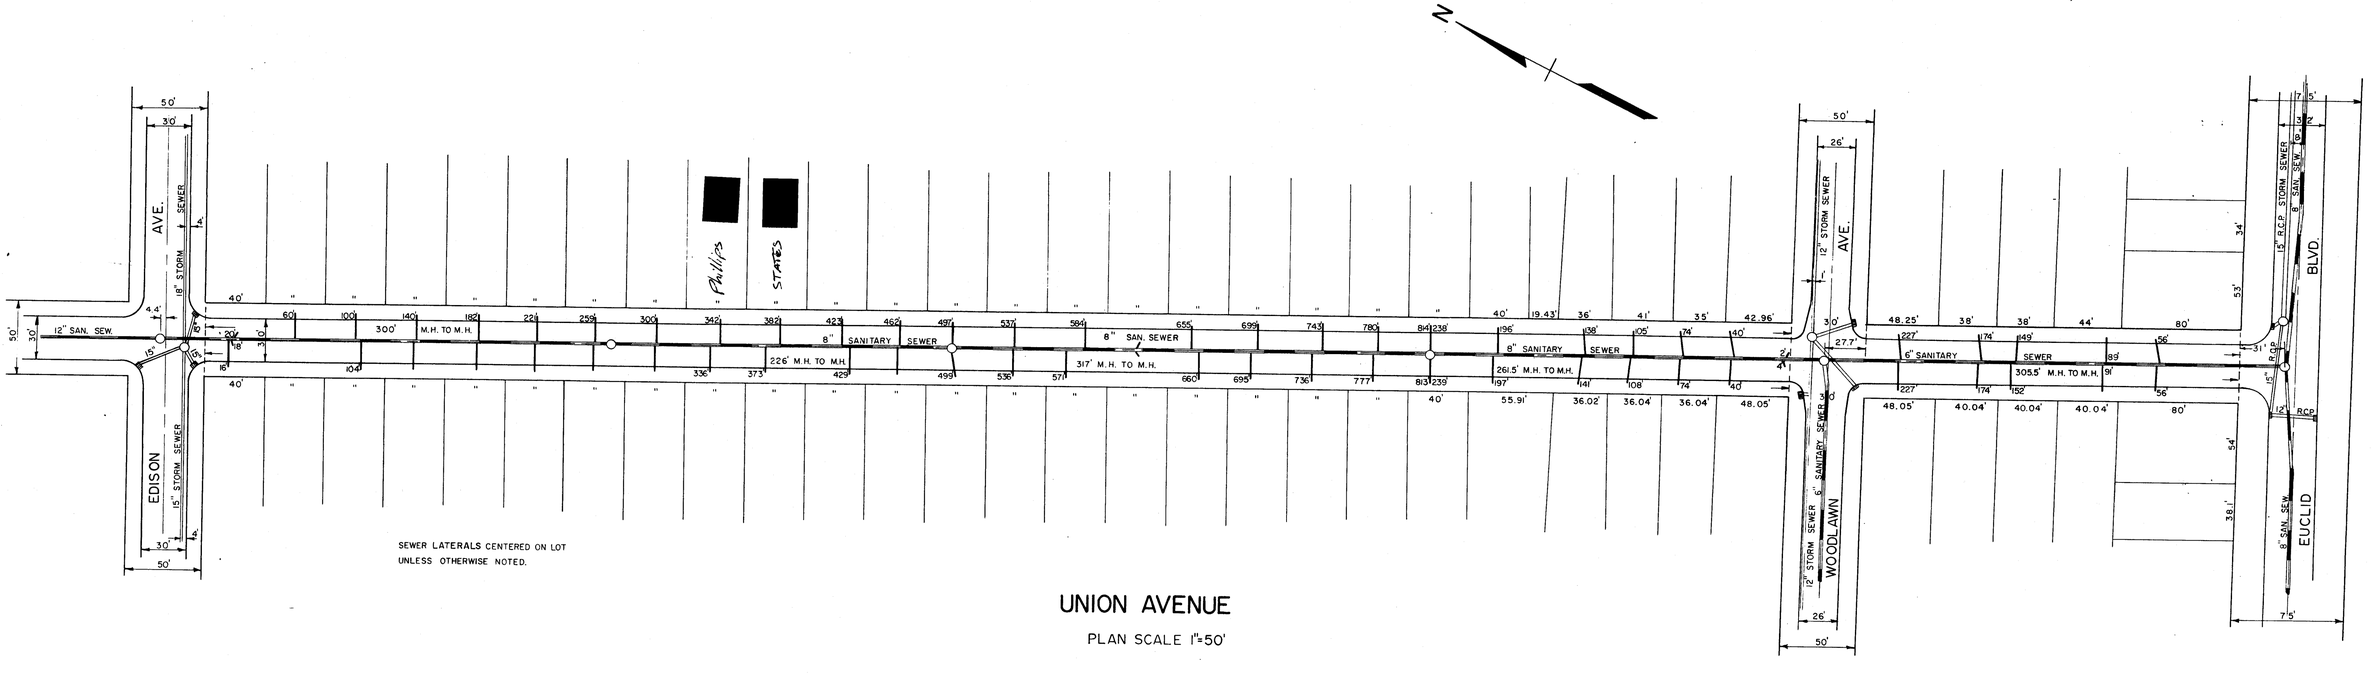

UNION AVENUE

PLAN SCALE 1"=50'

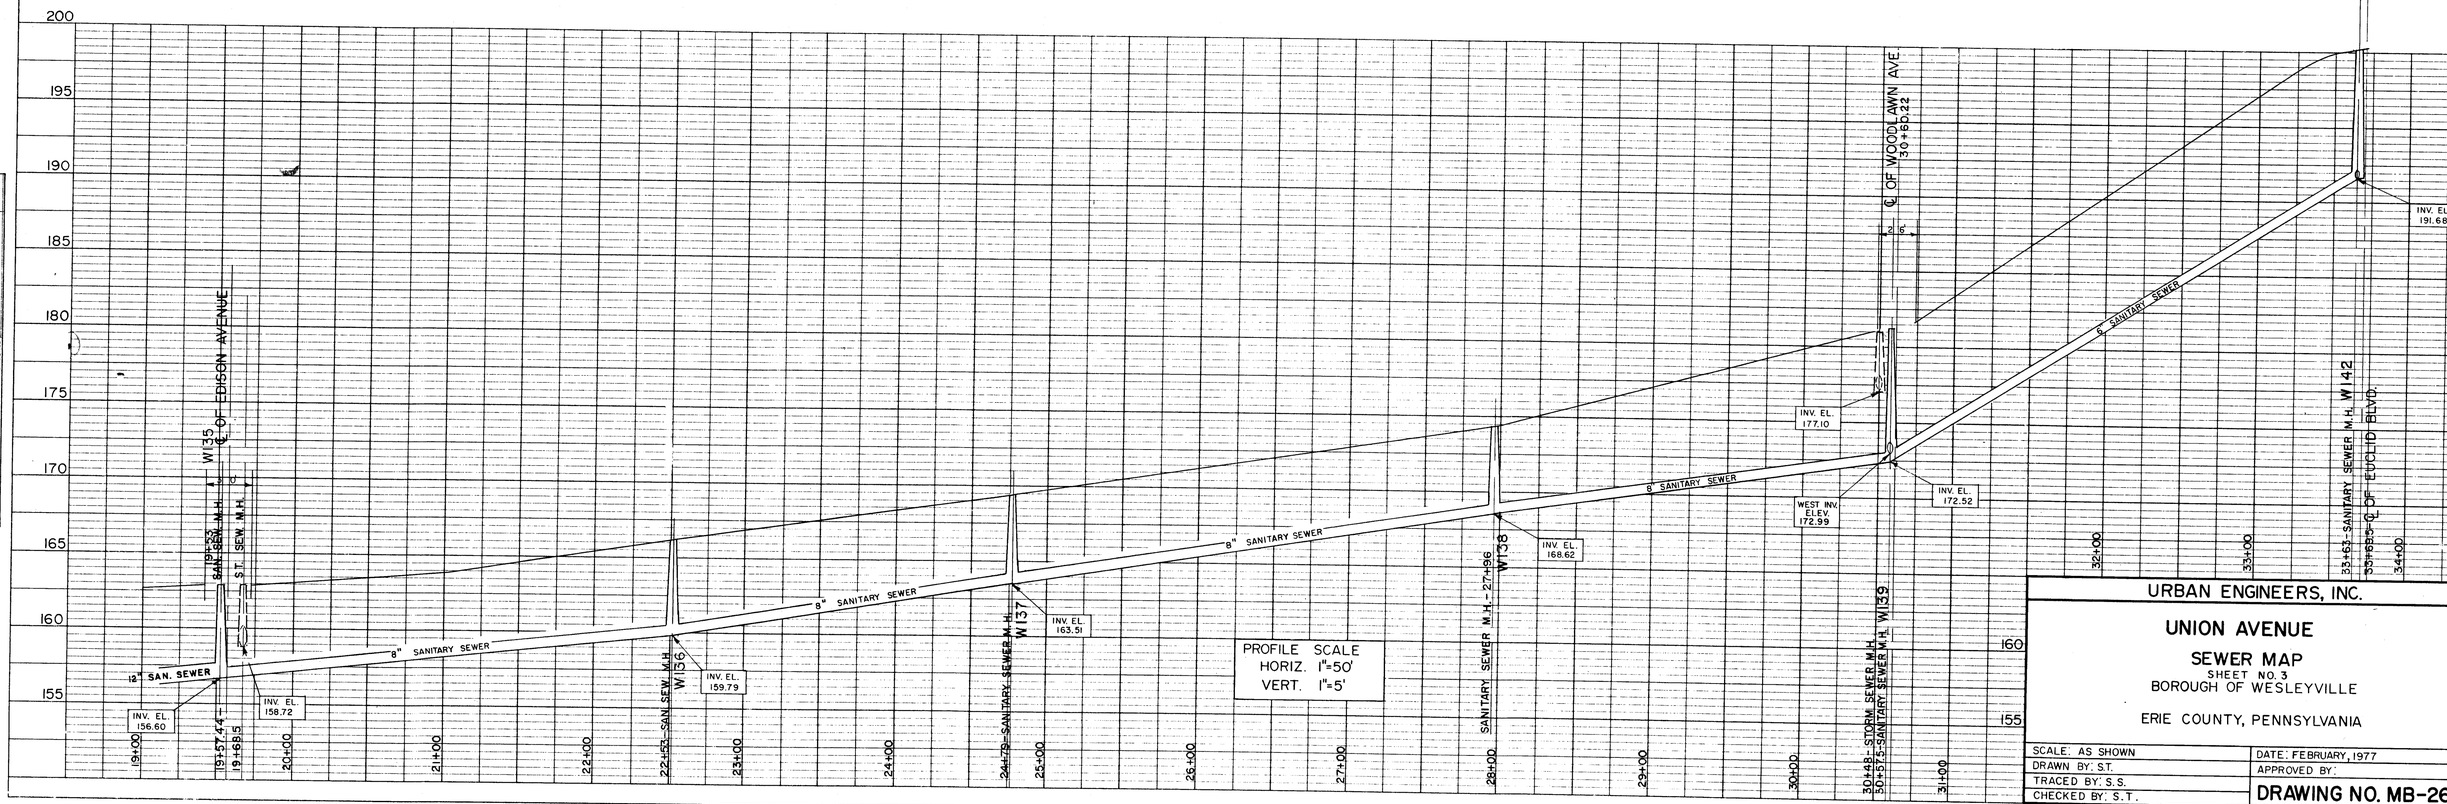

URBAN ENGINEERS, INC.


UNION AVENUE
SEWER MAP
SHEET NO. 3
BOROUGH OF WESLEYVILLE

ERIE COUNTY, PENNSYLVANIA

SCALE: AS SHOWN	DATE: FEBRUARY, 1977
DRAWN BY: S.T.	APPROVED BY:
TRACED BY: S.S.	DRAWING NO. MB-26-C
CHECKED BY: S.T.	


REVISED: JAN. 1999

NOTE BOOK | PLOTTED | CHARTS CHECKED | No. | STRUCTURE NOTATIONS CHECKED

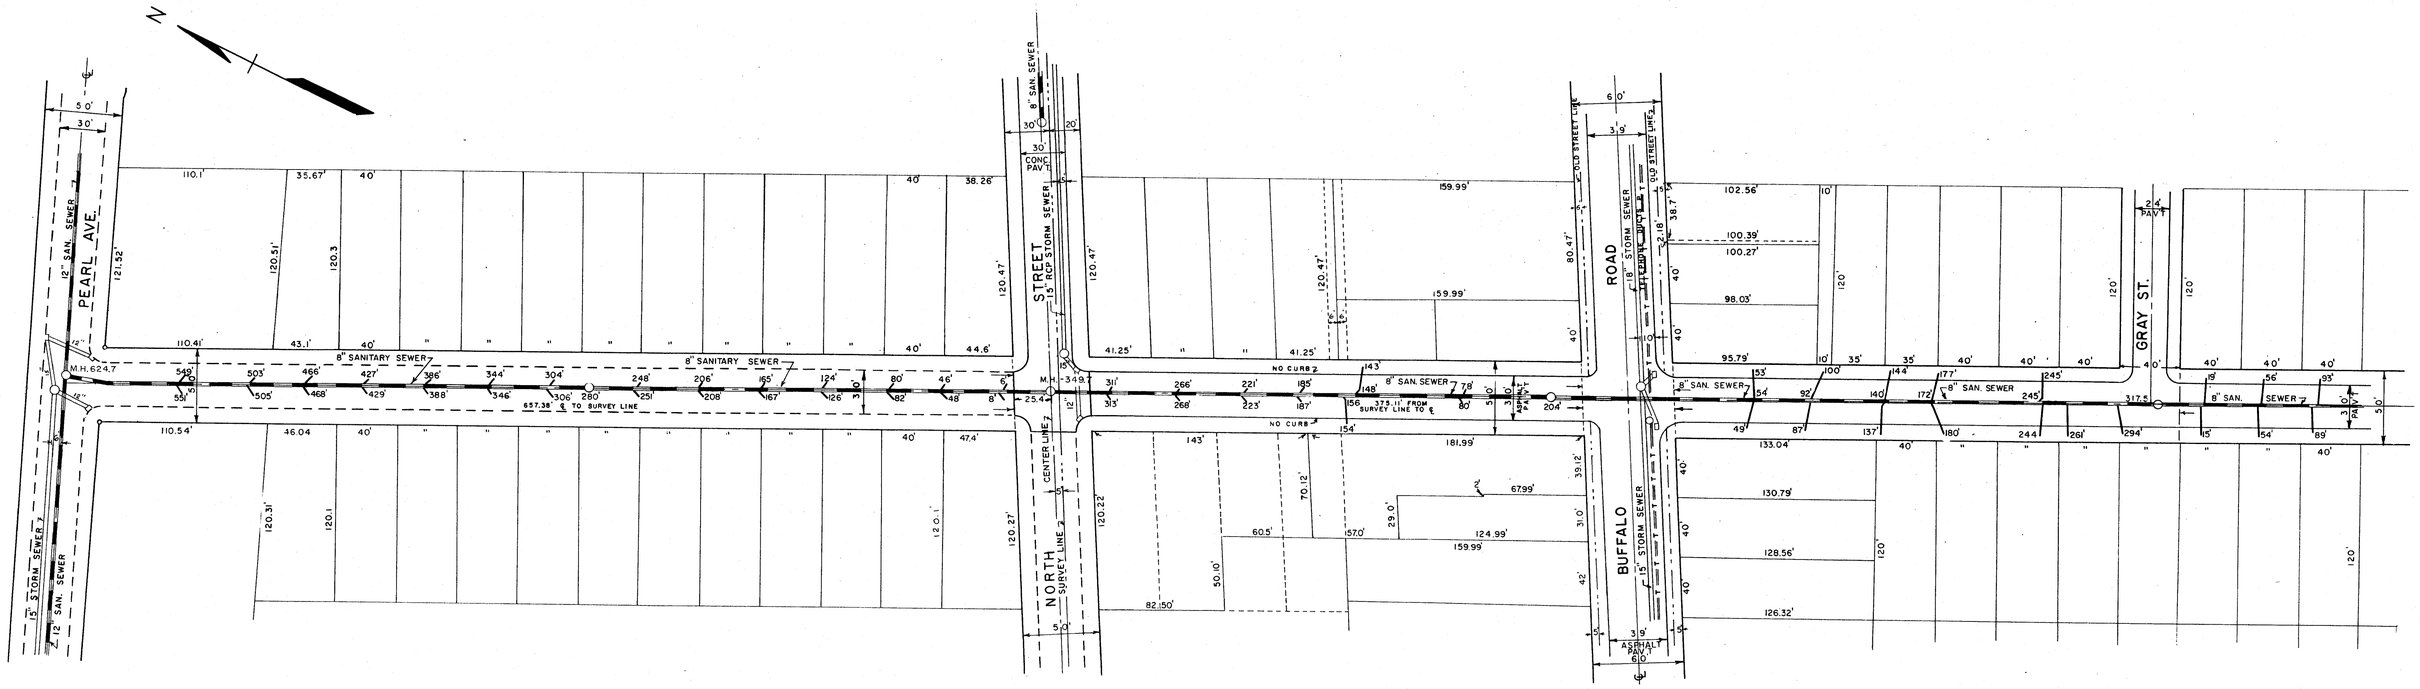

EASTERN AVENUE

PLAN SCALE 1" = 50'

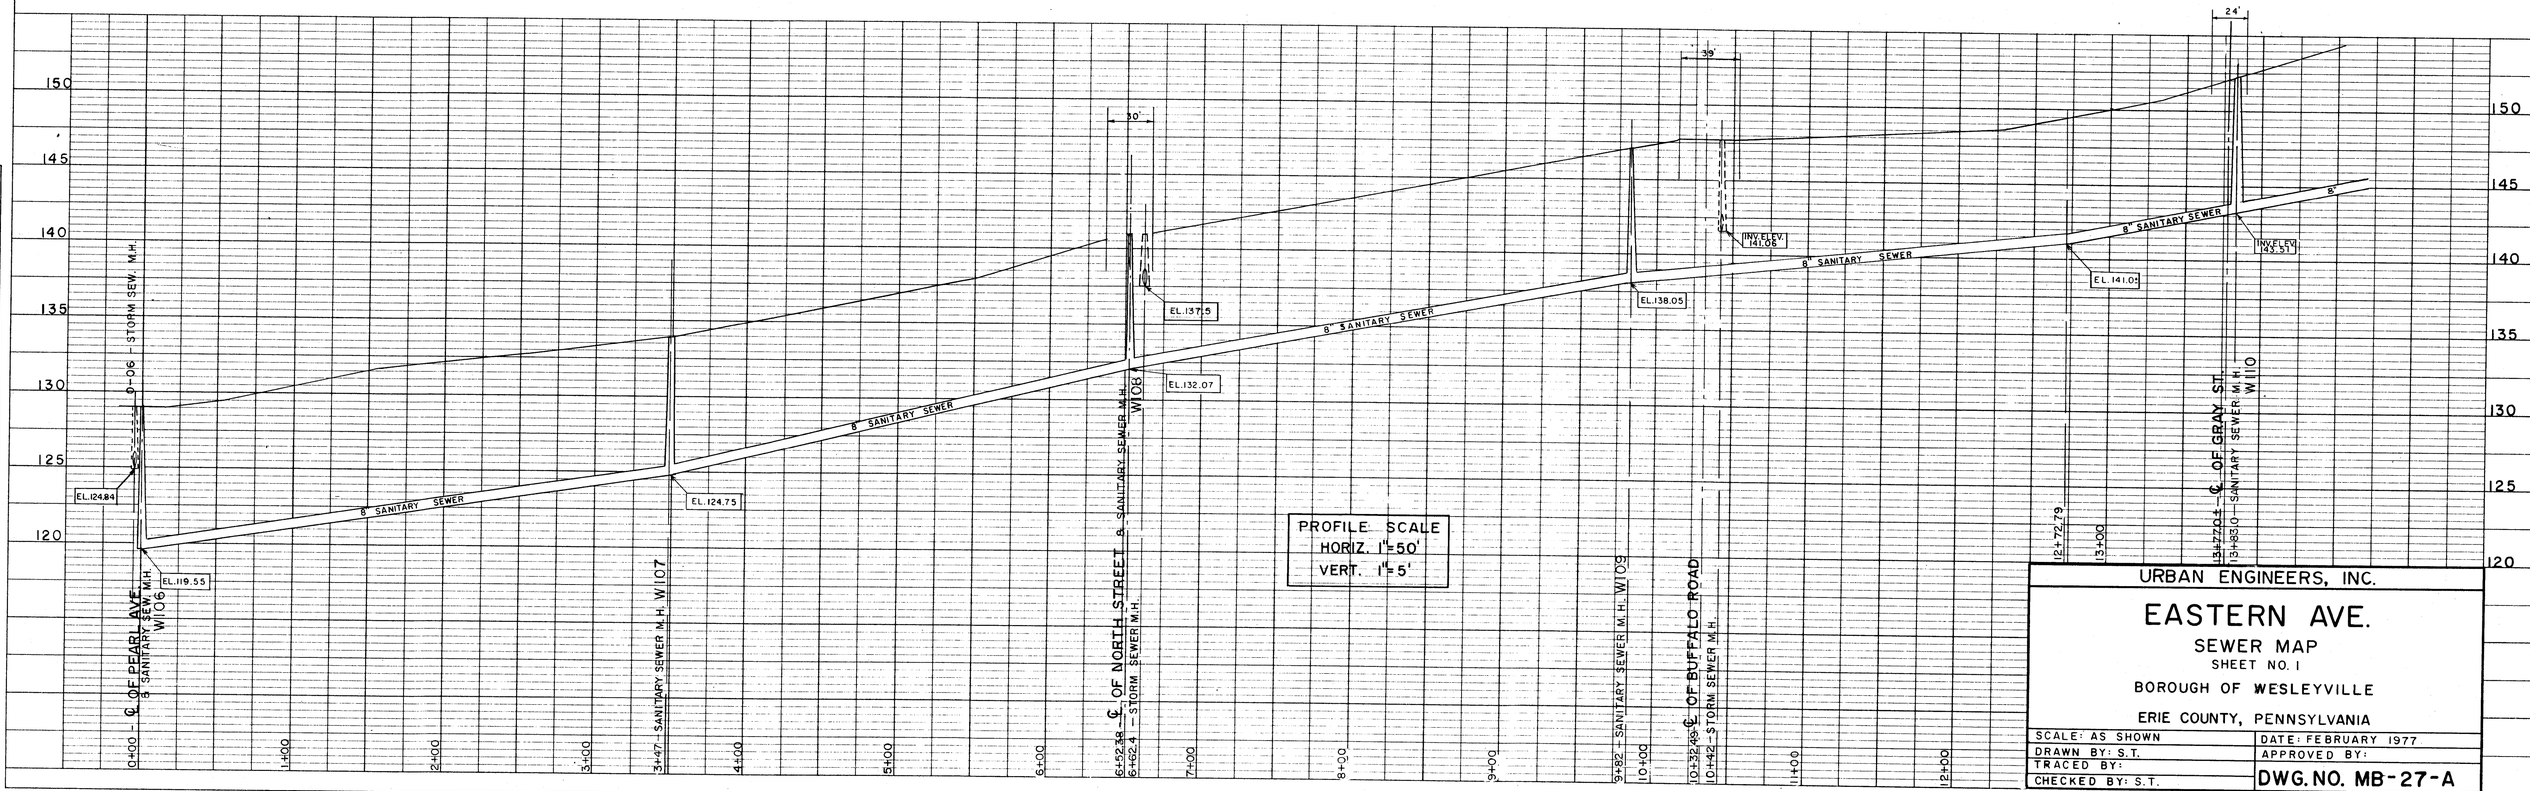

URBAN ENGINEERS, INC.

EASTERN AVE.

SEWER MAP

SHEET NO. 1

BOROUGH OF WESLEYVILLE


ERIE COUNTY, PENNSYLVANIA


SCALE: AS SHOWN	DATE: FEBRUARY 1977
DRAWN BY: S.T.	APPROVED BY:
TRACED BY:	
CHECKED BY: S.T.	DWG. NO. MB-27-A

REVISED: JAN. 1999

PLAN: SURVEYED ___ PLOTTED ___ NOTE BOOK ___ No. ___ ALIGNMENT CHECKED ___ RT. OF WAY CHECKED ___

PROFILE: PLOTTED ___ GRADES CHECKED ___ & ALL NOTED ___ STRUCTURE NOTATIONS CHECKED ___

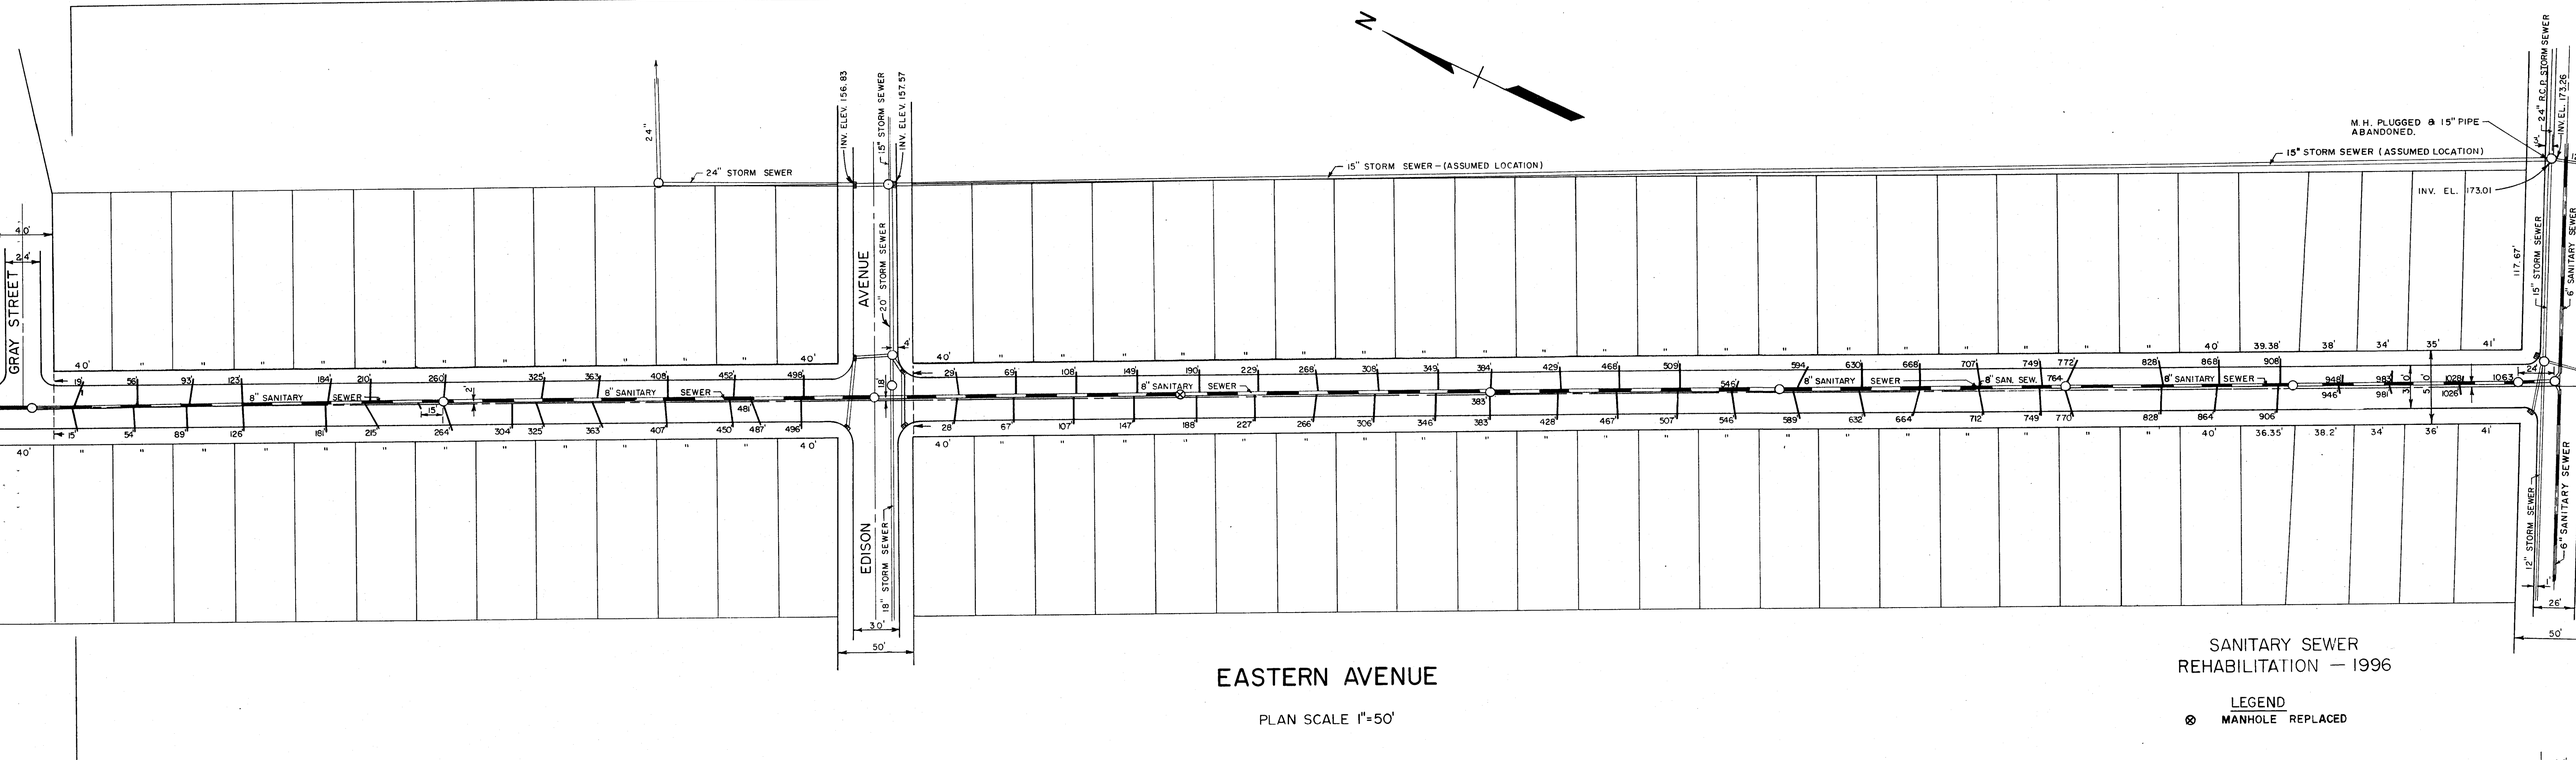

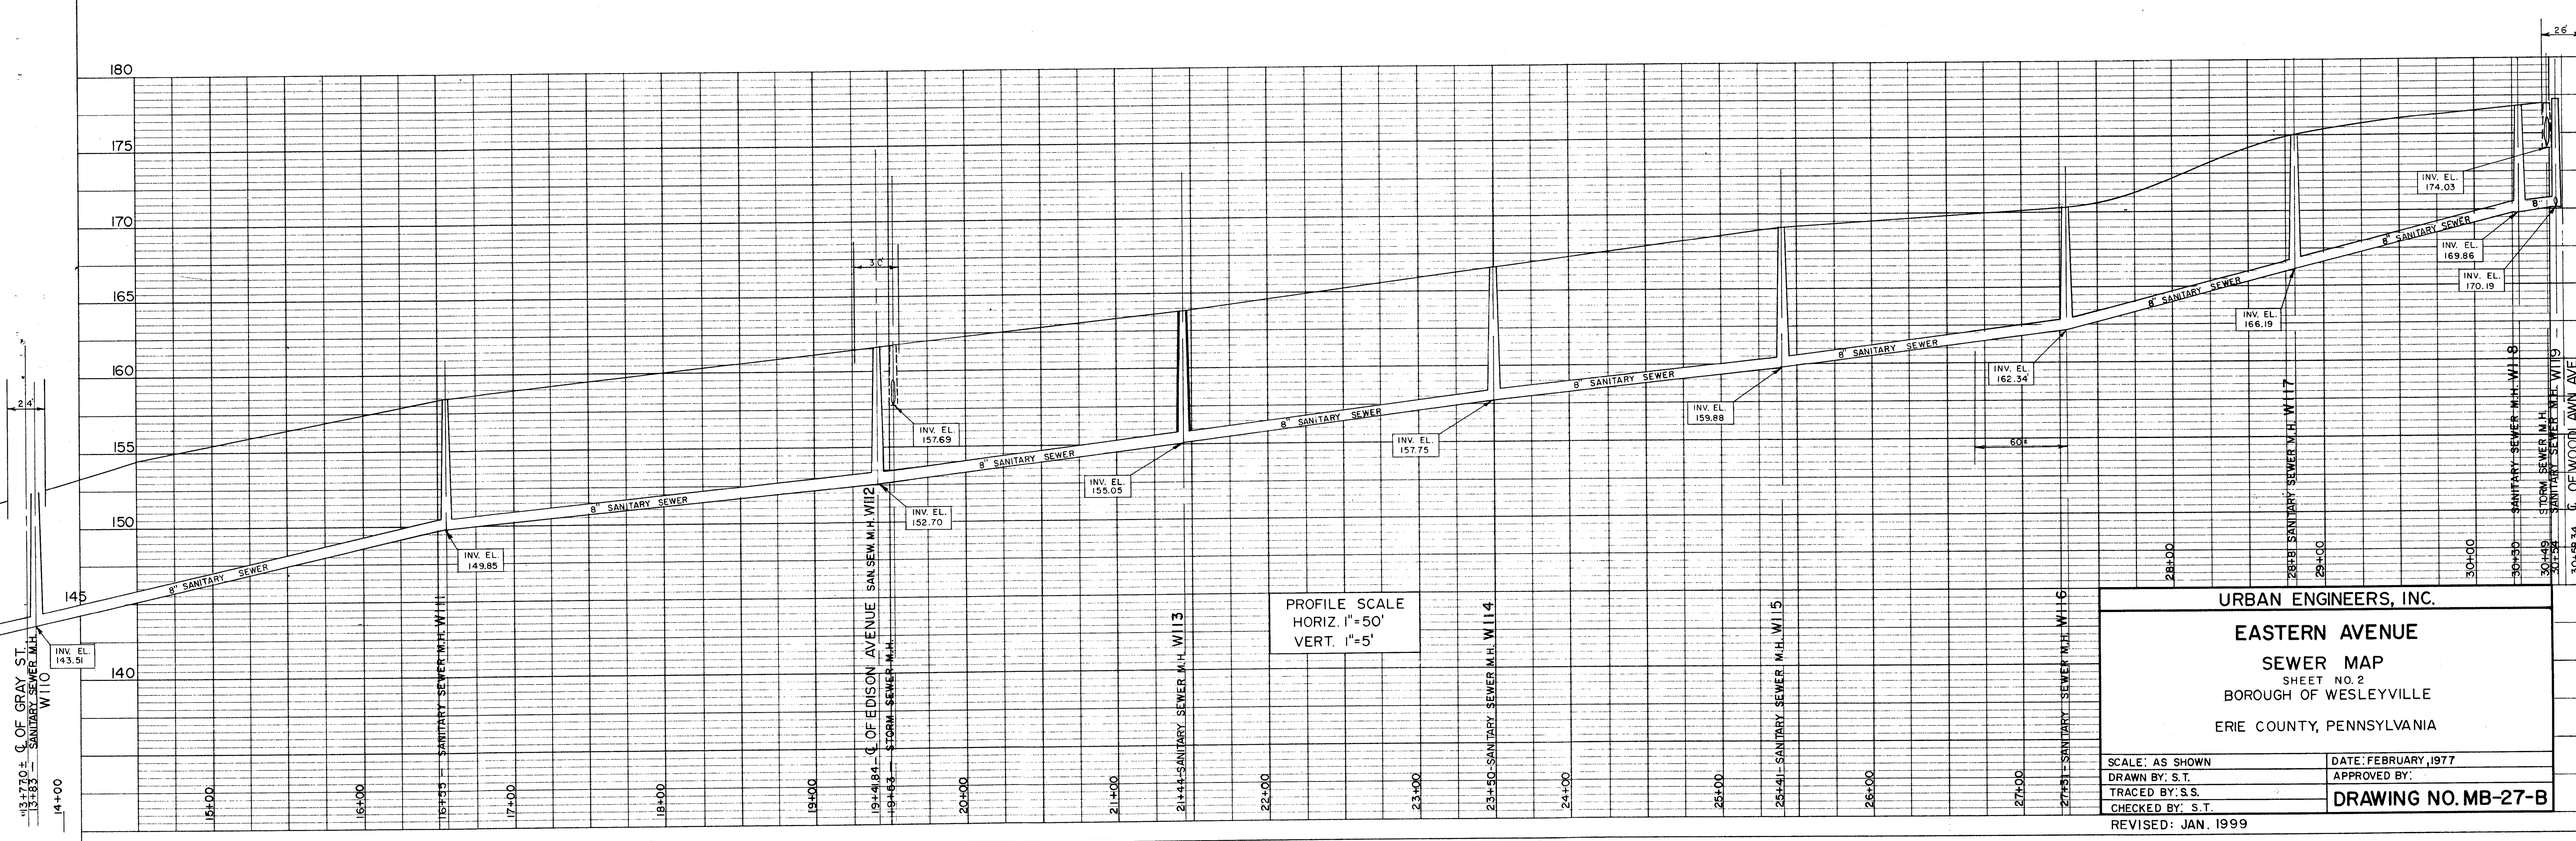

PROFILE SCALE
HORIZ. 1"=50'
VERT. 1"=5'

URBAN ENGINEERS, INC.

EASTERN AVENUE

SEWER MAP

SHEET NO. 2
BOROUGH OF WESLEYVILLE

ERIE COUNTY, PENNSYLVANIA

SCALE: AS SHOWN	DATE: FEBRUARY, 1977
DRAWN BY: S.T.	APPROVED BY:
TRACED BY: S.S.	DRAWING NO. MB-27-B
CHECKED BY: S.T.	

REVISED: JAN. 1999

HIGHWAY FEDERAL AID SHEET
PLATE 1-SINGLE PLAN AND PROFILE-FULL LINE
TH ISLEDYNE
PRINTED IN U.S.A.

PLAN
NOTE BOOK
No.
PLOTTED
ALIGNMENT CHECKED
R.O.W. NOTED
STREAM NOTATIONS CHECKED
GRADES CHECKED

SANITARY SEWER REHABILITATION — 1996


ALL DISTANCES MEASURED FROM CENTER OF NOTED MANHOLE OR RIGHT OF WAY LINE.

LEGEND

△ REPLACED LATERAL WYE

⊗ REPLACED MANHOLE


NOTE: REPLACED EXISTING 6 VCP WITH 8" PVC PIPE MH W90 TO W91.

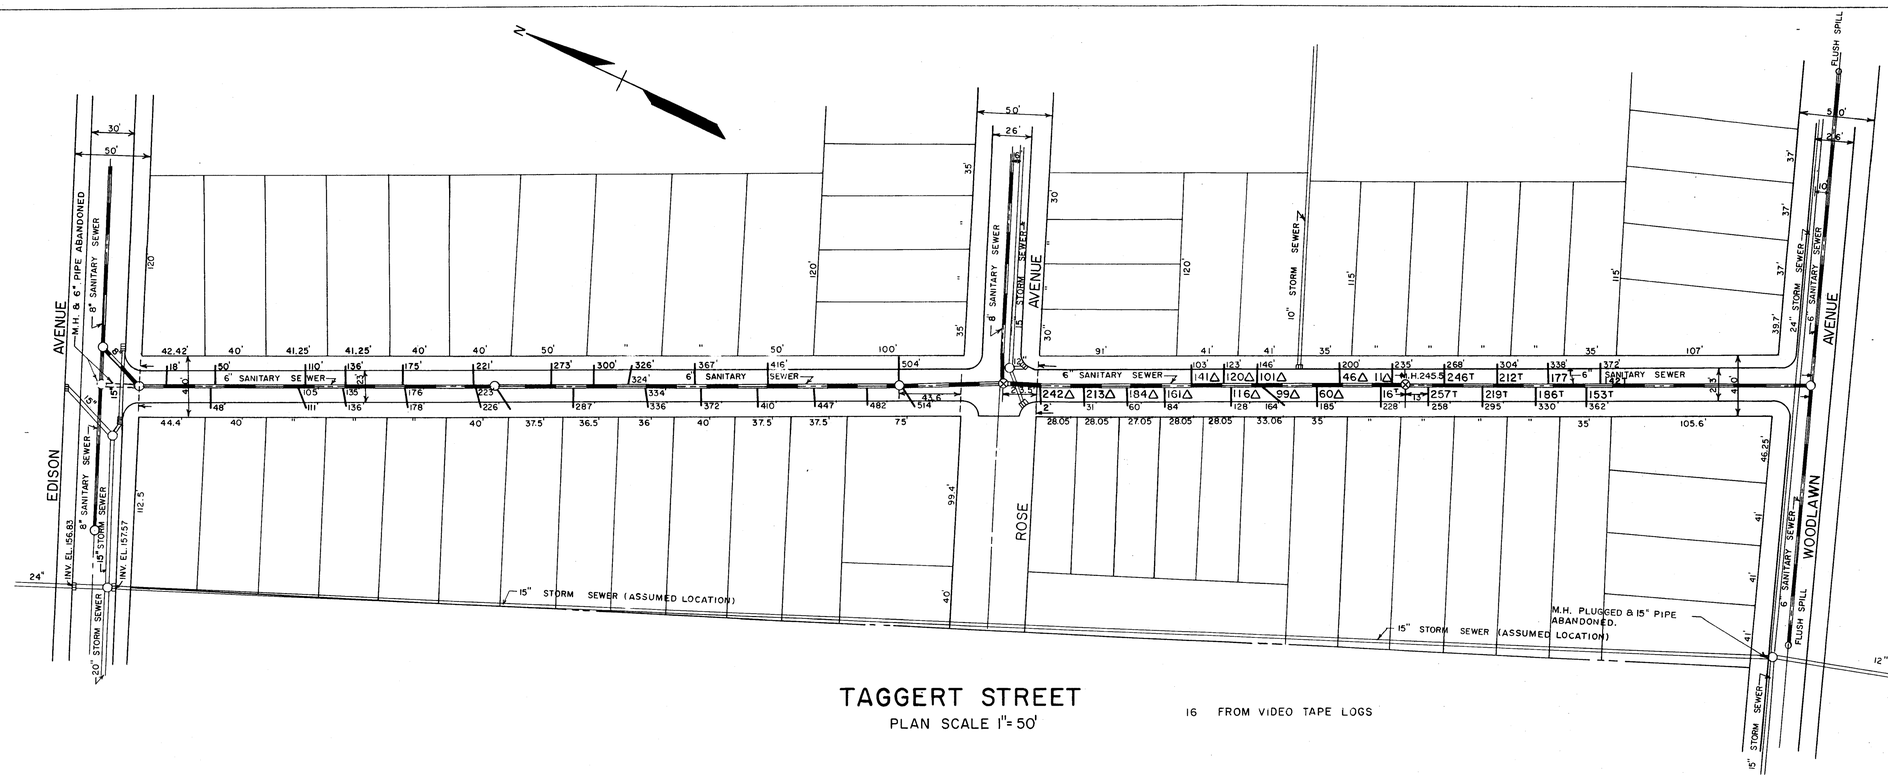

TAGGERT STREET

PLAN SCALE 1"= 50'

16 FROM VIDEO TAPE LOGS

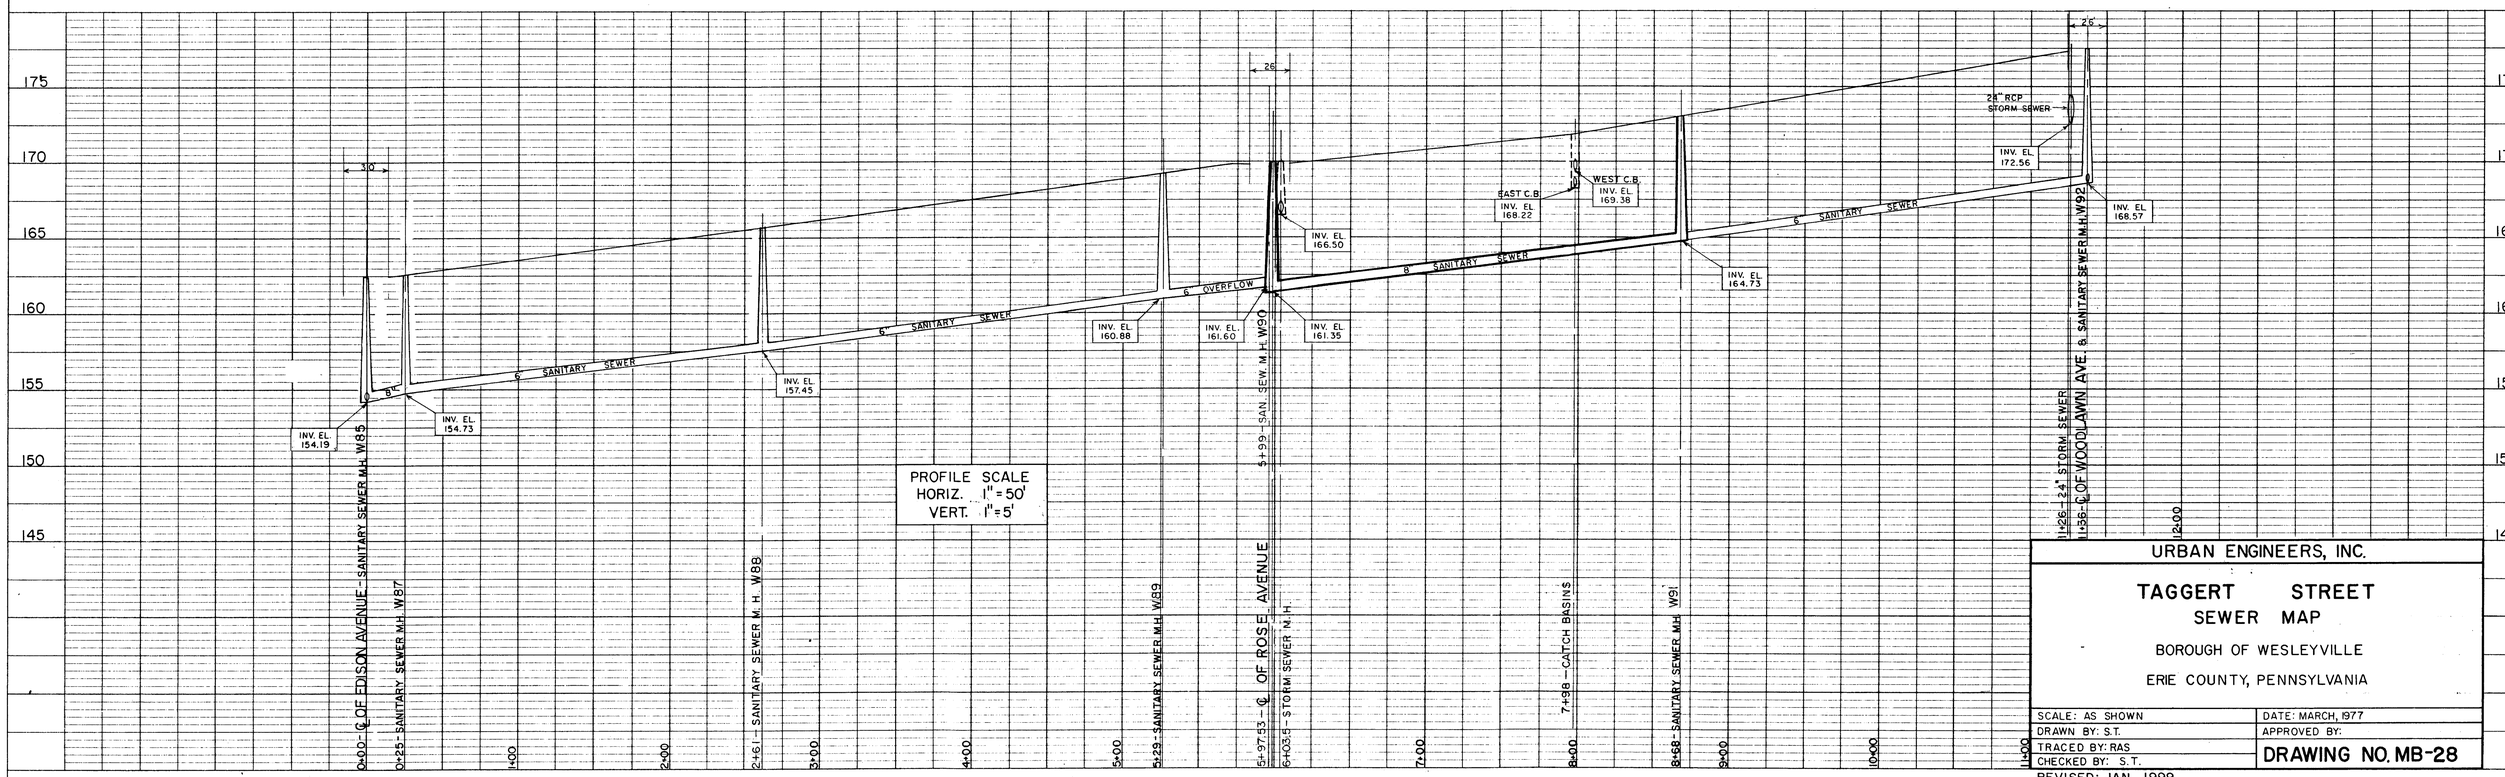

URBAN ENGINEERS, INC.

TAGGERT STREET
SEWER MAP

BOROUGH OF WESLEYVILLE

ERIE COUNTY, PENNSYLVANIA

SCALE: AS SHOWN	DATE: MARCH, 1977
DRAWN BY: S.T.	APPROVED BY:
TRACED BY: RAS	DRAWING NO. MB-28
CHECKED BY: S.T.	

REVISED: JAN. 1999

PLAN
SURVEYED
PLOTTED
NOTE BOOK ALIGNMENT CHECKED
No. PLAN CHECKED

PROFILE
SURVEYED
PLOTTED
NOTE BOOK GRADES CHECKED
No. STRUCTURE NOTATIONS CHECKED
DATE

N

BUFFALO ROAD

GRAY STREET

FREMONT STREET

SKELLIE AVENUE

EDISON AVENUE

ROSE AVENUE

WILLOW STREET

PLAN SCALE 1" = 50'

SANITARY SEWER REHABILITATION — 1996

ALL DISTANCES MEASURED FROM CENTER OF NOTED MANHOLE

MH W79

A) MH W79 — 62' (60')

B) 202' — 226' (24')

LEGEND

△ REPLACE LATERAL WYE

⊗ REPLACE MANHOLE

T LATERAL CAPPED AT CURB

13T — FROM VIDEO TAPE LOGS

30S — SCALED FROM RECORD DRAWINGS

PROFILE SCALE
HORIZ. 1" = 50'
VERT. 1" = 5'


URBAN ENGINEERS, INC.


WILLOW STREET
SEWER MAP
SHEET NO. 1
BOROUGH OF WESLEYVILLE
ERIE COUNTY, PENNSYLVANIA

SCALE: AS SHOWN	DATE: MAY, 1977
DRAWN BY: S.T.	APPROVED BY:
TRACED BY: R.B.	DRAWING NO. MB-29-A
CHECKED BY: S.T.	

REVISED: JAN. 1999

HIGHWAY FEDERAL AID SHEET
PLATE 1-SINGLE PLAN AND PROFILE-FULL LINE
TELEDYNE
PRINTED IN U.S.A.

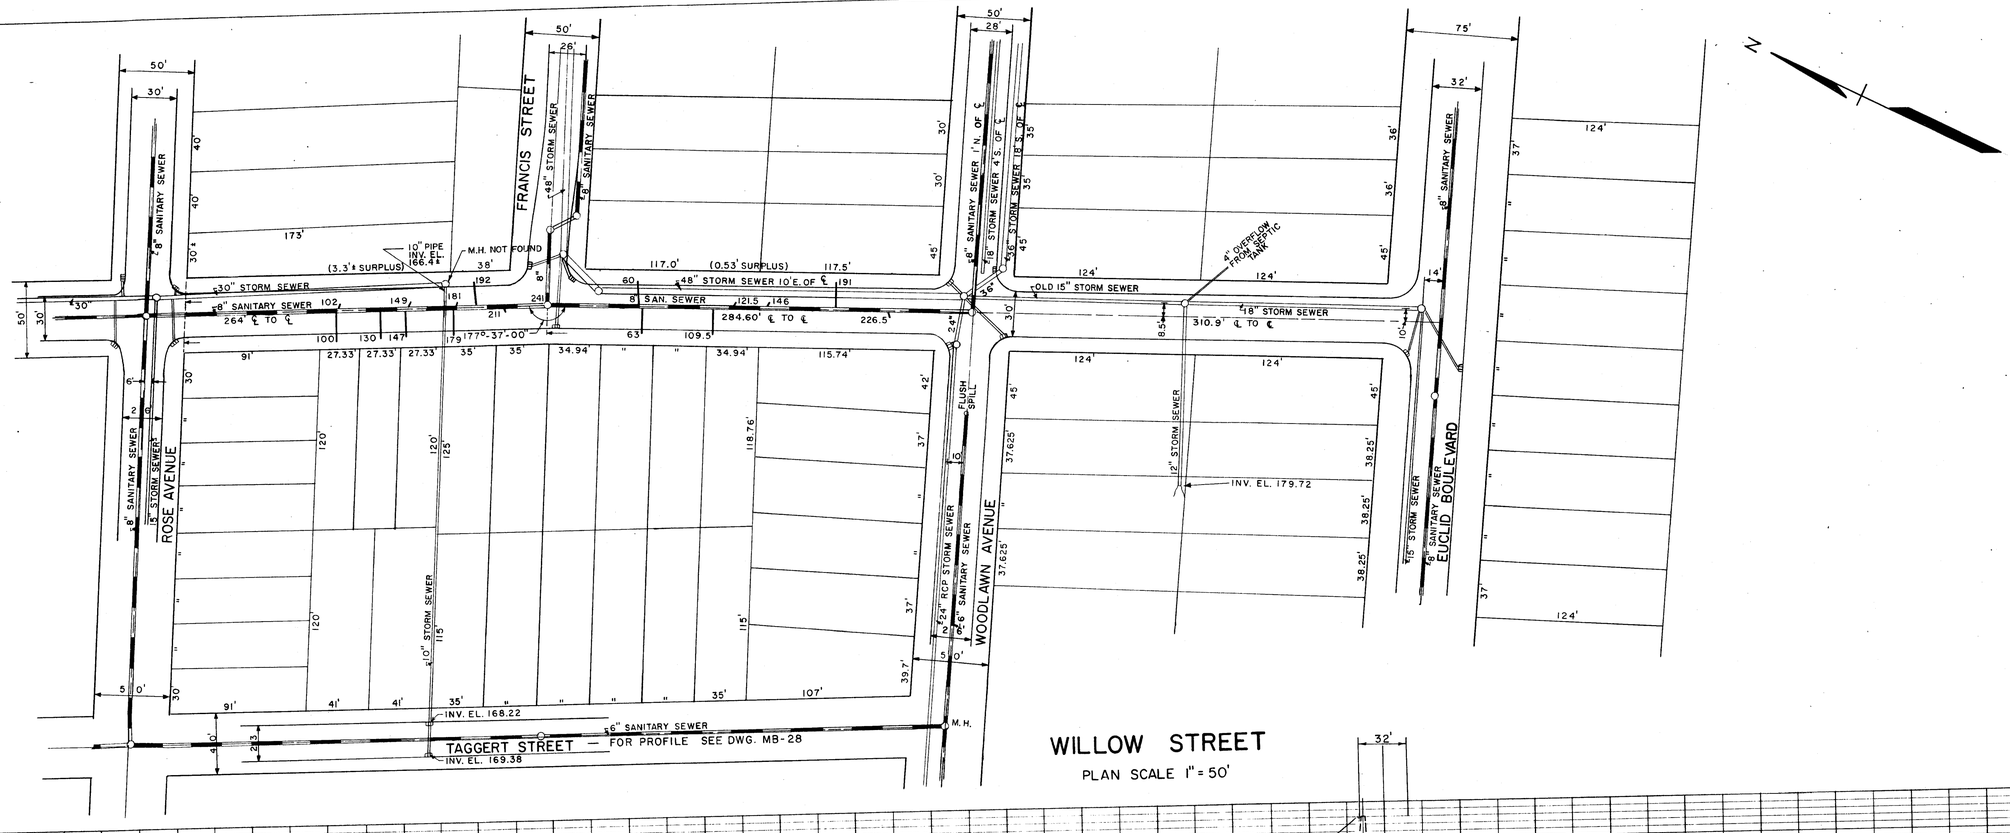

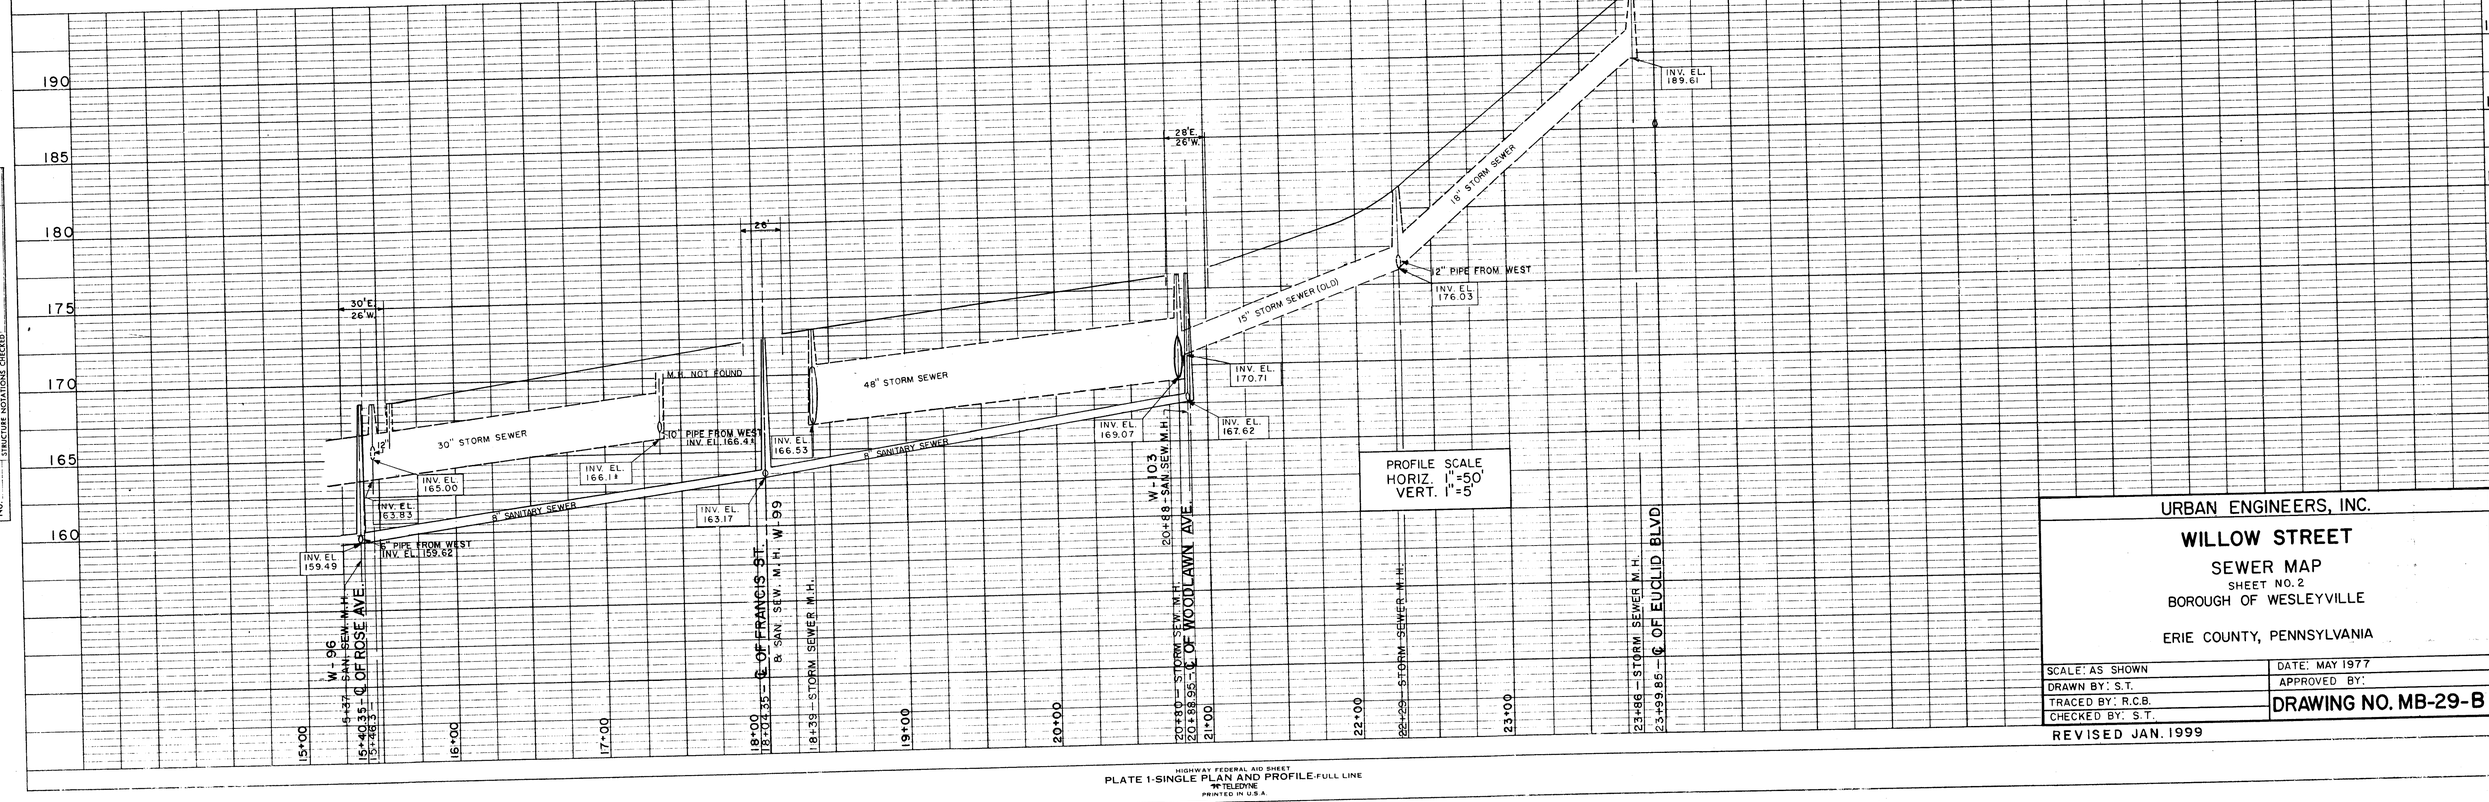

PROFILE SCALE
HORIZ. 1"=50'
VERT. 1"=5'

URBAN ENGINEERS, INC.

WILLOW STREET

SEWER MAP

SHEET NO. 2

BOROUGH OF WESLEYVILLE

ERIE COUNTY, PENNSYLVANIA

SCALE: AS SHOWN	DATE: MAY 1977
DRAWN BY: S.T.	APPROVED BY:
TRACED BY: R.C.B.	DRAWING NO. MB-29-B
CHECKED BY: S.T.	


REVISED JAN. 1999

PLAN — SURVEYED, PLOTTED, NOTE BOOK, No., ALIGNMENT CHECKED, GRADES CHECKED, R. M.'s NOTED, RT. OF WAY CHECKED, BY, DATE

PROFILE — SURVEYED, PLOTTED, NOTE BOOK, No., GRADES CHECKED, R. M.'s NOTED, STRUCTURE NOTATIONS CHECKED, BY, DATE


SANITARY SEWER REHABILITATION – 1996

ALL DISTANCES MEASURED FROM CENTER NOTED MANHOLE OR RIGHT OF WAY LINE.

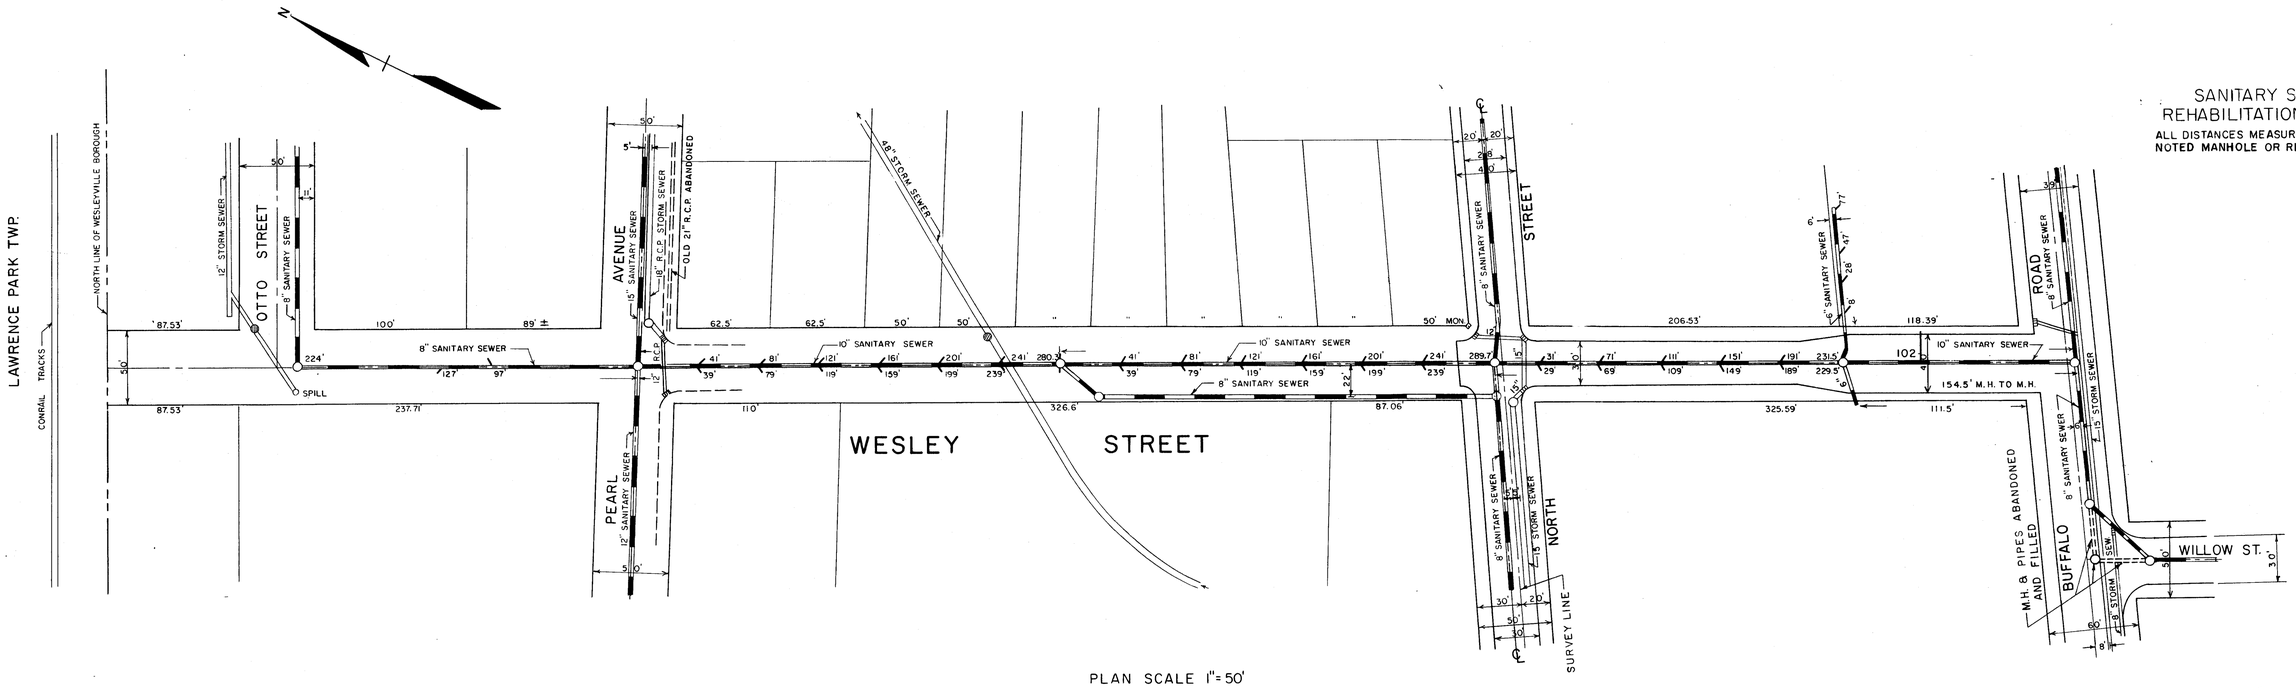

PLAN SCALE 1"=50'

NOTE : REPLACED EXISTING 10" VCP WITH 10" PVC PIPE MH W57 TO W58.

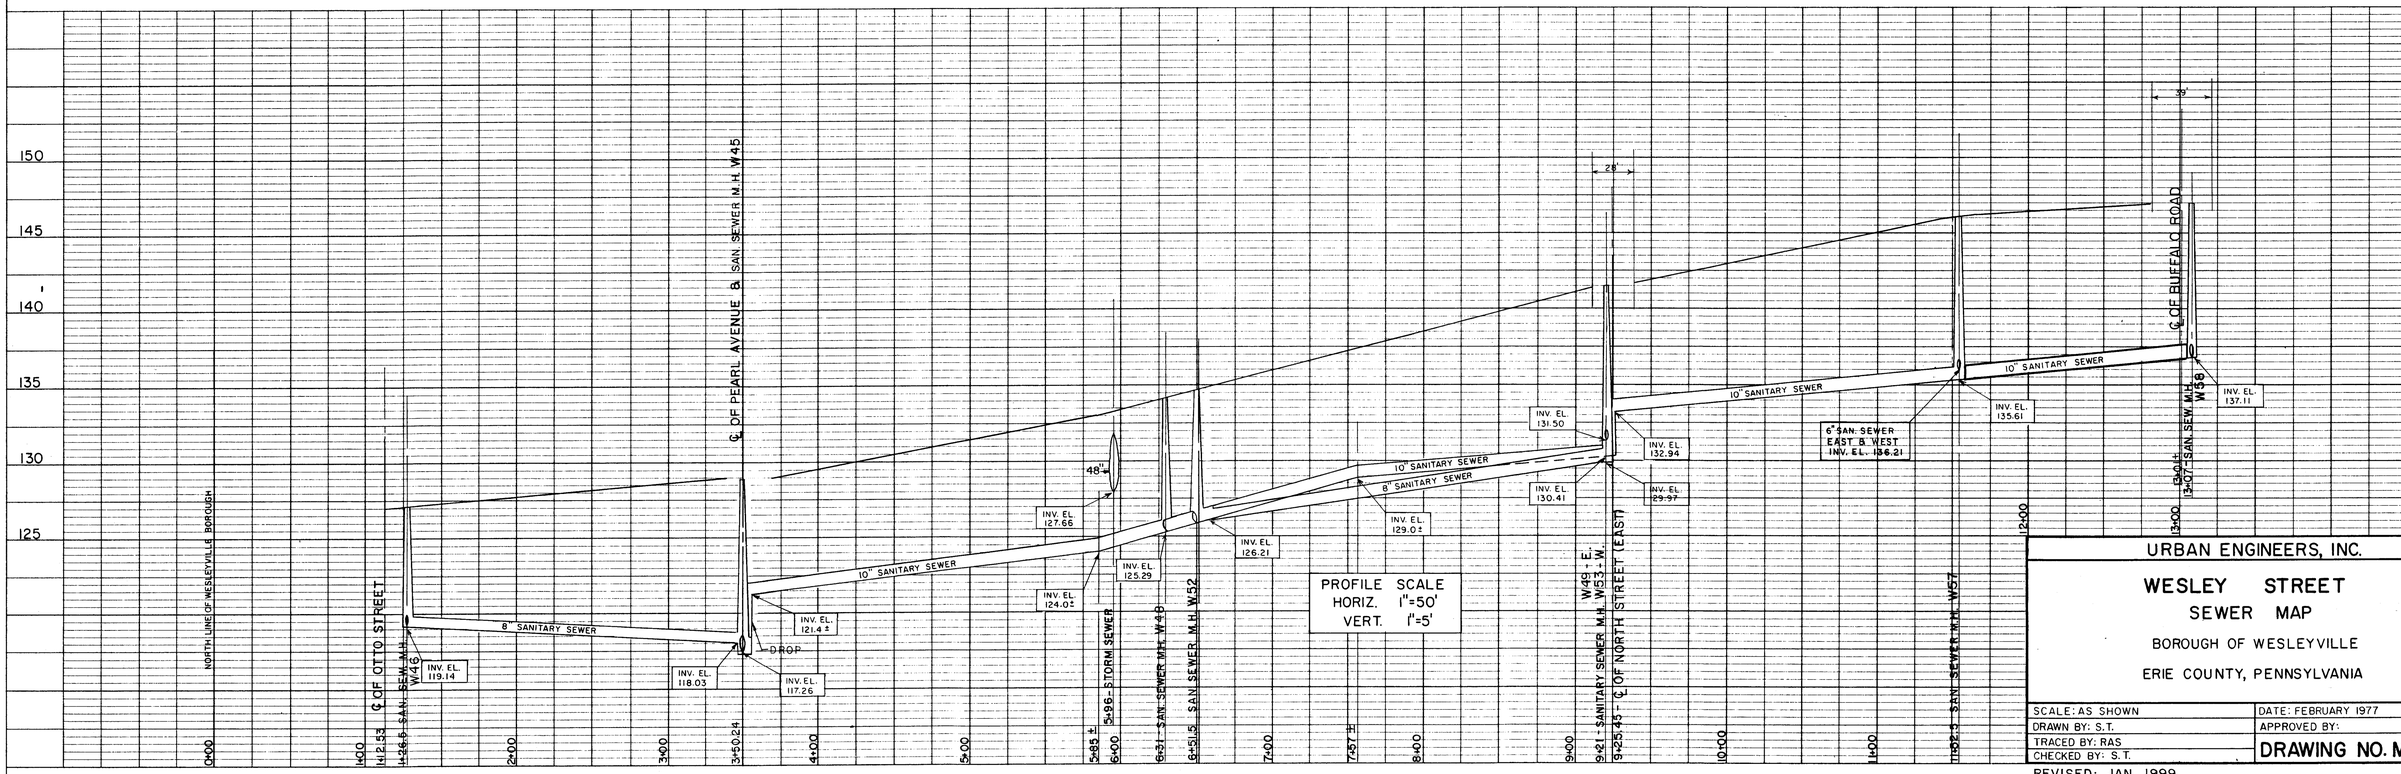

PROFILE SCALE
HORIZ. 1"=50'
VERT. 1"=5'

URBAN ENGINEERS, INC.	
WESLEY STREET SEWER MAP	
BOROUGH OF WESLEYVILLE	
ERIE COUNTY, PENNSYLVANIA	
SCALE: AS SHOWN	DATE: FEBRUARY 1977
DRAWN BY: S.T.	APPROVED BY:
TRACED BY: RAS	DRAWING NO. MB-30
CHECKED BY: S.T.	

REVISED: JAN. 1999


PLAN — SURVEYED, PLOTTED, NOTE BOOK, No., ALIGNMENT CHECKED, RT. OF WAY CHECKED, BY, DATE


PROFILE — SURVEYED, PLOTTED, GRADES CHECKED, R. R.'S NOTED, STRUCTURE NOTATIONS CHECKED, BY, DATE

HIGHWAY FEDERAL AID SHEET
PLATE 1-SINGLE PLAN AND PROFILE-FULL LINE
TELEDYNE
PRINTED IN U.S.A.

PLAN
SURVEYED
PLOTTED
NOTE BOOK
No.
ALIGNMENT CHECKED
RT. OF WAY CHECKED
DATE
BY

PROFILE
SURVEYED
PLOTTED
NOTE BOOK
No.
GRADES CHECKED
R.A.'s NOTED
STRUCTURE NOTATIONS CHECKED
DATE
BY

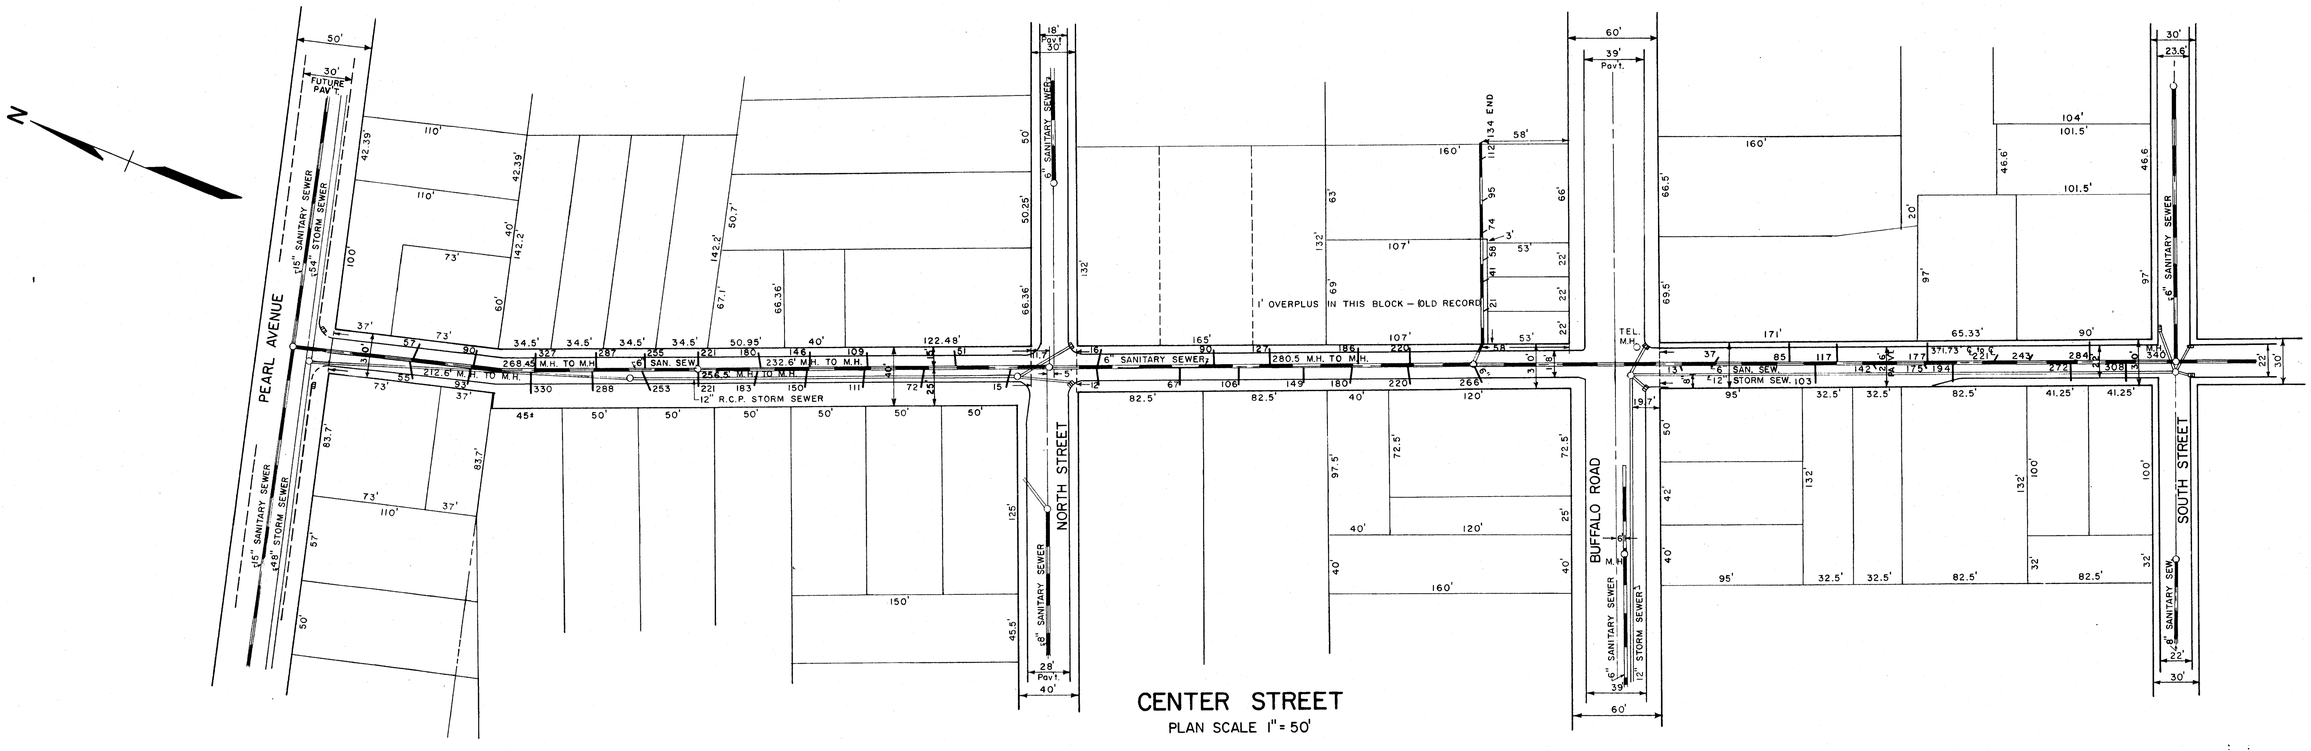

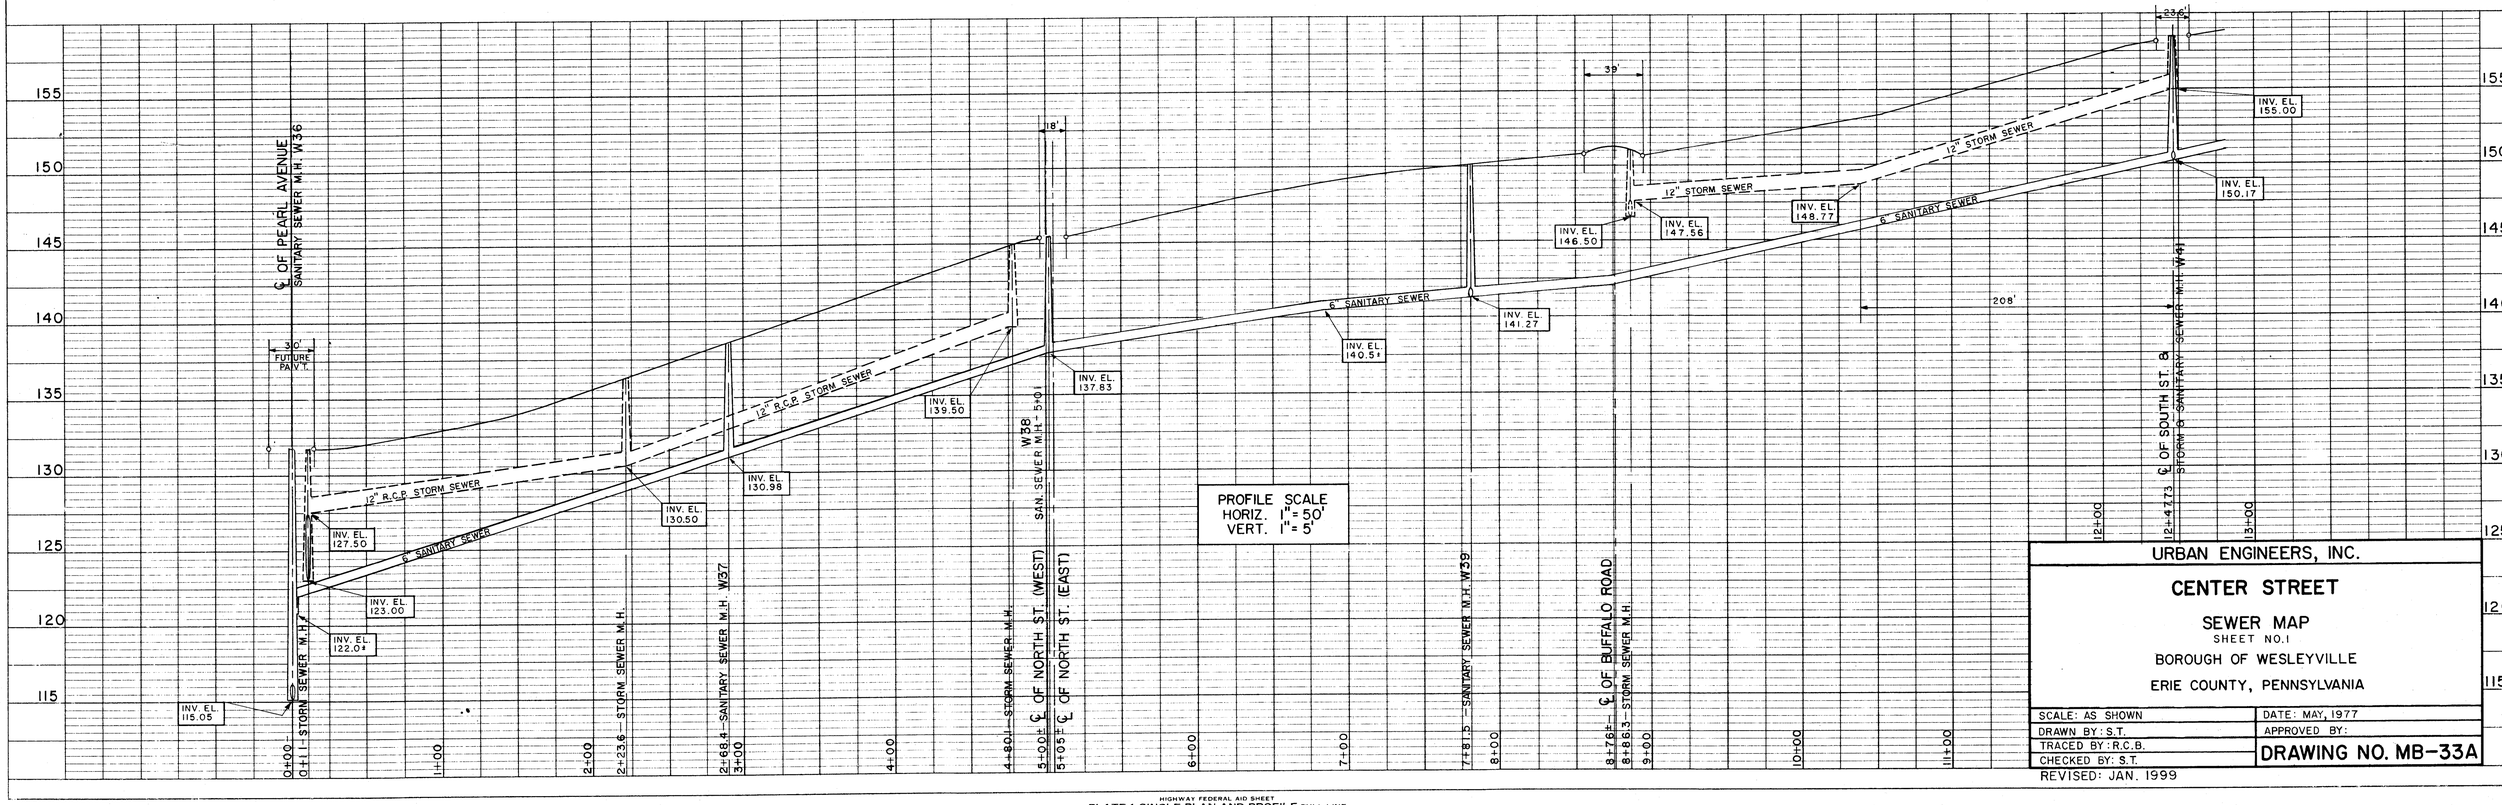

URBAN ENGINEERS, INC.

CENTER STREET

SEWER MAP

SHEET NO.1


BOROUGH OF WESLEYVILLE

ERIE COUNTY, PENNSYLVANIA

SCALE: AS SHOWN	DATE: MAY, 1977
DRAWN BY: S.T.	APPROVED BY:
TRACED BY: R.C.B.	DRAWING NO. MB-33A
CHECKED BY: S.T.	

REVISED: JAN. 1999


PLAN
SURVEYED
PLOTTED
NOTE BOOK
No.
BY
DATE
ALIGNMENT CHECKED
R/W OR WAY CHECKED

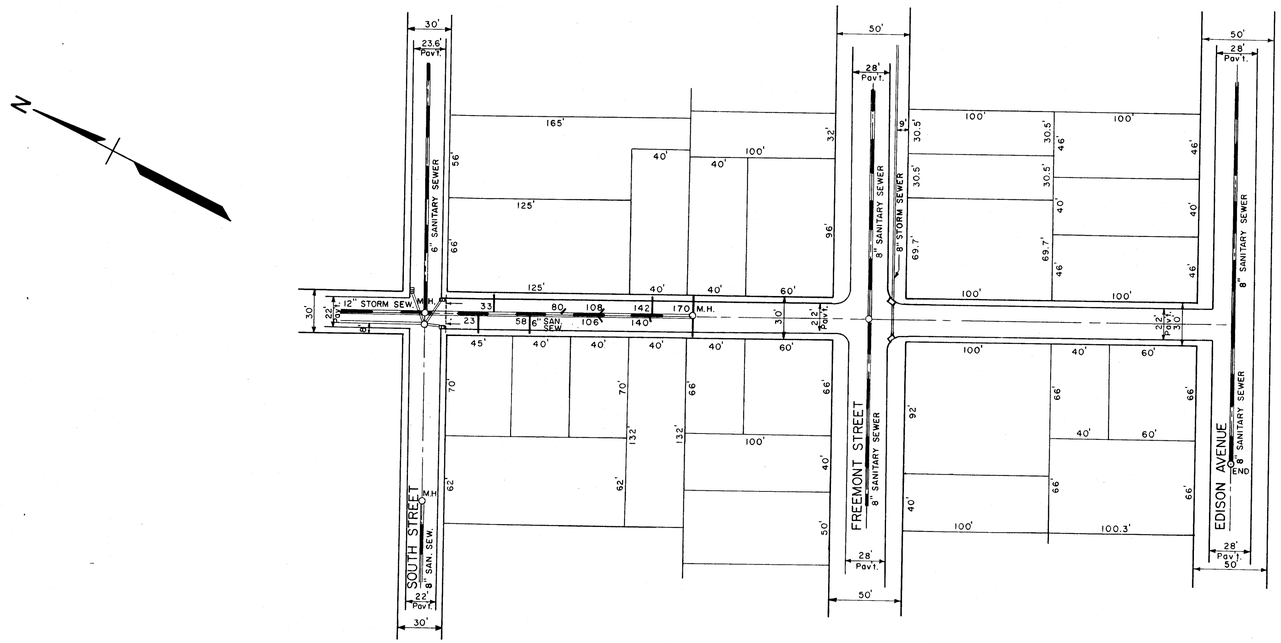

CENTER STREET

PLAN SCALE 1" = 50'

PROFILE
SURVEYED
PLOTTED
NOTE BOOK
No.
BY
DATE
GRADES CHECKED
R/W OR WAY CHECKED
STRUCTURE NOTATIONS CHECKED

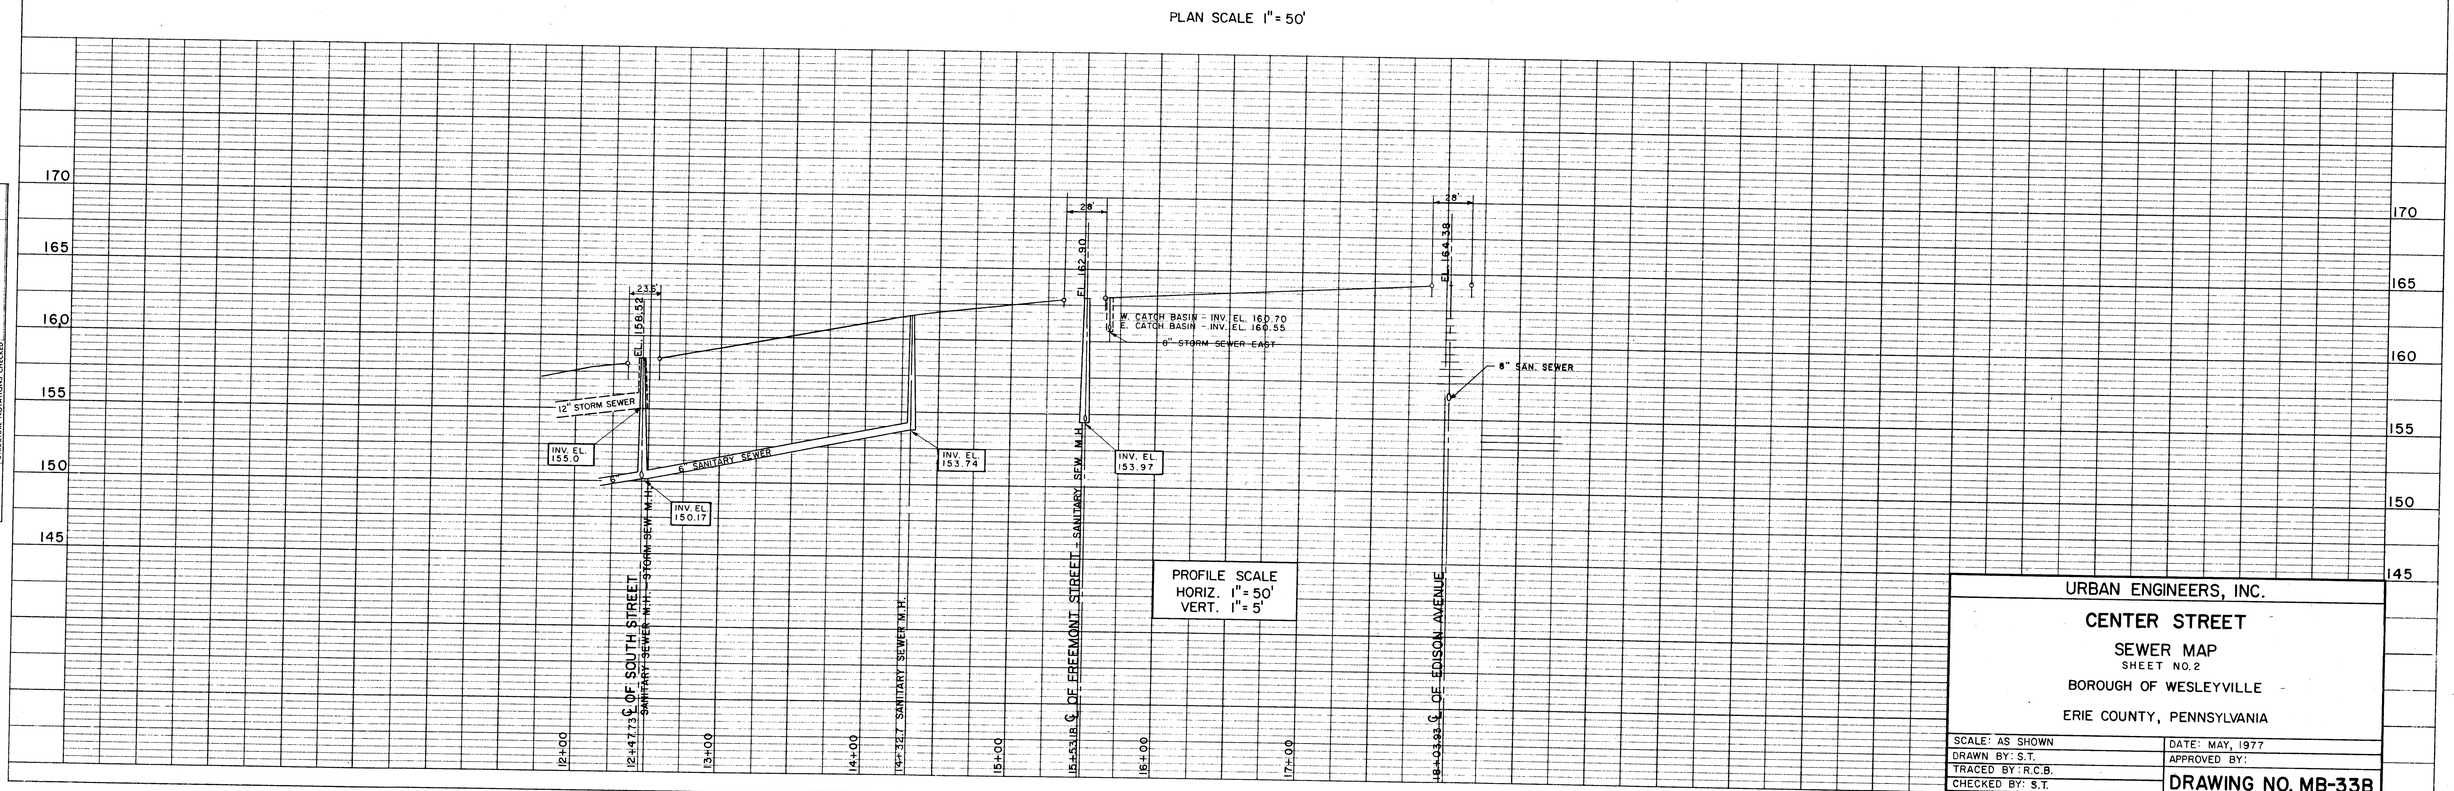

PROFILE SCALE
HORIZ. 1" = 50'
VERT. 1" = 5'

URBAN ENGINEERS, INC.

CENTER STREET

SEWER MAP
SHEET NO. 2
BOROUGH OF WESLEYVILLE
ERIE COUNTY, PENNSYLVANIA

SCALE: AS SHOWN	DATE: MAY, 1977
DRAWN BY: S.T.	APPROVED BY:
TRACED BY: R.C.B.	DRAWING NO. MB-33B
CHECKED BY: S.T.	

REVISED: JAN. 1999

HIGHWAY FEDERAL AID SHEET
PLATE 1-SINGLE PLAN AND PROFILE-FULL LINE
TELEDYNE
PRINTED IN U.S.A.

SANITARY SEWER REHABILITATION — 1996

ALL DISTANCES MEASURED FROM CENTER OF NOTED MANHOLE OR RIGHT OF WAY LINE

LEGEND

- △ REPLACED LATERAL WYE
- ⊗ REPLACED MANHOLE
- ● NEW MANHOLE
- T LATERAL CAPPED AT WYE

NOTE : REPLACED EXISTING 6" VCP WITH 6" PVC PIPE MH W27 TO W26.

REPLACED EXISTING 6" VCP WITH 8" PVC PIPE MH W26A TO W24.

REPLACED EXISTING 8" VCP WITH 8" D.I. PIPE MH 26A TO W26.

MARKET STREET

PLAN SCALE 1" = 50'

PROFILE SCALE
HORIZ. 1"=50'
VERT. 1"=5'

PEARL AVE. — BUFFALO ROAD — NORTH 6th STREET — SOUTH 6th STREET

8" SANITARY SEWER — 12" RCP STORM SEWER — 8" SAN. SEWER (D.I.)

INV. ELEV. 114.04 — INV. ELEV. 119.45 — INV. EL. 120.00 — INV. ELEV. 121.0 — INV. ELEV. 126.0 — ELEV. 126.3± — INV. ELEV. 140.00 — INV. ELEV. 136.37 — 6" FROM WEST - INV EL. 136.82 — INV. ELEV. 147.94 — ELEV. 144.64 — INV. ELEV. 142.21 — INV. ELEV. 149.70

0+00 — 0+11± C OF PEARL AVE. SANITARY SEW. M.H. W23 — 0+65± C OF NORTH ST. & SAN. SEWER M.H. W24 — 4+40± STORM SEWER M.H. — 7+81± SANITARY SEWER M.H. W26A — 8+35± C OF BUFFALO ROAD — 8+435± STORM SEWER M.H. — 8+94± SANITARY SEWER M.H. W26 — 12+00 — 12+06.73± C OF SOUTH ST. — 12+08 SANITARY SEW. M.H. W27

URBAN ENGINEERS, INC.

MARKET STREET

SEWER MAP

SHEET NO. 1

BOROUGH OF WESLEYVILLE

ERIE COUNTY, PENNSYLVANIA

SCALE: AS SHOWN	DATE: MAY 1977
DRAWN BY: S.T.	APPROVED BY:
TRACED BY: M.B.	DRAWING NO. MB-35-A
CHECHED BY: S.T.	

REVISED: JAN. 1999

PLAN — SURVEYED, PLOTTED, NOTE BOOK, No., GRADES CHECKED, R.O.W. CHECKED, AT OF WAY CHECKED

PROFILE — SURVEYED, PLOTTED, GRADES CHECKED, R.O.W. CHECKED, STRUCTURE NOTATIONS CHECKED

HIGHWAY FEDERAL AID SHEET
PLATE 1-SINGLE PLAN AND PROFILE-FULL LINE
TELEDYNE
PRINTED IN U.S.A.

SANITARY SEWER REHABILITATION – 1996

ALL DISTANCES MEASURED FROM CENTER OF NOTED MANHOLE

LEGEND

- △ REPLACED LATERAL WYE
- ⊗ REPLACED MANHOLE
- ⊥ LATERAL CAPPED AT WYE

NOTE: REPLACED EXISTING 6" VCP WITH 8" PVC PIPE MH W34 TO W33.

27T FROM VIDEO TAPED LOGS

MARKET STREET

PLAN SCALE 1"=50'

PROFILE SCALE
HORIZ. 1"=50'
VERT. 1"=5

URBAN ENGINEERS, INC.

MARKET STREET
SEWER MAP
SHEET NO. 2
BOROUGH OF WESLEYVILLE
ERIE COUNTY, PENNSYLVANIA

SCALE AS SHOWN	DATE: JUNE 1977
DRAWN BY: S.T.	APPROVED BY:
TRACED BY: M.B.	DRAWING NO. MB-35-B
CHECKED BY: S.T.	


REVISED: JAN. 1999

NOTE BOOK | PLOTTED | ALIGNMENT CHECKED | No. | R/W NOTED | STRUCTURE LOCATIONS CHECKED | GRADES CHECKED

HIGHWAY FEDERAL AID SHEET
PLATE 1-SINGLE PLAN AND PROFILE-FULL LINE
TELEDYNE
PRINTED IN U.S.A.

PLAN
NOTE BOOK No.
SURVEYED
PLOTTED
ALIGNMENT CHECKED
RT. OF WAY CHECKED
BY DATE

PROFILE
NOTE BOOK No.
SURVEYED
PLOTTED
GRADES CHECKED
B. M.'s NOTED
STRUCTURE NOTATIONS CHECKED
BY DATE



SANITARY SEWER REHABILITATION — 1993, 1997

ALL DISTANCES MEASURED FROM CENTER OF NOTED MANHOLE OR RIGHT OF WAY LINE.

LEGEND

△ REPLACED LATERAL WYE

⊗ REPLACED MANHOLE

NOTE: REPLACED EXISTING 6" VCP WITH 8" PVC PIPE FROM MH W10 TO W16, MH W16 TO W18, MH W18 TO W21 AND REPLACED EXISTING 8" VCP WITH 8" PVC PIPE MH W9 TO W10.

PLAN — SURVEYED / DRAWN / TRACED / NOTE BOOK / PAGES CHECKED / No. / B.M.'s NOTED / STRUCTURE INFORMATION CHECKED

PROFILE — SURVEYED / DRAWN / TRACED / NOTE BOOK / PAGES CHECKED / No. / B.M.'s NOTED / STRUCTURE INFORMATION CHECKED

WATER STREET

PLAN SCALE 1"=50'

PROFILE SCALE
HORIZ. 1"=50'
VERT. 1"=5'

URBAN ENGINEERS, INC.

WATER STREET

SEWER MAP
SHEET NO. 2
BOROUGH OF WESLEYVILLE
ERIE COUNTY, PENNSYLVANIA

SCALE: AS SHOWN	DATE: JULY 1977
DRAWN BY: S.T.	APPROVED BY:
TRACED BY: R.A.S. & M.A.B.	DRAWING NO. MB-36-B
CHECKED BY: S.T.	


REVISED: JAN. 1999

PLATE 1-SINGLE PLAN AND PROFILE FULL LINE

SANITARY SEWER
REHABILITATION – 1996


LEGEND

⊗ REPLACED MANHOLE

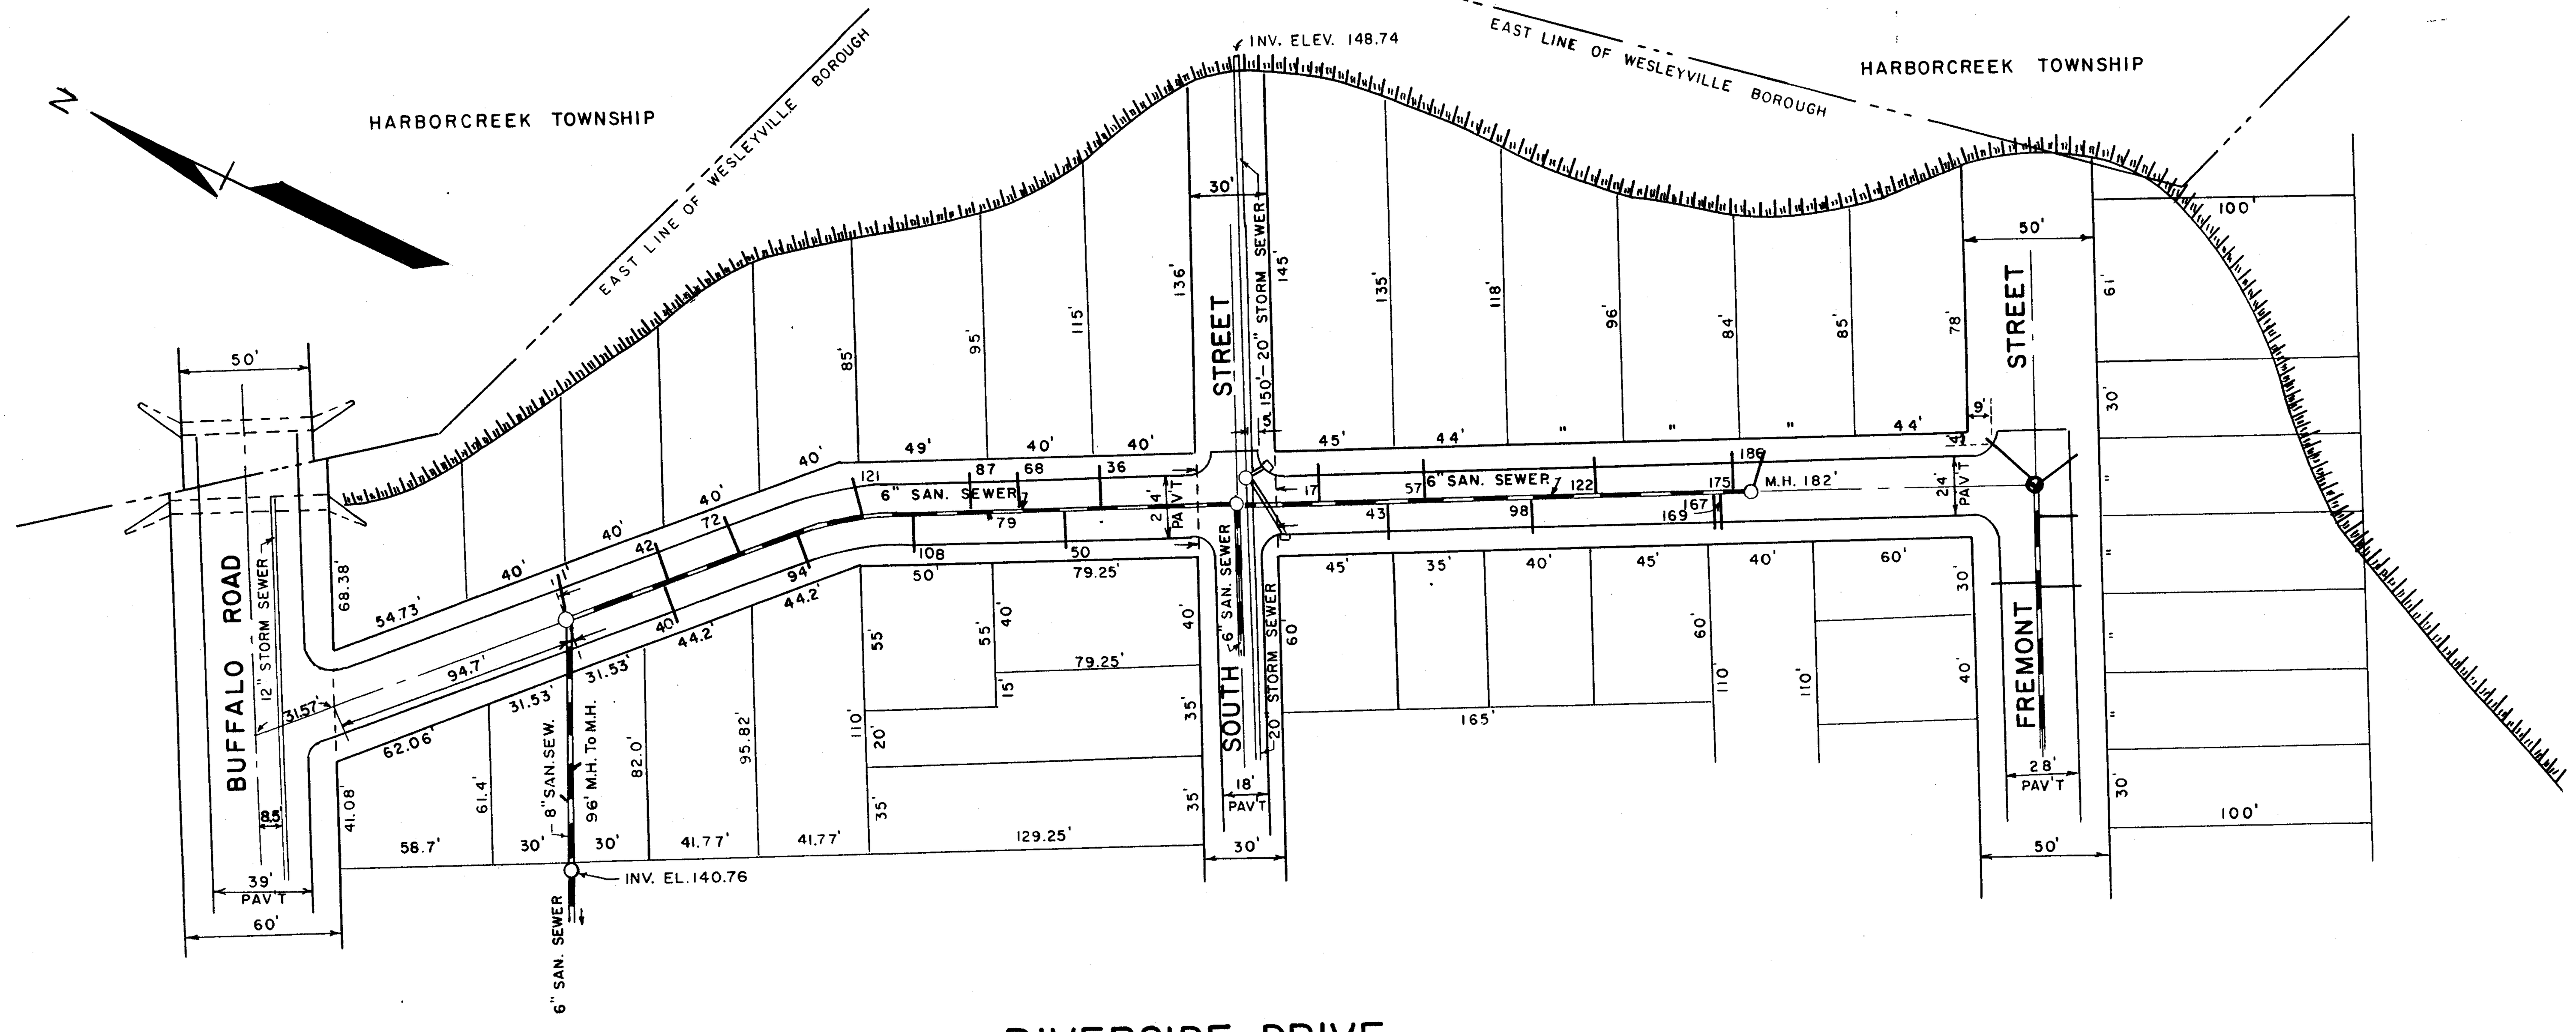

RIVERSIDE DRIVE

PLAN SCALE 1"= 50'



PROFILE SCALE
HORIZ. 1"=50'
VERT. 1"=5'


URBAN ENGINEERS, INC.	
RIVERSIDE DRIVE	
SEWER MAP	
BOROUGH OF WESLEYVILLE ERIE COUNTY, PENNSYLVANIA	
SCALE: AS SHOWN	DATE: FEBRUARY 1977
DRAWN BY: S.T.	APPROVED BY:
TRACED BY:	DWG. NO. MB-37
CHECKED BY: S.T.	

REVISED JAN. 1999

PLAN | NOTE BOOK | No. | SURVEYED | PLOTTED | ALIGNMENT CHECKED | RT. OF WAY CHECKED | BY | DATE


PROFILE | NOTE BOOK | No. | SURVEYED | PLOTTED | GRADES CHECKED | B. M.'s NOTED | STRUCTURE NOTATIONS CHECKED | BY | DATE

HIGHWAY FEDERAL AID SHEET
PLATE 1-SINGLE PLAN AND PROFILE-FULL LINE
TELEDYNE
PRINTED IN U.S.A.

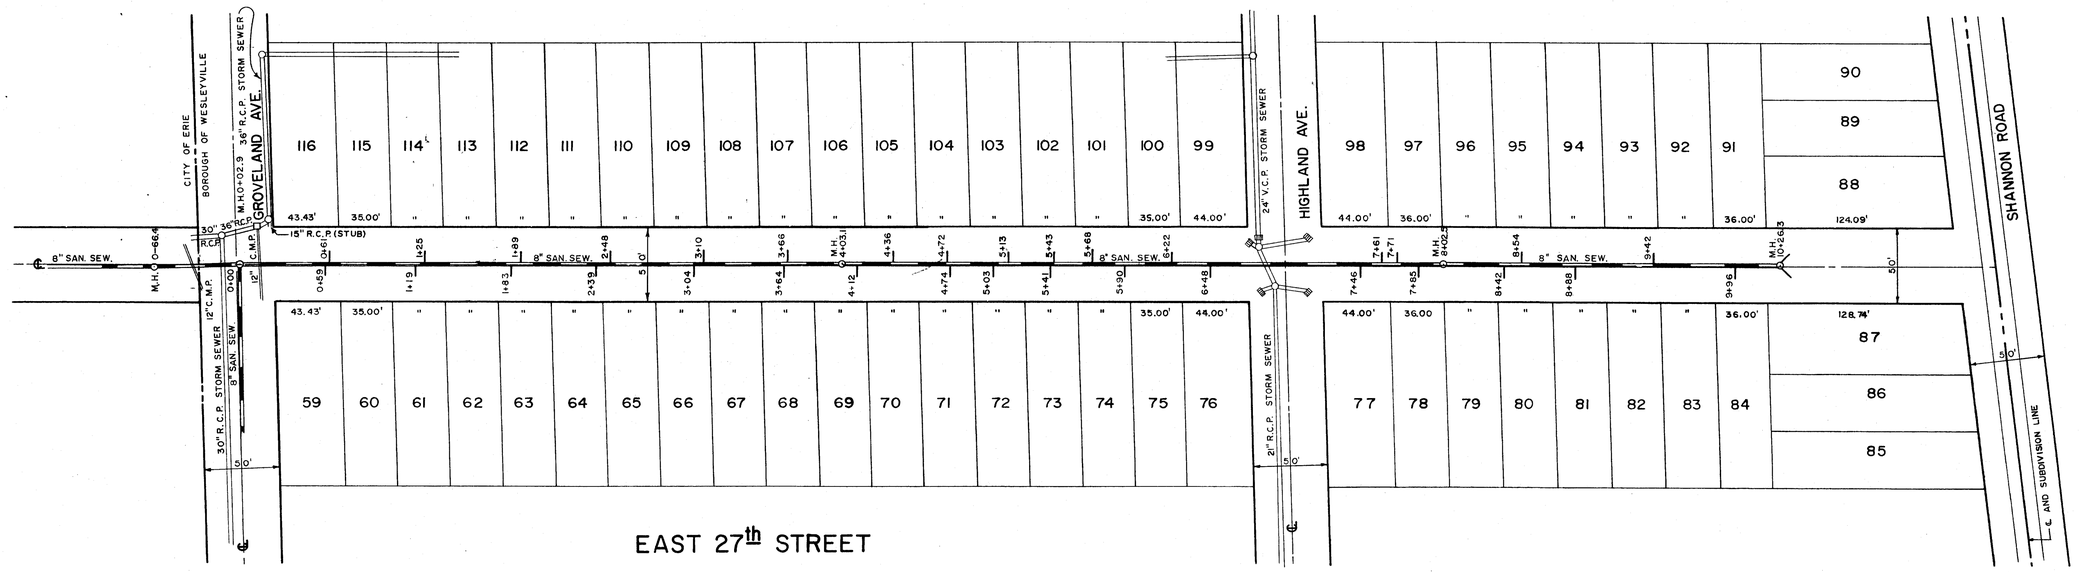

EAST 27th STREET

PLAN SCALE 1"=50'

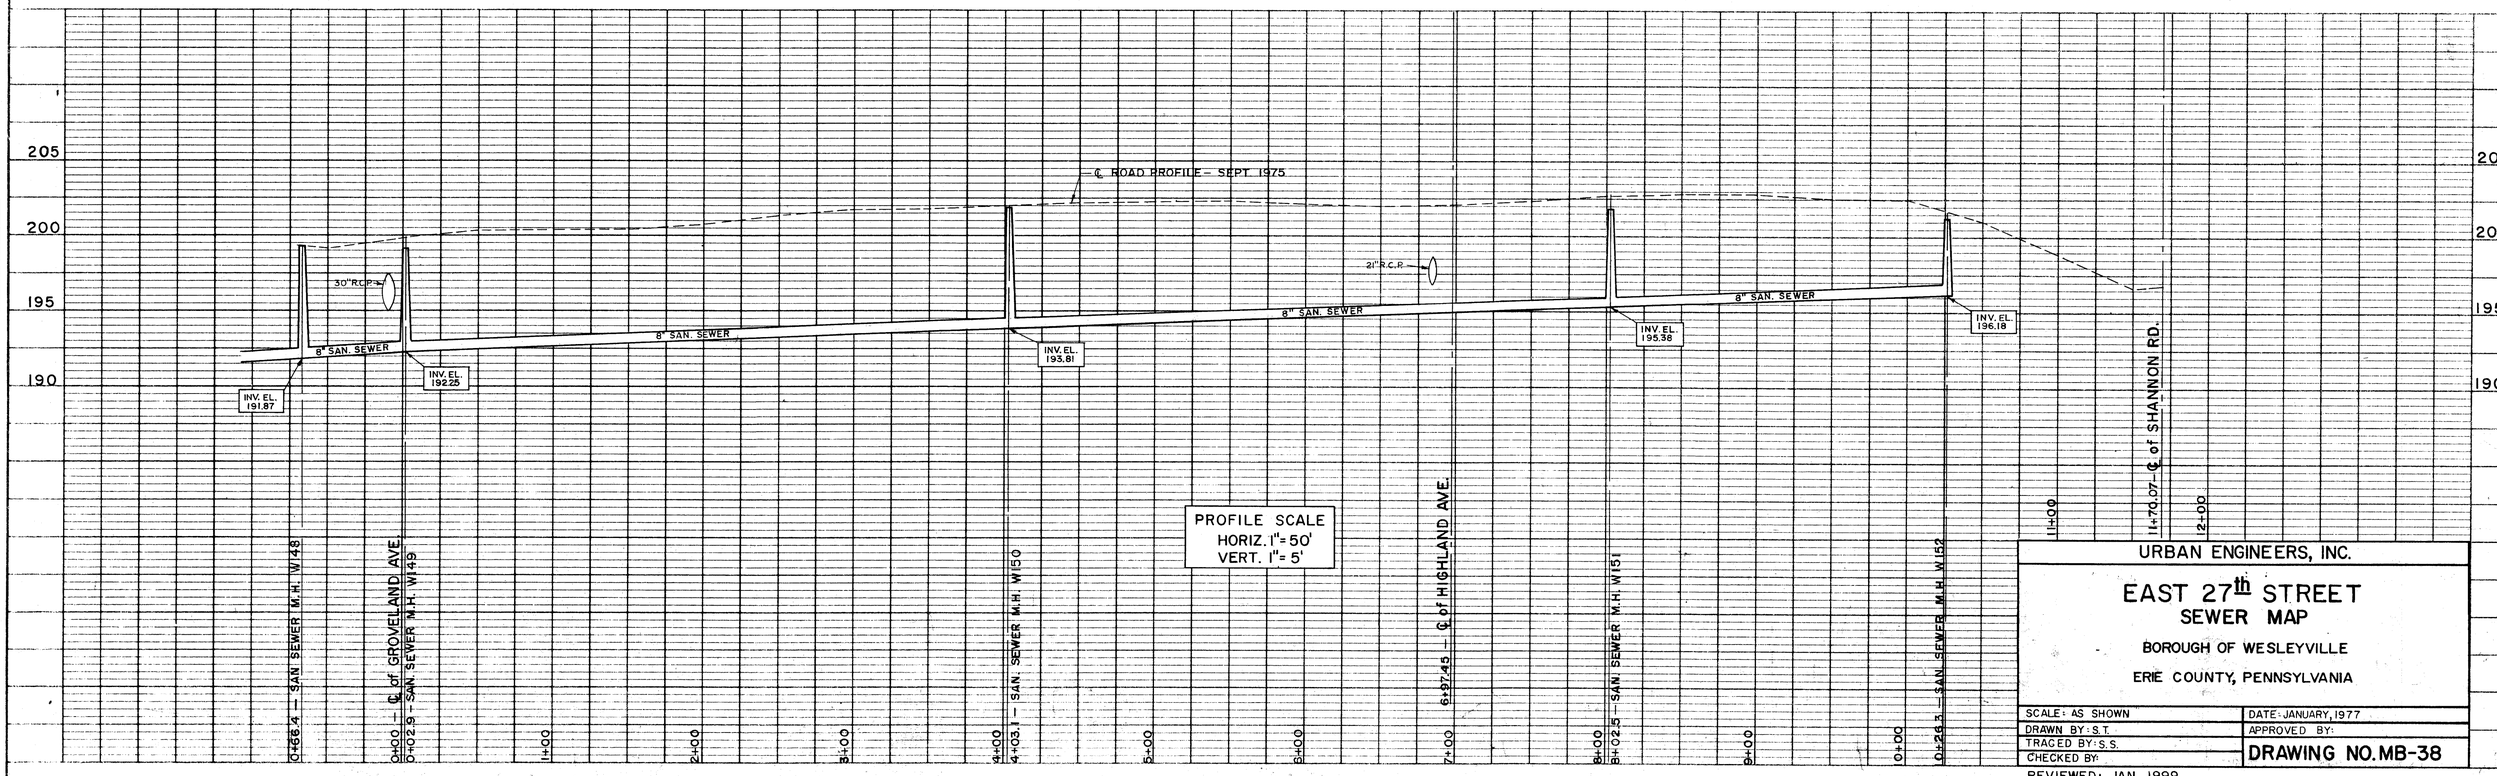

PROFILE SCALE
HORIZ. 1"= 50'
VERT. 1"= 5'

URBAN ENGINEERS, INC.

EAST 27th STREET
SEWER MAP

BOROUGH OF WESLEYVILLE

ERIE COUNTY, PENNSYLVANIA


SCALE: AS SHOWN	DATE: JANUARY, 1977
DRAWN BY: S.T.	APPROVED BY:
TRACED BY: S.S.	DRAWING NO. MB-38
CHECKED BY:	

REVIEWED: JAN. 1999

PLAN SURVEYED / PLOTTED / NOTE BOOK / NO / GRADES CHECKED / BY / STRUCTURE NOTAT (SCH. NO.) / R/W CHECKED / BY OF WAY CHECKED


PROFILE SURVEYED / PLOTTED / NOTE BOOK / NO / GRADES CHECKED / BY / STRUCTURE NOTAT (SCH. NO.)

PLATE 1 PLAN PROFILE
Océ-Elliott Inc. océ
NO. 4817 TRACING CLOTH

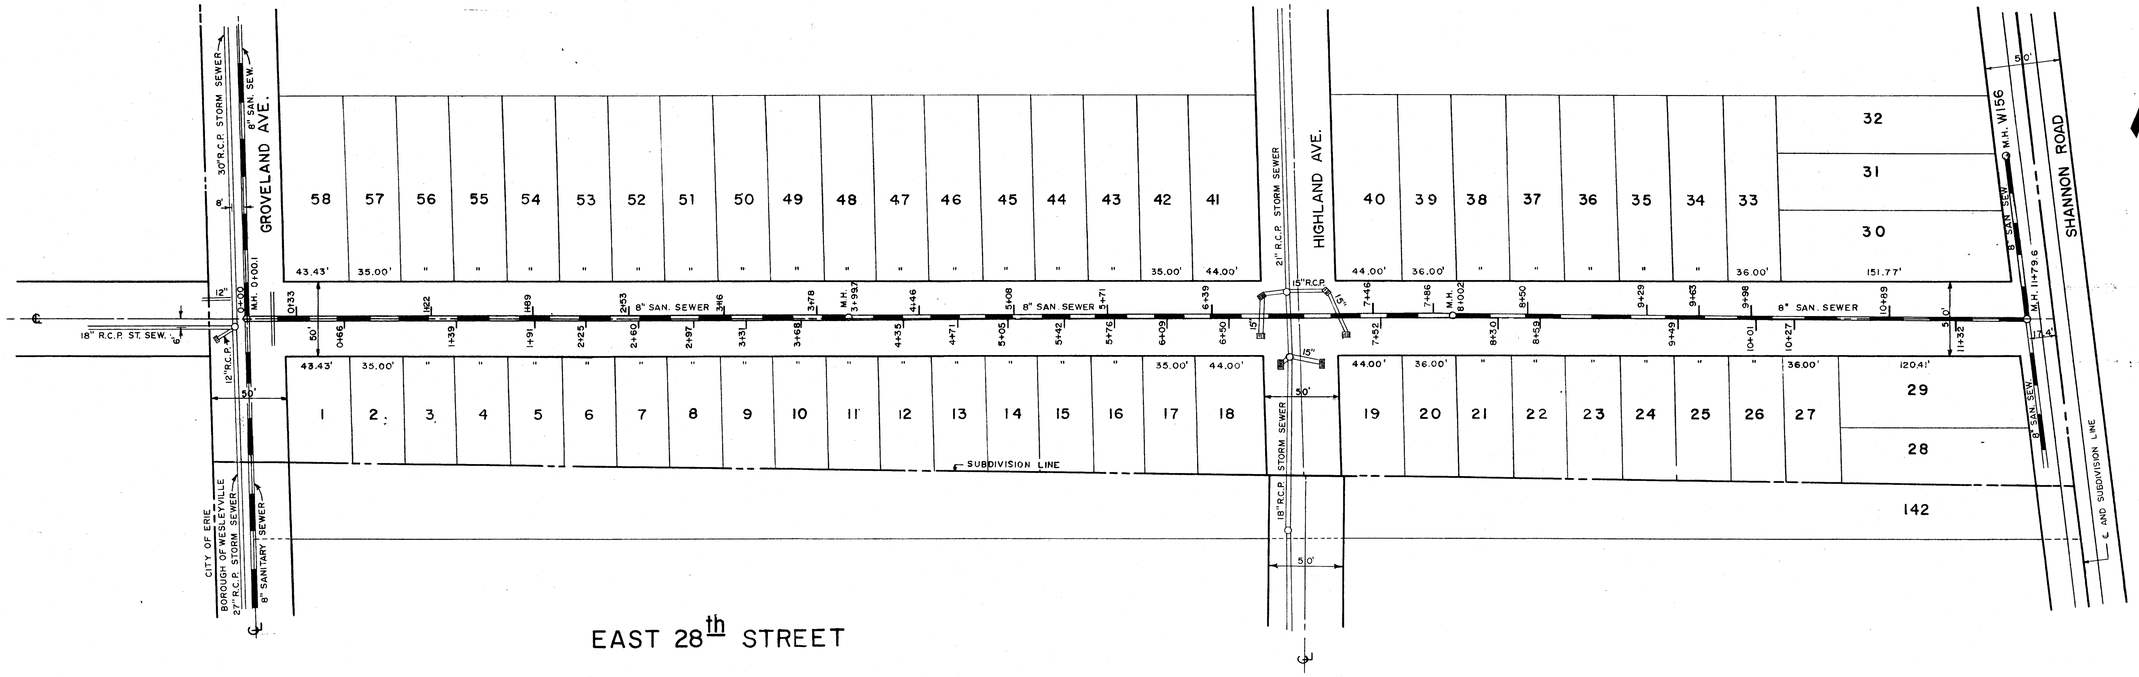

EAST 28th STREET

PLAN SCALE 1"=50'

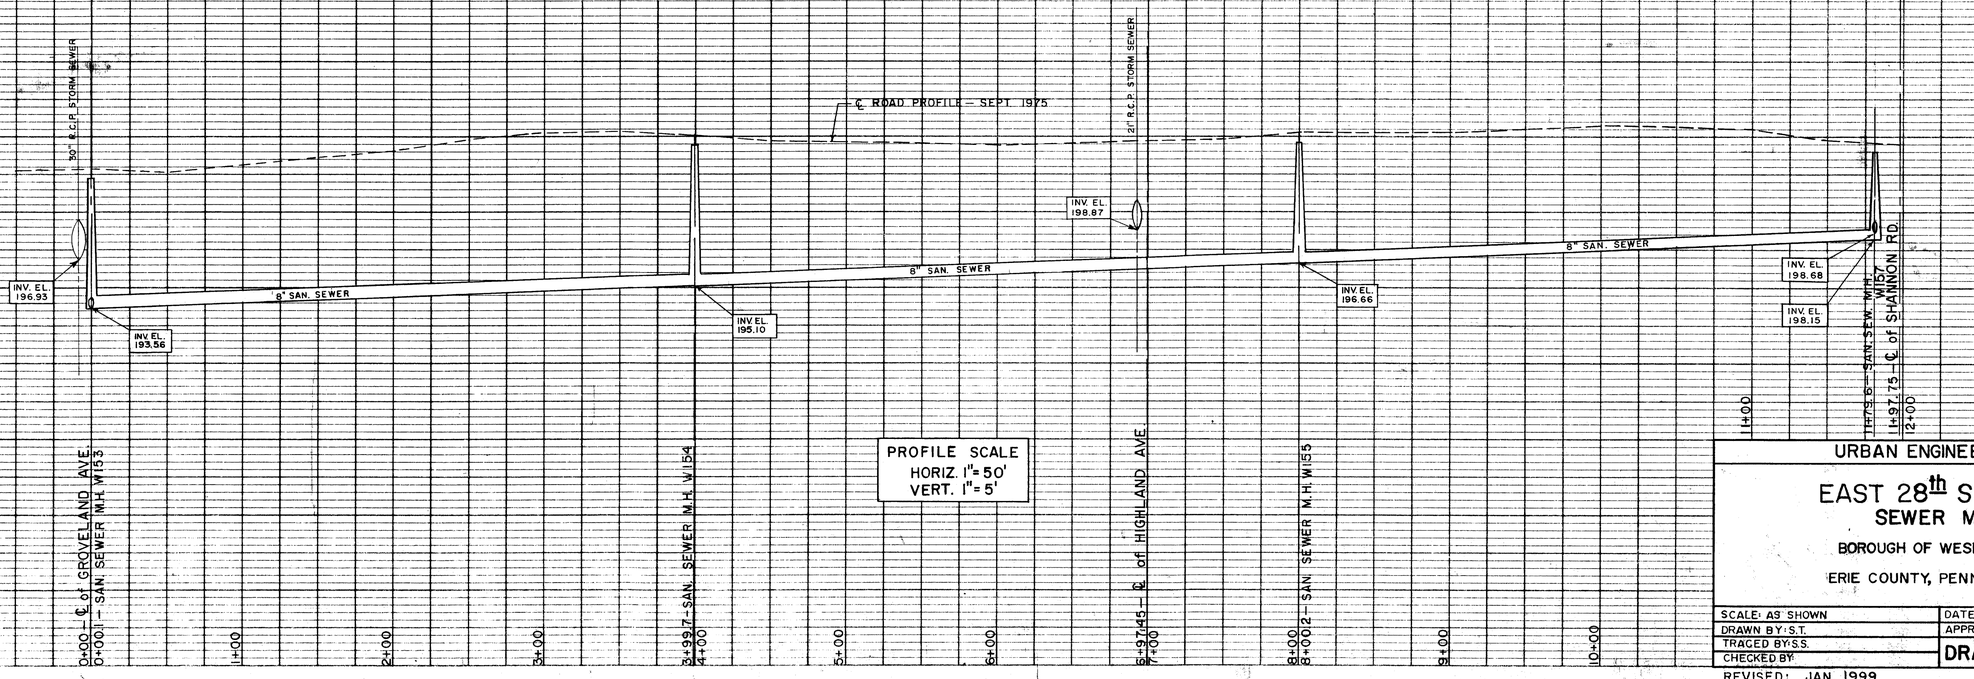

PROFILE SCALE
HORIZ. 1"= 50'
VERT. 1"= 5'

URBAN ENGINEERS, INC.

EAST 28th STREET
SEWER MAP

BOROUGH OF WESLEYVILLE

ERIE COUNTY, PENNSYLVANIA

SCALE: AS SHOWN	DATE: JANUARY, 1977
DRAWN BY: S.T.	APPROVED BY:
TRACED BY: S.S.	
CHECKED BY:	DRAWING NO. MB-39


REVISED: JAN. 1999


PLAN — SURVEYED, PLOTTED, LINKAGES CHECKED, ALIGNMENT CHECKED, RT. OF WAY CHECKED, NOTE BOOK, NO

PROFILE — SURVEYED, PLOTTED, LINKAGES CHECKED, ALIGNMENT CHECKED, STRUCTURE NOTAT NS CH. RD, NOTE BOOK, NO

PLATE 1 PLAN PROFILE

Océ-Elliott Inc.
NO. 4R2 TRACING CLOTH

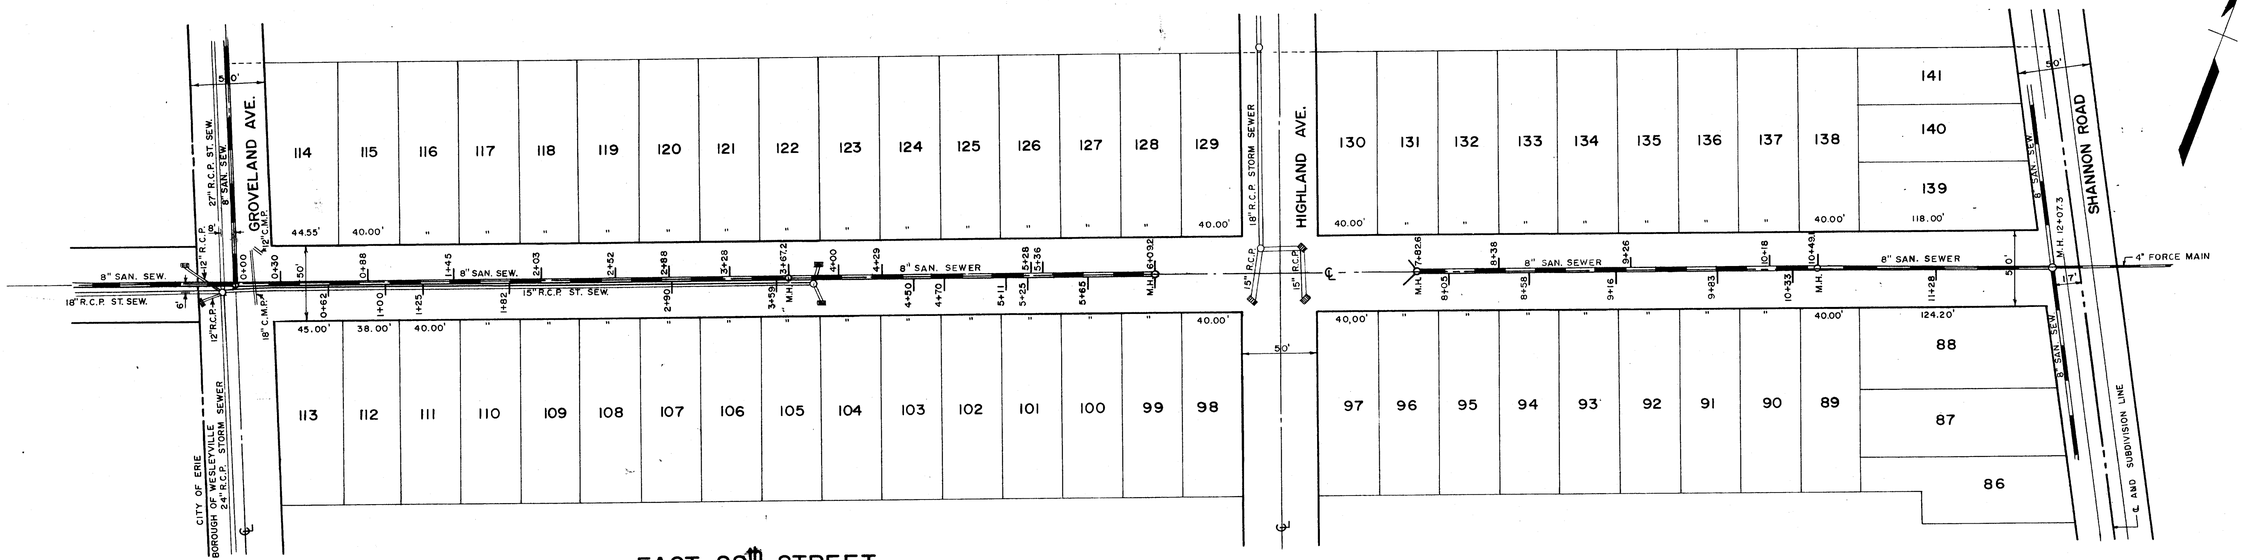

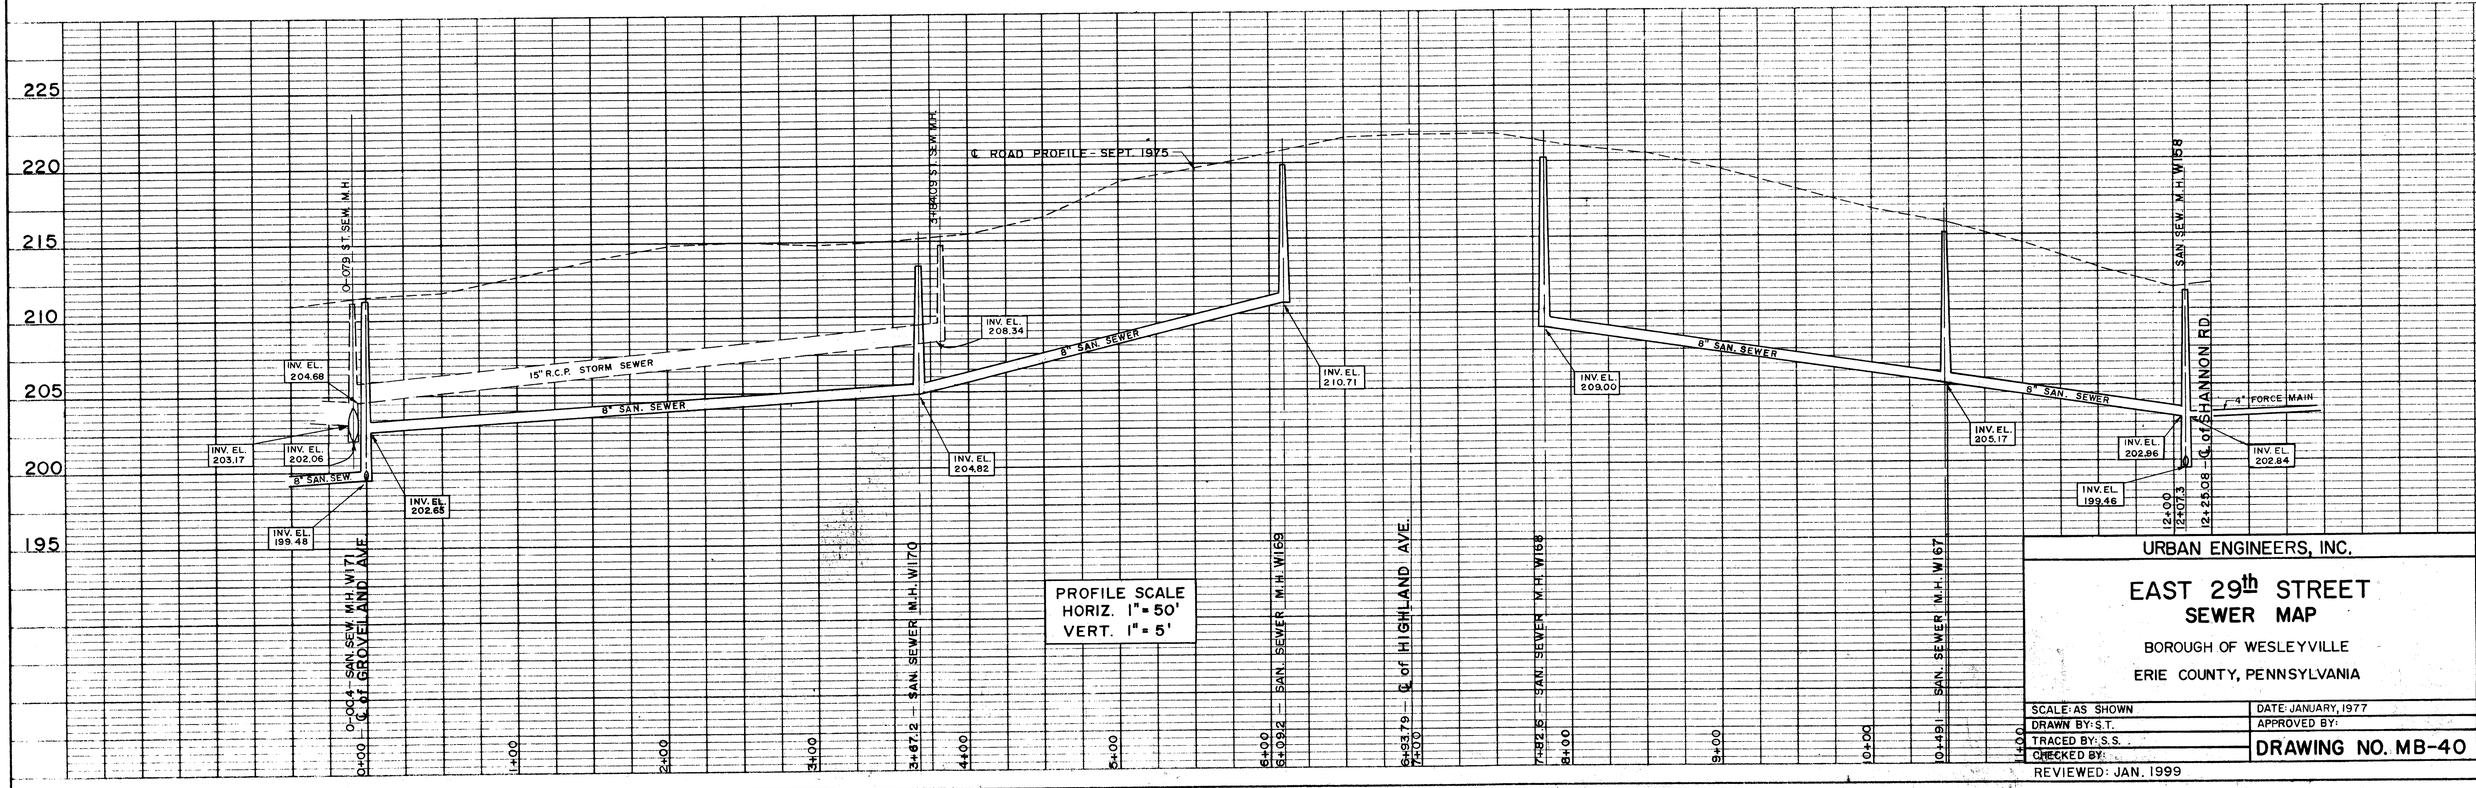

URBAN ENGINEERS, INC.

EAST 29th STREET
SEWER MAP

BOROUGH OF WESLEYVILLE

ERIE COUNTY, PENNSYLVANIA


SCALE: AS SHOWN	DATE: JANUARY, 1977
DRAWN BY: S.T.	APPROVED BY:
TRACED BY: S.S.	DRAWING NO. MB-40
CHECKED BY:	

REVIEWED: JAN. 1999

PLAN
SURVEYED
NOTE BOOK
DATE
BY
NO
ALIGNMENT CHECKED
RT OF WAY CHECKED

PROFILE
SURVEYED
NOTE BOOK
GRADES CHECKED
STRUCTURE NOTED
DATE
BY
NO
S. M. H.
STRUCTURE NOTED


PLATE 1 PLAN PROFILE
Océ-Elliott Inc.
NO. 422 TRACING CLOTH

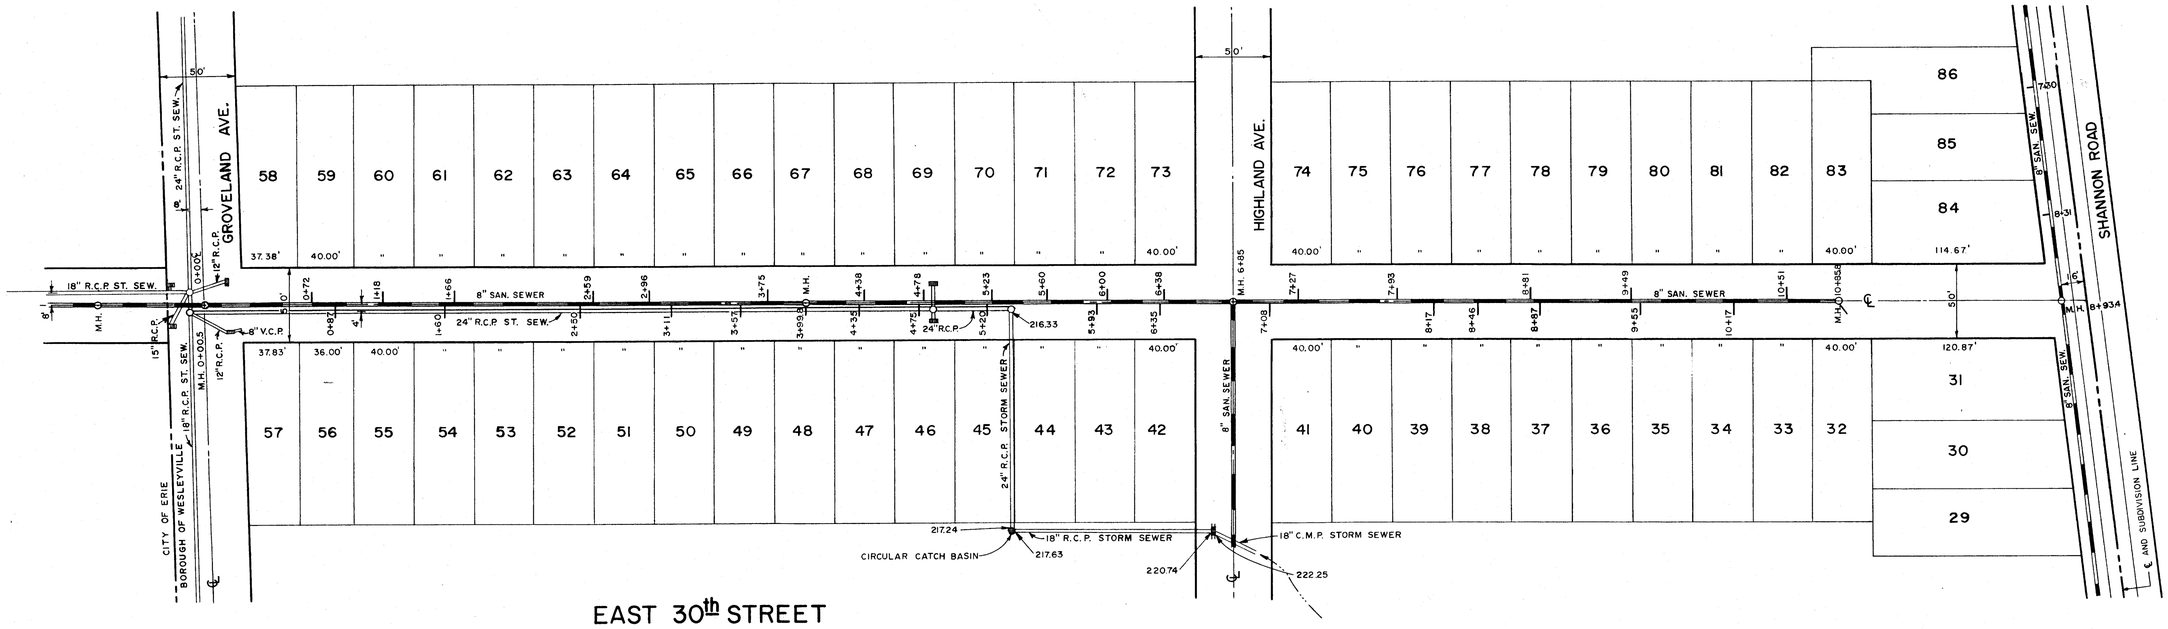

EAST 30th STREET

PLAN SCALE 1"=50'

NOTE: ELEVATIONS INDICATE INVERT ELEVATION.

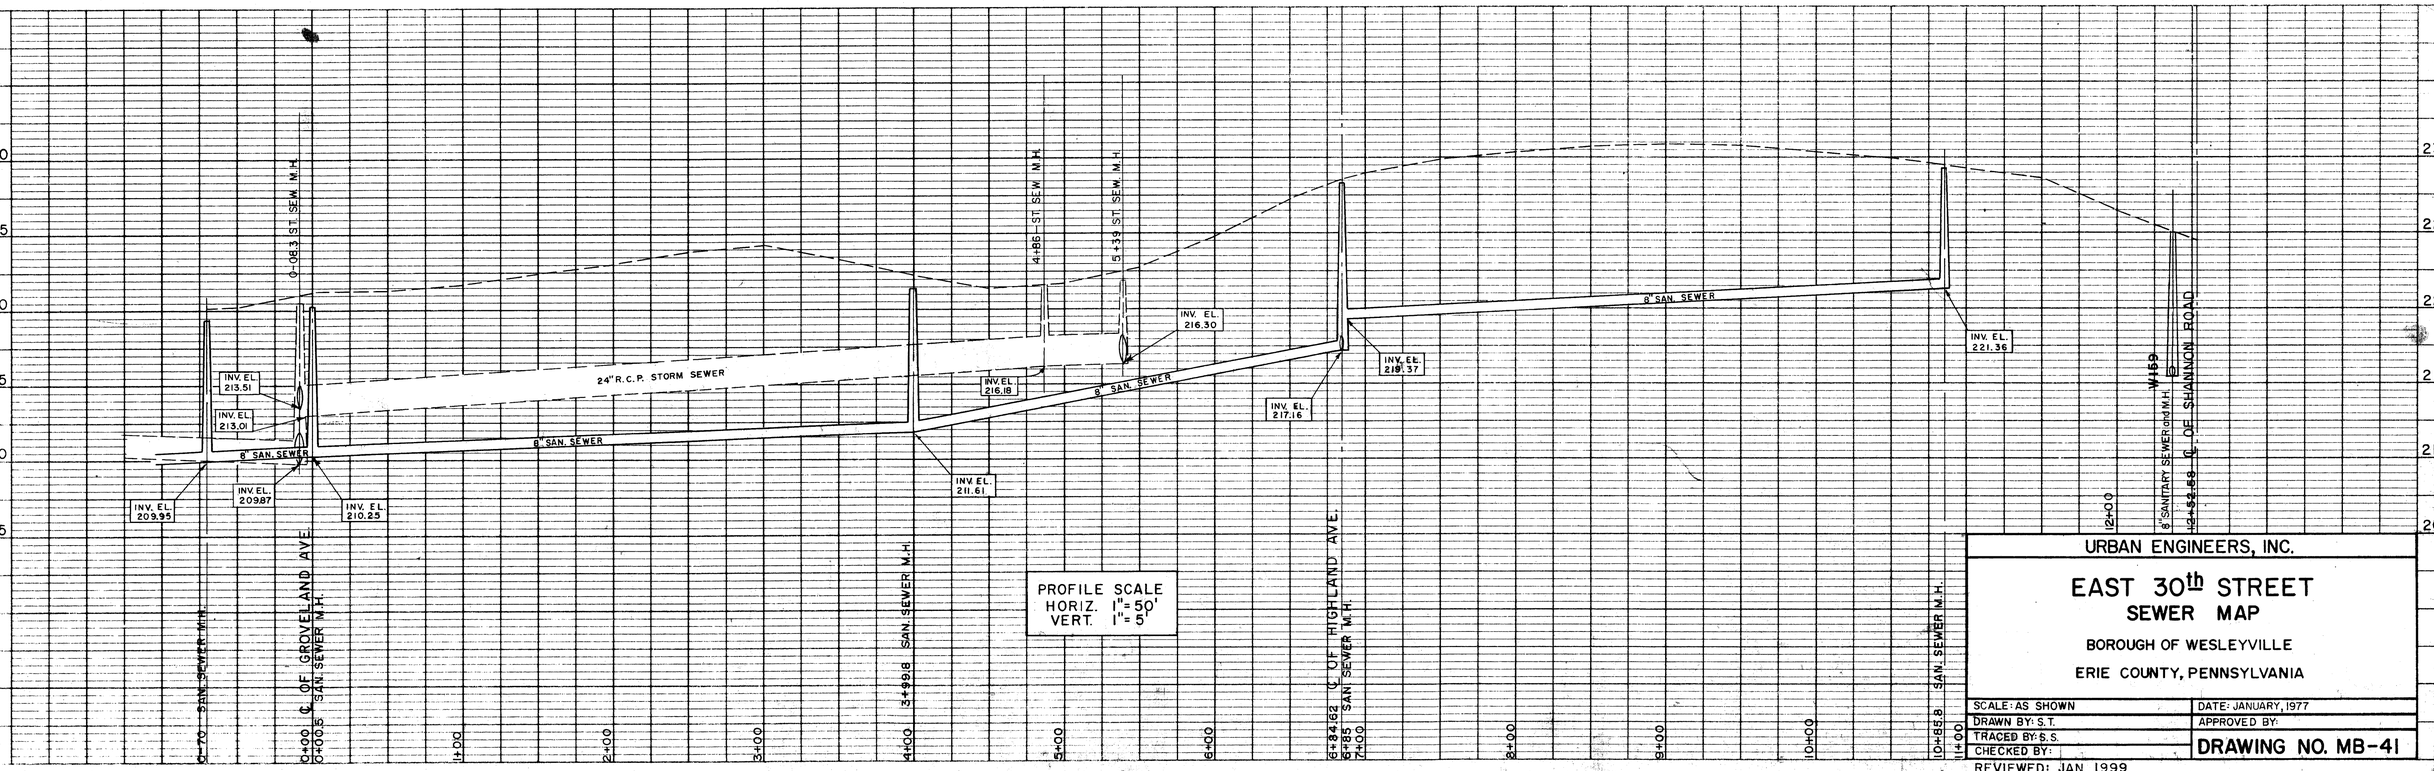

PROFILE SCALE
HORIZ. 1"=50'
VERT. 1"=5'

URBAN ENGINEERS, INC.

EAST 30th STREET
SEWER MAP

BOROUGH OF WESLEYVILLE


ERIE COUNTY, PENNSYLVANIA


SCALE: AS SHOWN	DATE: JANUARY, 1977
DRAWN BY: S.T.	APPROVED BY:
TRACED BY: S.S.	DRAWING NO. MB-41
CHECKED BY:	
REVIEWED: JAN. 1999	

PLAN
SURVEYED
PLOTTED
NOTE BOOK
NO
DATE
BY
RIGHT OF WAY CHECKED
ALIGNMENT CHECKED

PROFILE
SURVEYED
PLOTTED
GRADES CHECKED
NOTE BOOK
NO
DATE
BY
STRUCTURE NOTATIONS CHECKED

PLATE 1 PLAN PROFILE
Océ-Elliott Inc.
NO. AND TRACING CLOTH
océ

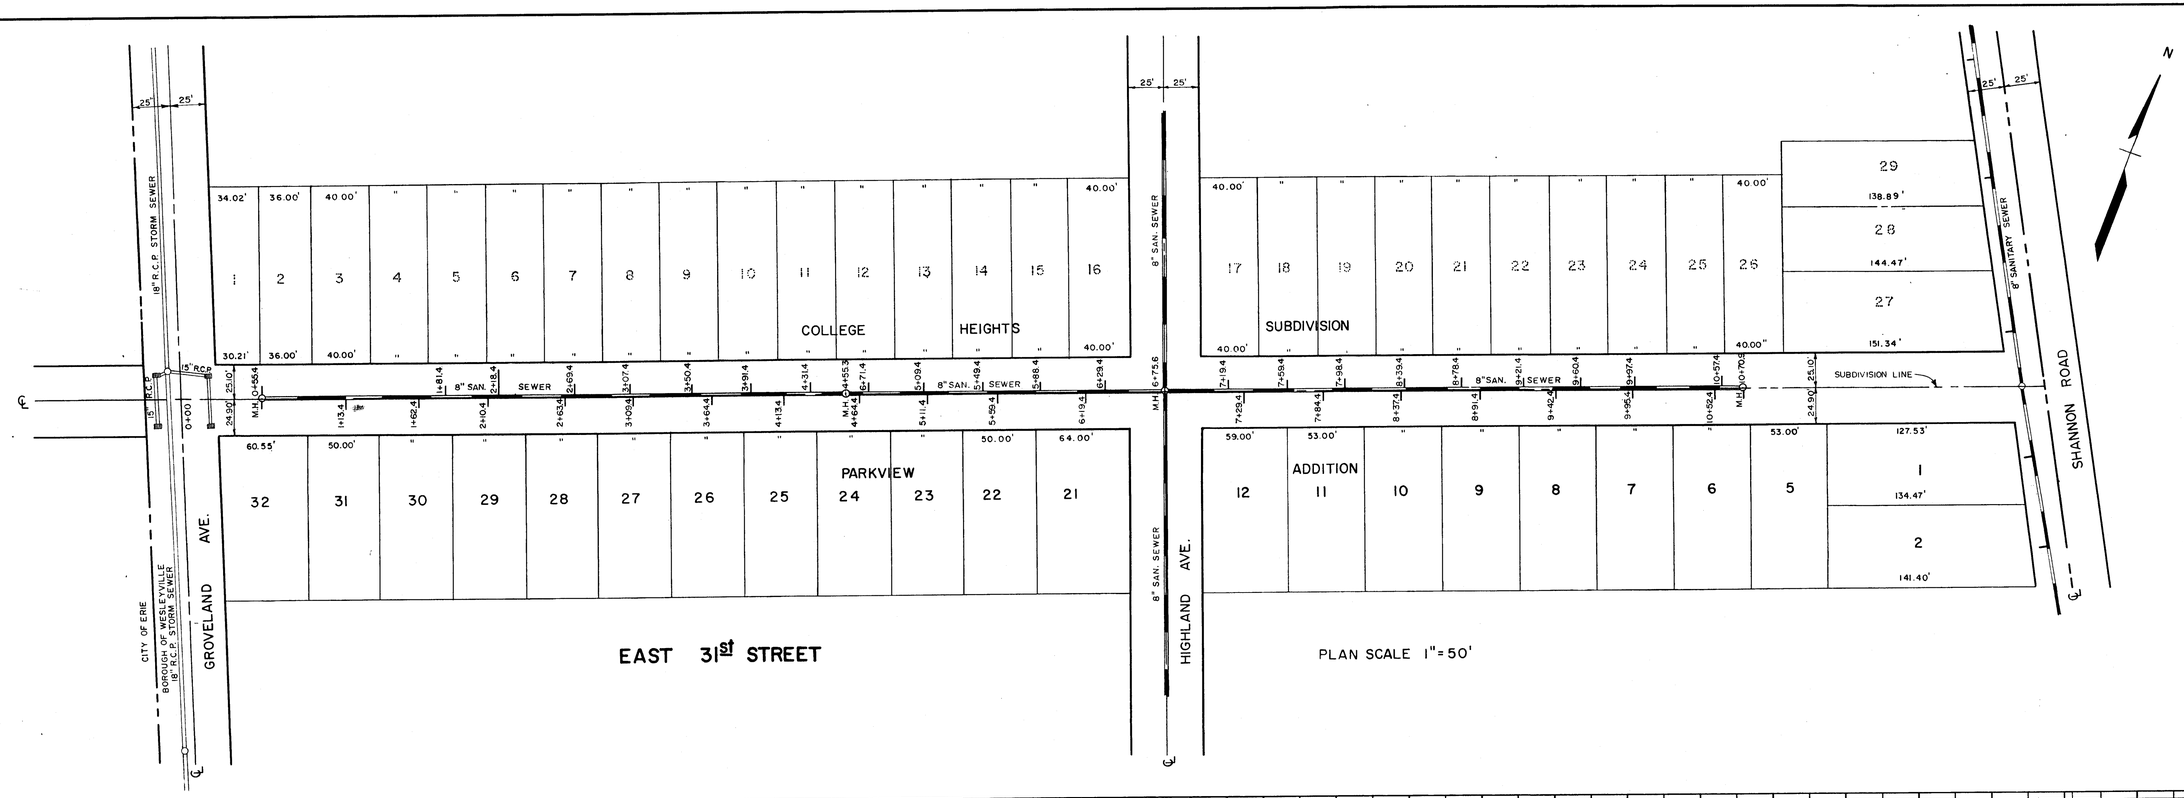

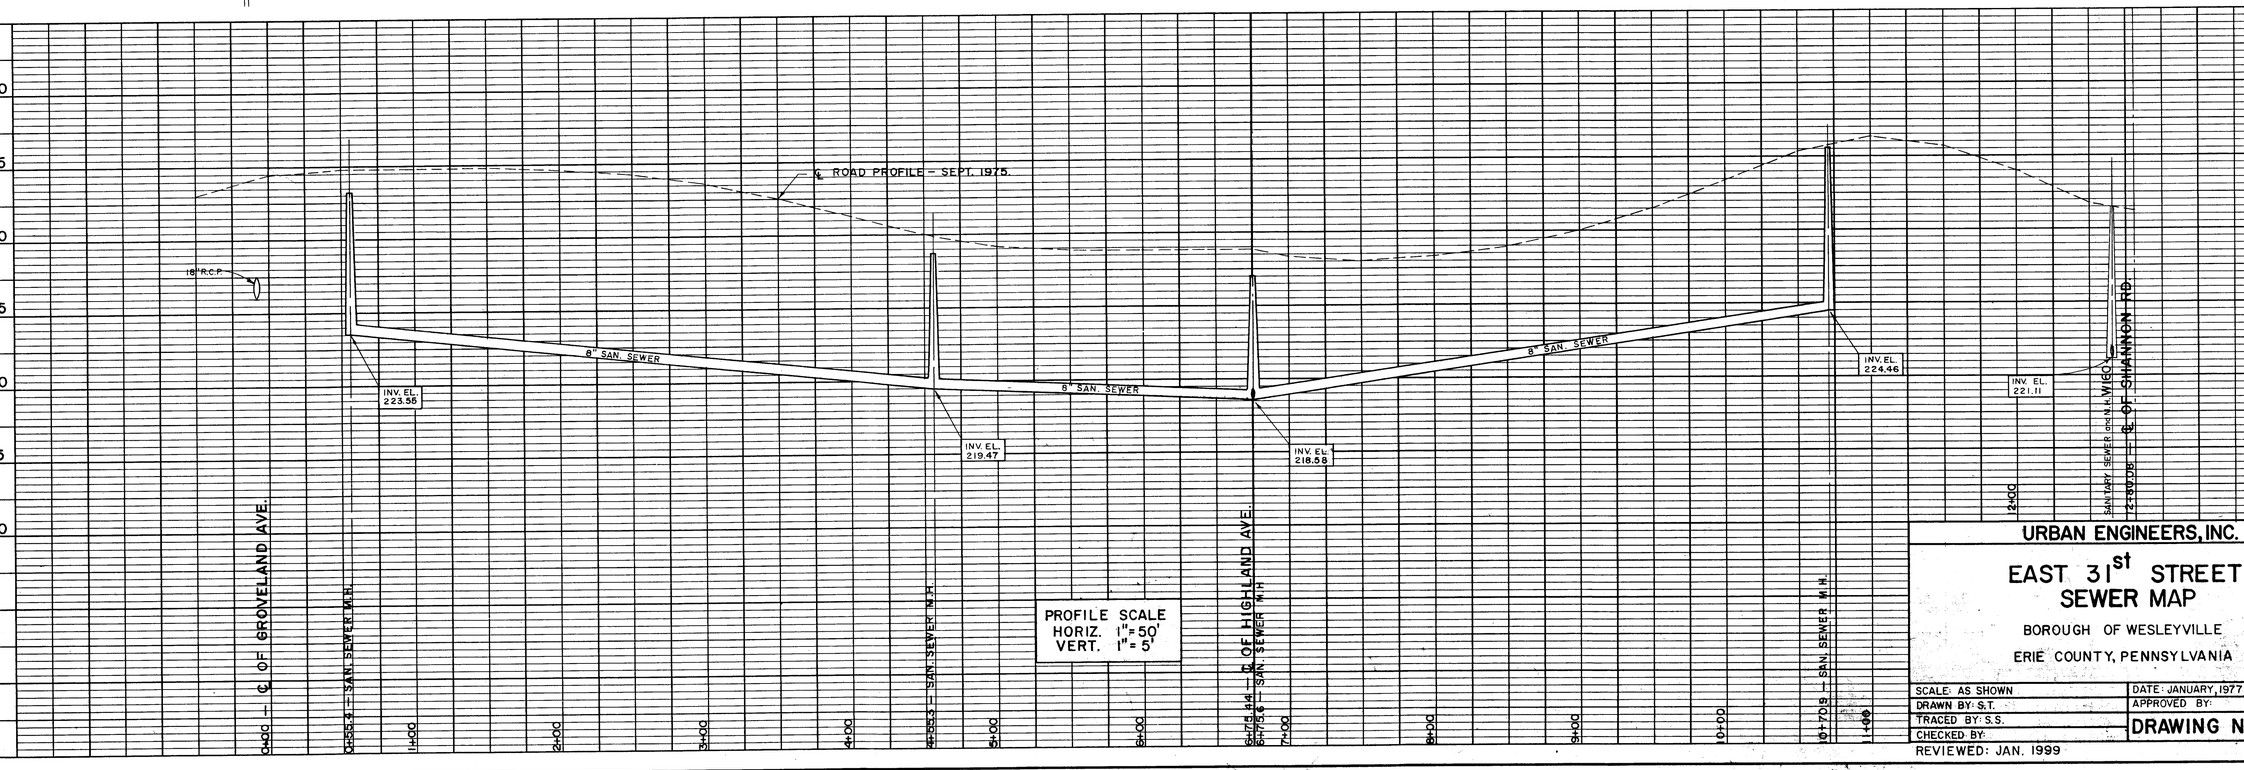

URBAN ENGINEERS, INC.

EAST 31st STREET SEWER MAP

BOROUGH OF WESLEYVILLE

ERIE COUNTY, PENNSYLVANIA

SCALE: AS SHOWN	DATE: JANUARY, 1977
DRAWN BY: S.T.	APPROVED BY:
TRACED BY: S.S.	DRAWING NO. MB-42
CHECKED BY:	
REVIEWED: JAN. 1999	

PLAN — SURVEYED, PLOTTED, NOTE BOOK, No., ALIGNMENT CHECKED, RT. OF WAY CHECKED, DATE, BY

PROFILE — SURVEYED, PLOTTED, NOTE BOOK, No., STRUCTURE NOTATIONS CHECKED, DATE, BY

Printed in U. S. A. On IMPERIAL Tracing Cloth


PLATE 1 PLAN - PROFILE B P R STANDARD
EUGENE DIETZGEN CO., CHICAGO - NEW YORK

Printed in U. S. A. On IMPERIAL Tracing Cloth



EAST 32nd STREET

PLAN SCALE 1"=50'

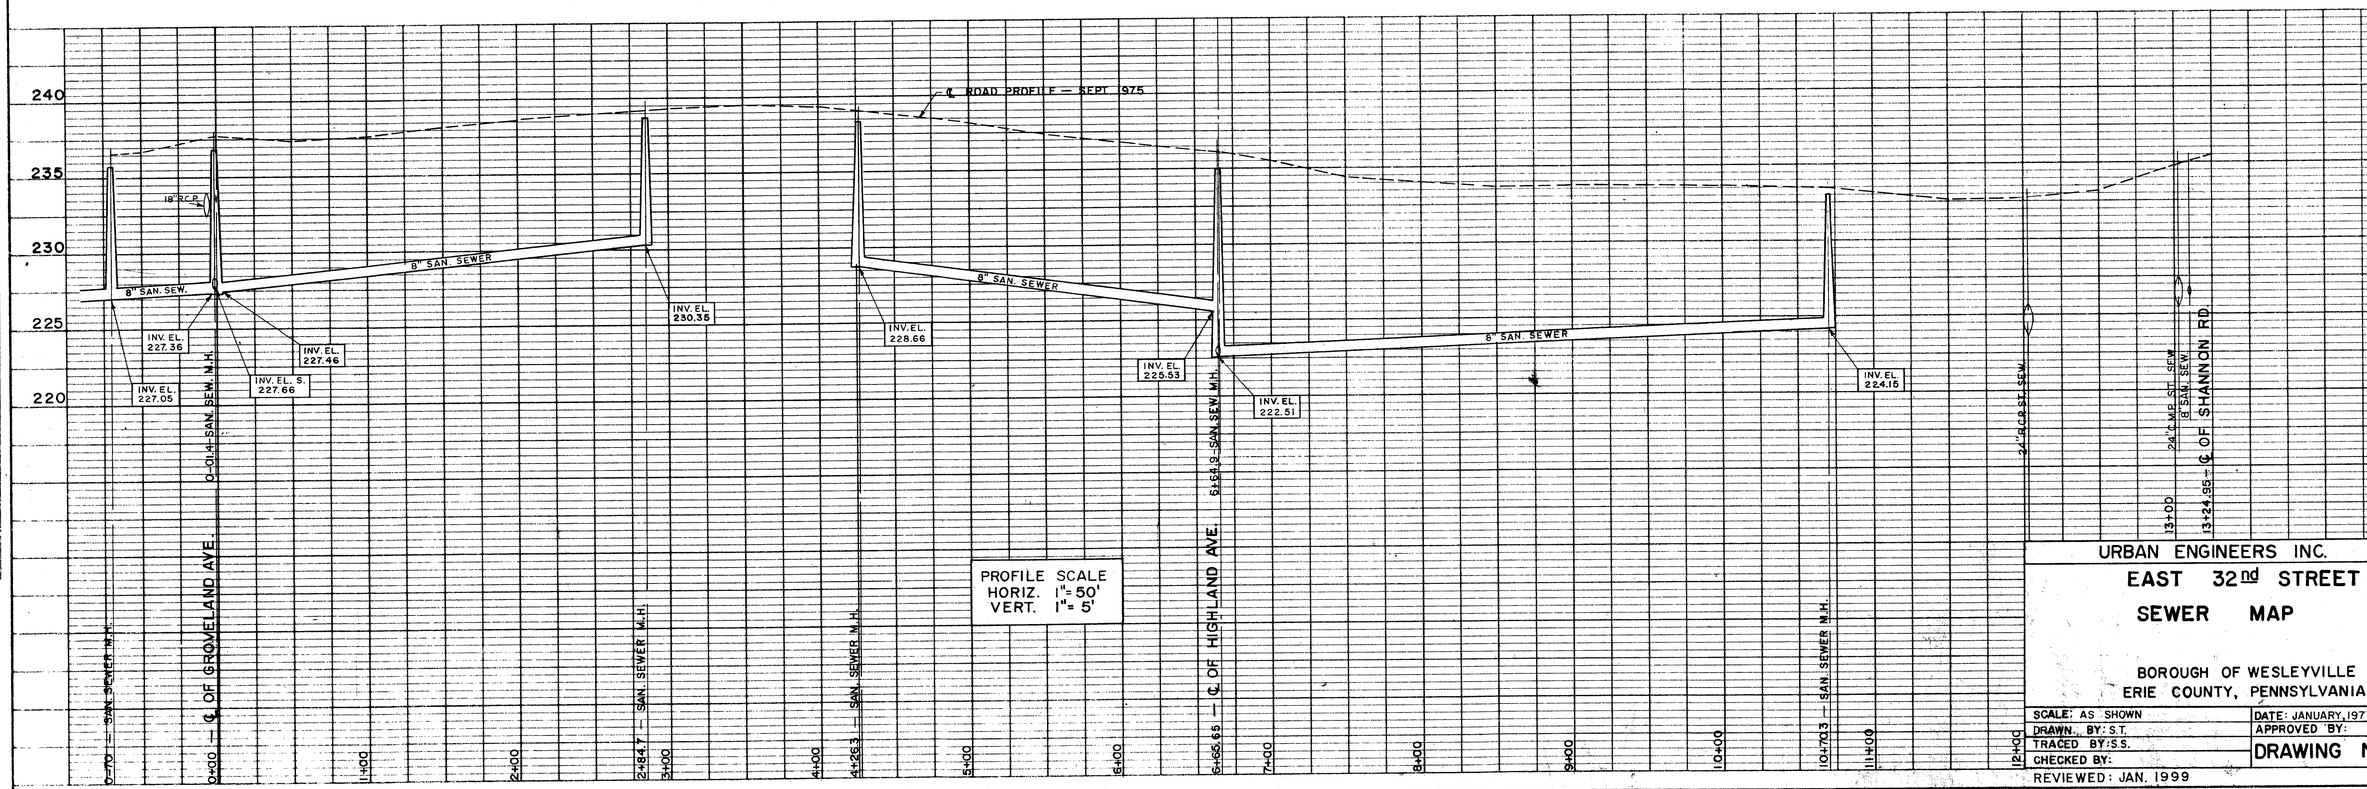

PROFILE SCALE
HORIZ. 1"= 50'
VERT. 1"= 5'

URBAN ENGINEERS INC.

EAST 32nd STREET
SEWER MAP


BOROUGH OF WESLEYVILLE
ERIE COUNTY, PENNSYLVANIA

SCALE: AS SHOWN	DATE: JANUARY, 1977
DRAWN BY: S.T.	APPROVED BY:
TRACED BY: S.S.	DRAWING NO. MB-43
CHECKED BY:	
REVIEWED: JAN. 1999	

PLAN — SURVEYED, PLOTTED, NOTE BOOK, ALIGNMENT CHECKED, AS OF MAY, CHECKED, NO, DATE, BY

PROFILE — SURVEYED, PLOTTED, NOTE BOOK, GRADES CHECKED, S & W NOTED, STRUCTURE NOTAT NS CH NO, DATE, BY

PLATE 1 PLAN PROFILE
Océ-Elliott Inc. NO. 492 TRACING CLOTH

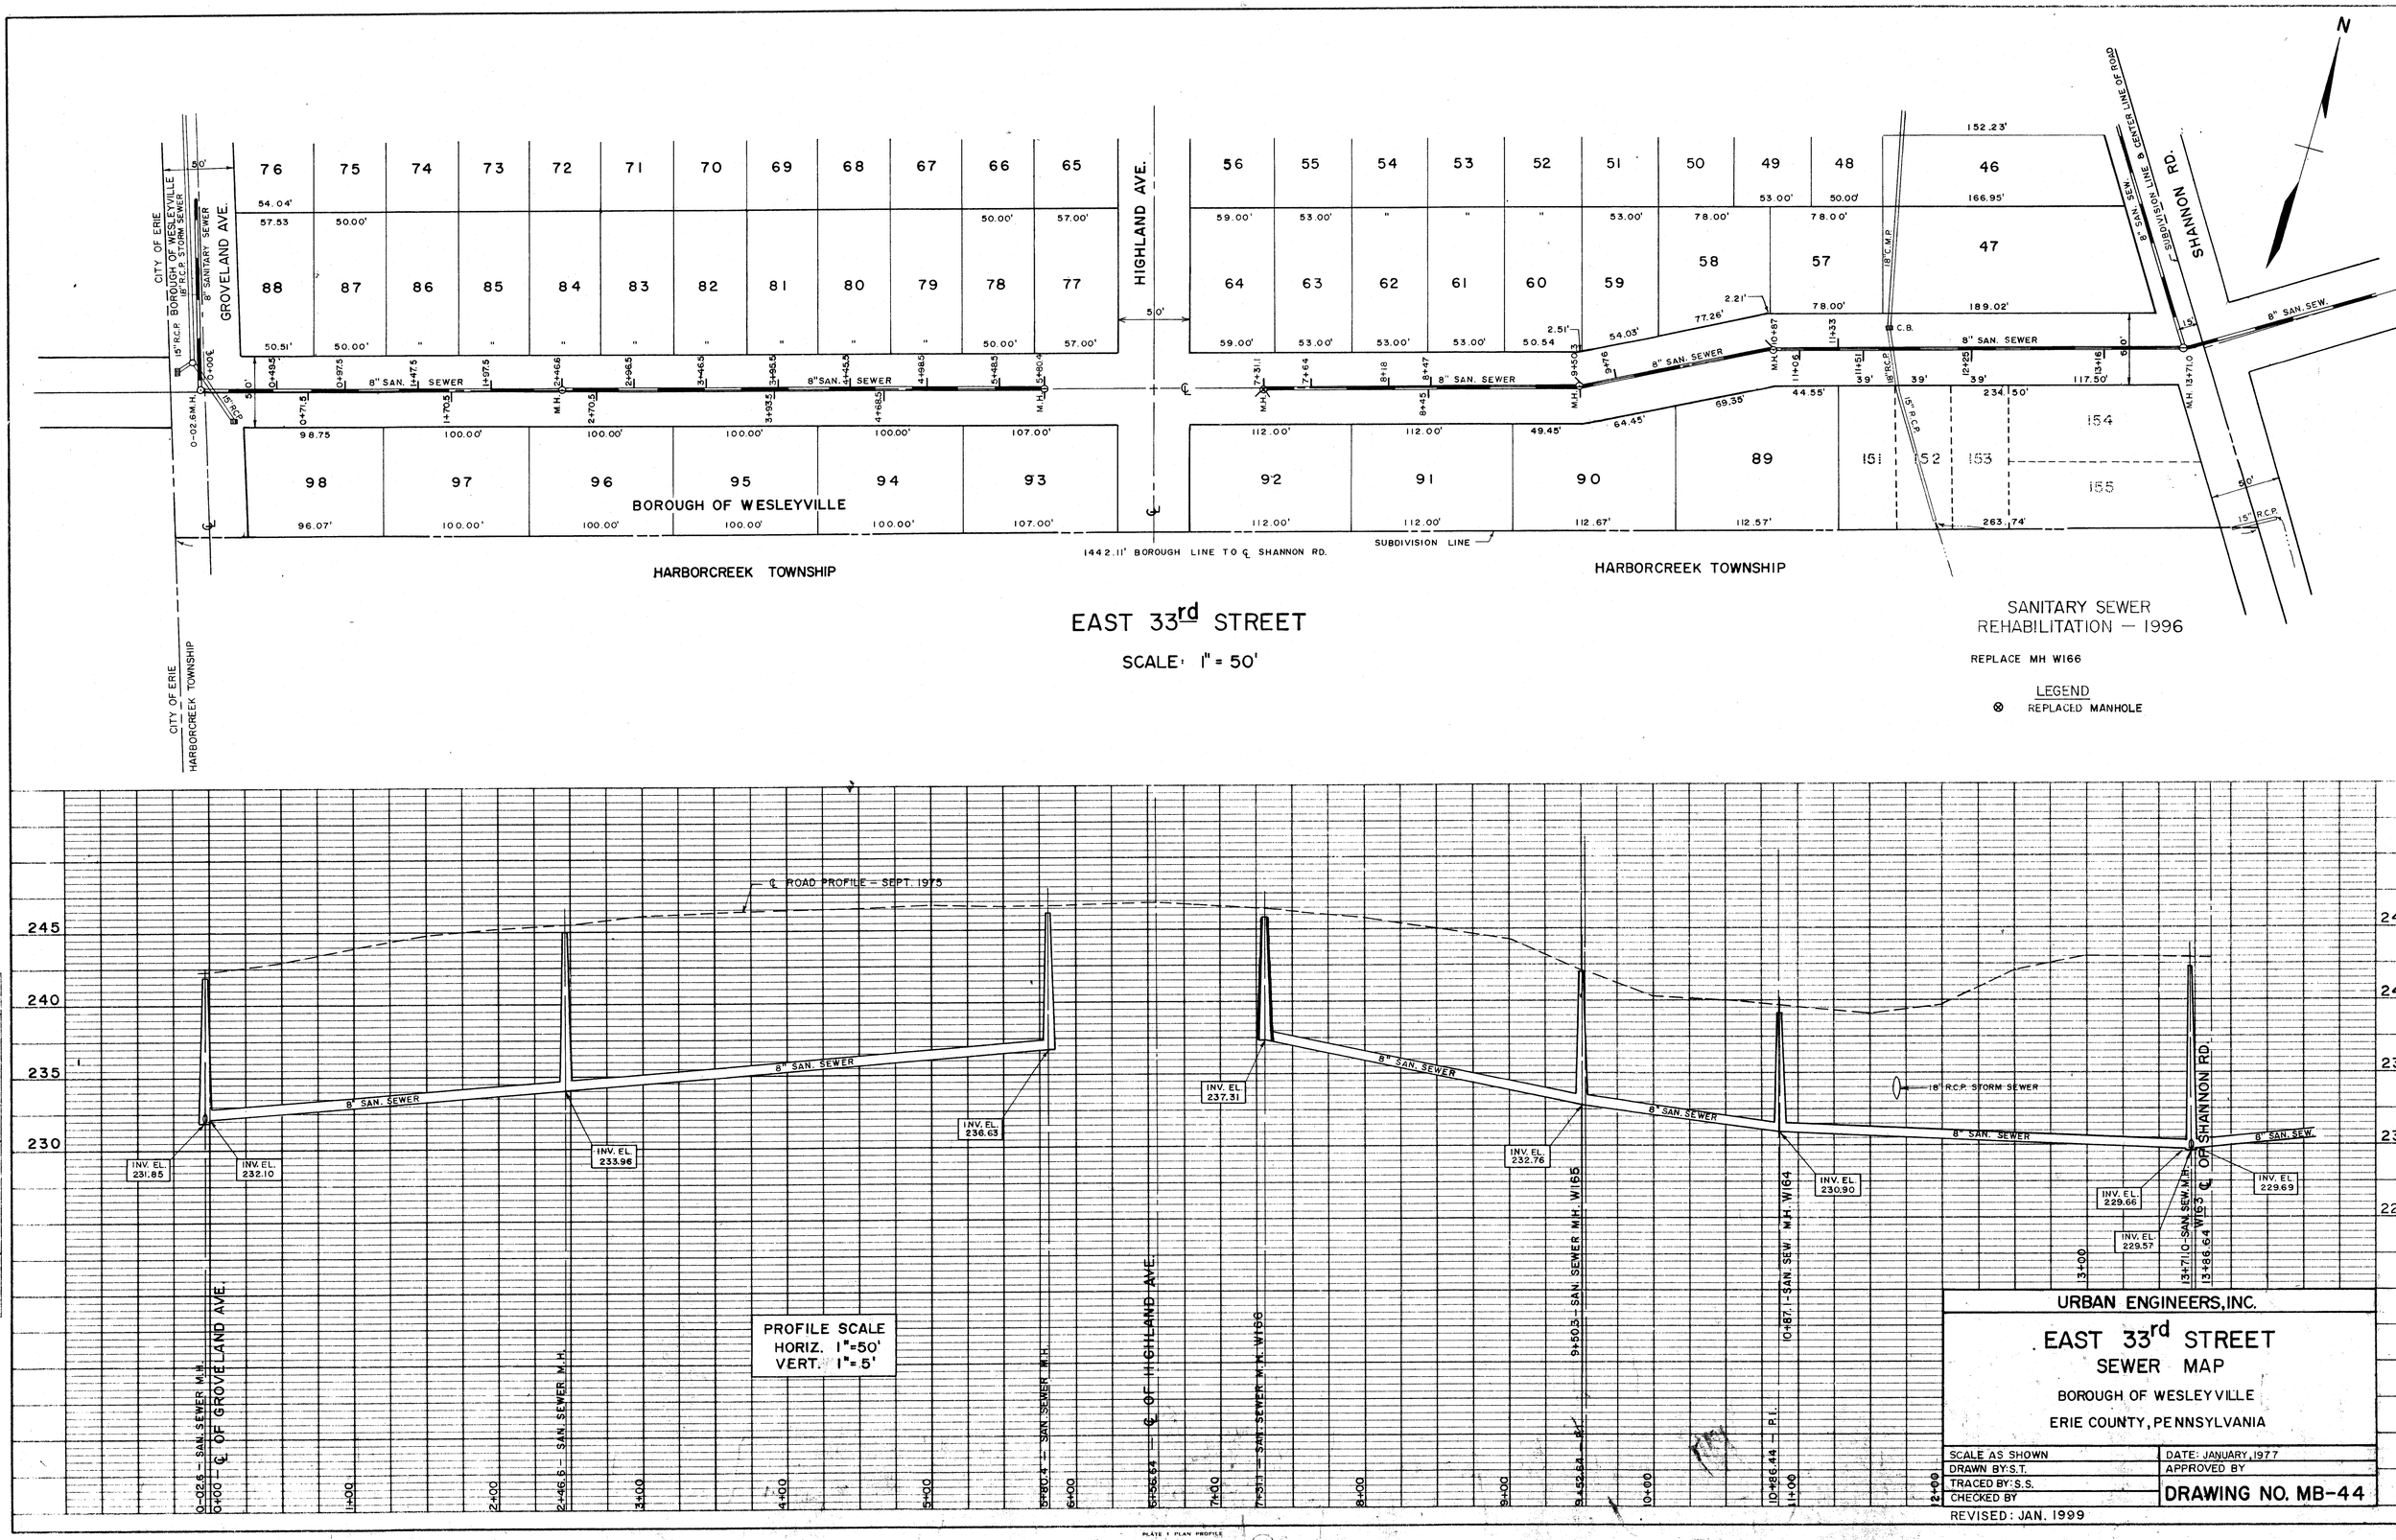

URBAN ENGINEERS, INC.

EAST 33rd STREET
SEWER MAP

BOROUGH OF WESLEYVILLE

ERIE COUNTY, PENNSYLVANIA

SCALE AS SHOWN	DATE: JANUARY, 1977
DRAWN BY: S.T.	APPROVED BY
TRACED BY: S.S.	DRAWING NO. MB-44
CHECKED BY	


REVISED: JAN. 1999

PLAN SURVEYED / PLOTTED / GRADES CHECKED / R.O.W. NOTED / STRUCTURE NO. AT N.SCH. RD. / NOTE BOOK / NO / DATE / BY / R/W OR EASEMENT CHECKED / ALIGNMENT CHECKED

PROFILE SURVEYED / PLOTTED / GRADES CHECKED / R.O.W. NOTED / STRUCTURE NO. AT N.SCH. RD. / NOTE BOOK / NO / DATE / BY


PLATE 1 PLAN PROFILE

Opé-Elliott Inc. océ
NO. 4RF TRACING CLOTH

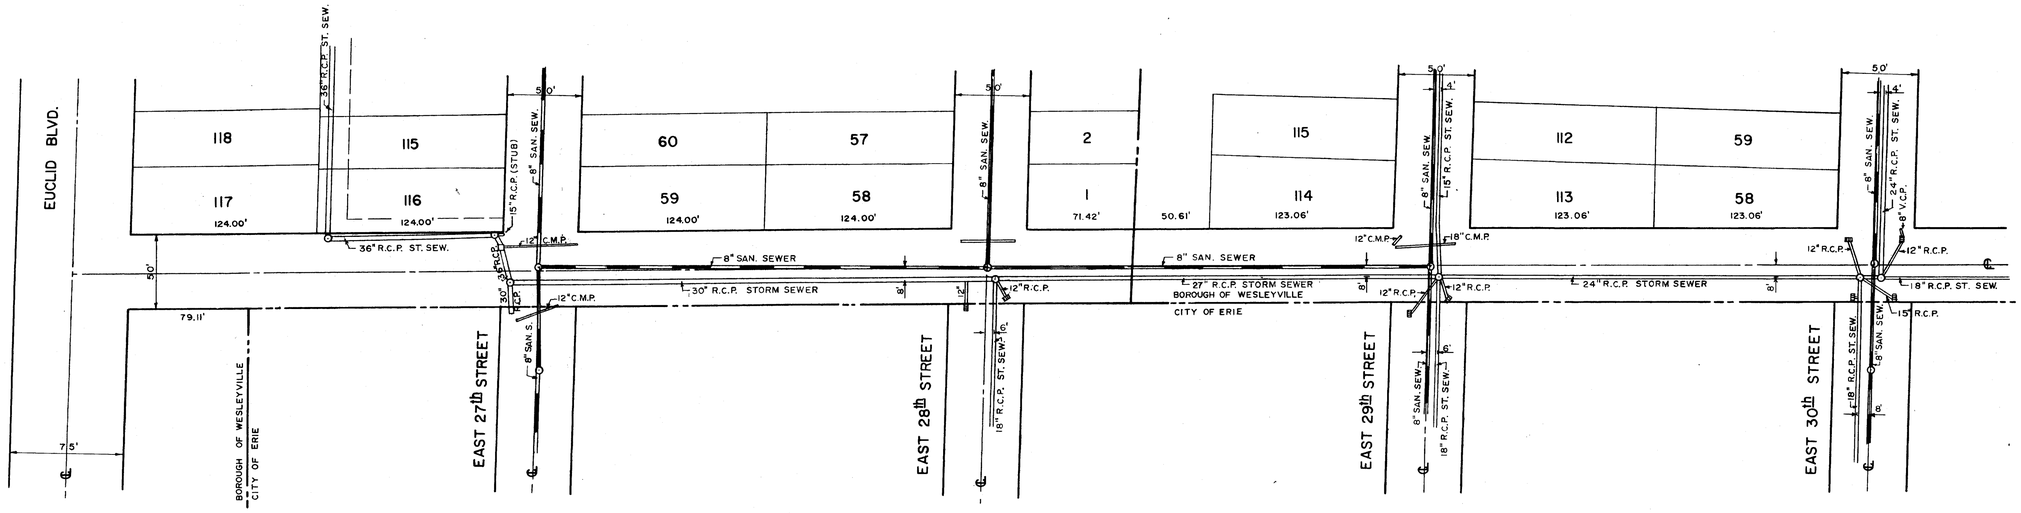

GROVELAND AVE.

PLAN SCALE 1"=50'

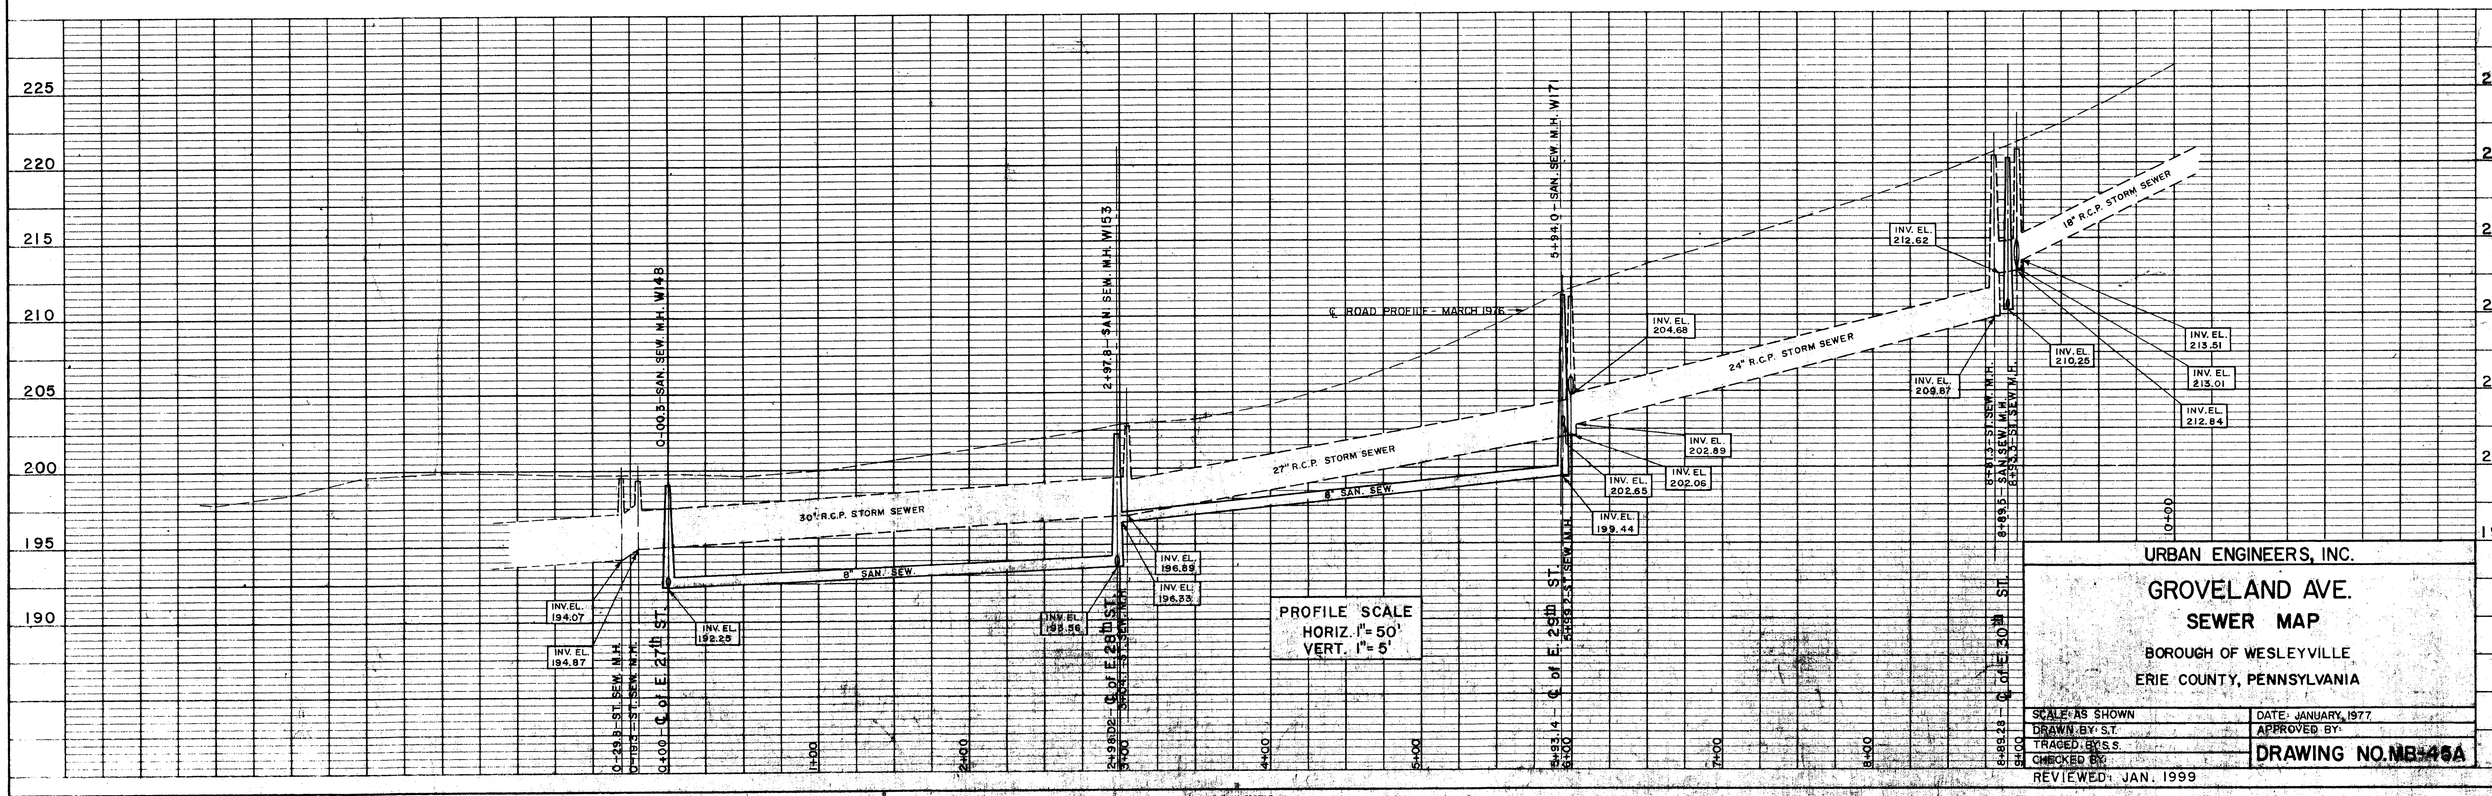

PROFILE SCALE
HORIZ. 1"= 50'
VERT. 1"= 5'

URBAN ENGINEERS, INC.

GROVELAND AVE.
SEWER MAP

BOROUGH OF WESLEYVILLE
ERIE COUNTY, PENNSYLVANIA


SCALE: AS SHOWN	DATE: JANUARY, 1977
DRAWN BY: S.T.	APPROVED BY:
TRACED BY: S.S.	DRAWING NO. MB-46A
CHECKED BY:	

REVIEWED: JAN. 1999

PLAN: SURVEYED, PLOTTED, ALIGNMENT CHECKED, R/T OF WAY CHECKED, NOTE BOOK, NO, DATE


PROFILE: SURVEYED, PLOTTED, GRADES CHECKED, ALIGNMENT CHECKED, NOTE BOOK, NO, STRUCTURE NO'S TAKEN, DATE

PLATE 3: PLAN PROFILE
Oce-Elliott Inc.
oce

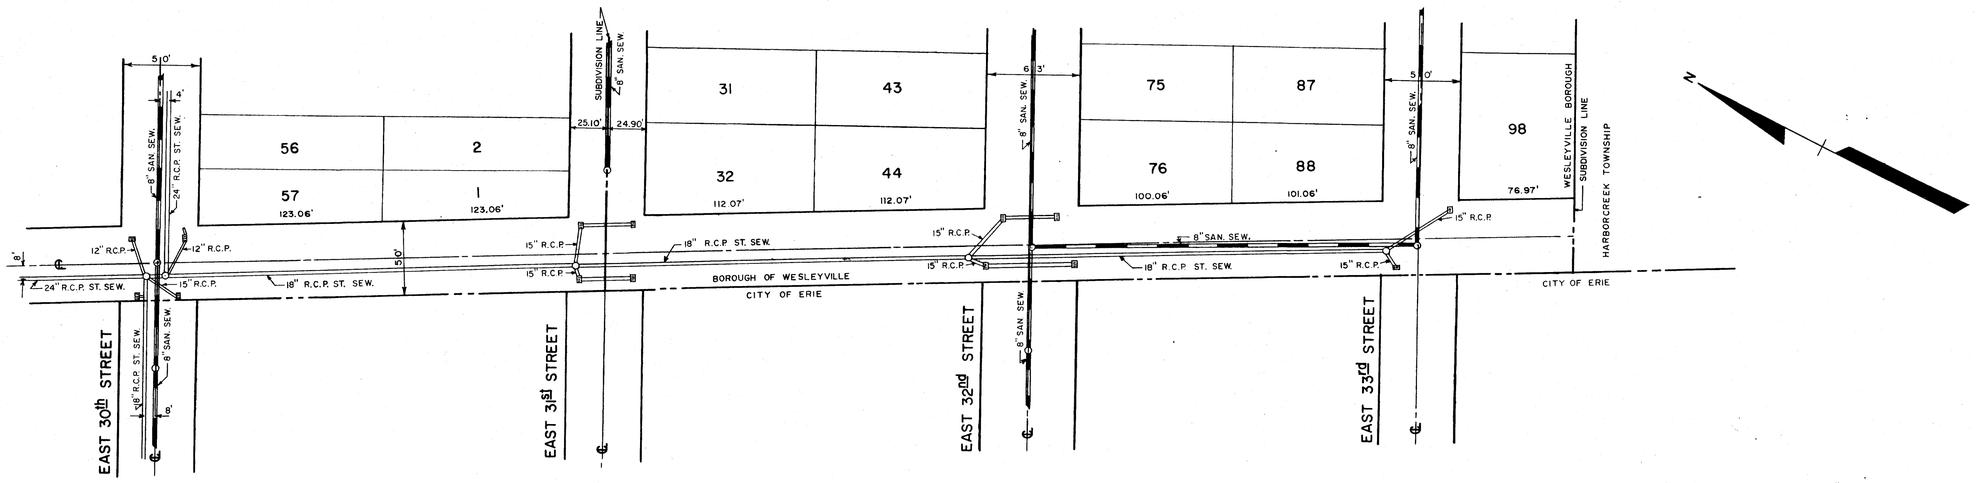

GROVELAND AVE.

PLAN SCALE 1"=50'

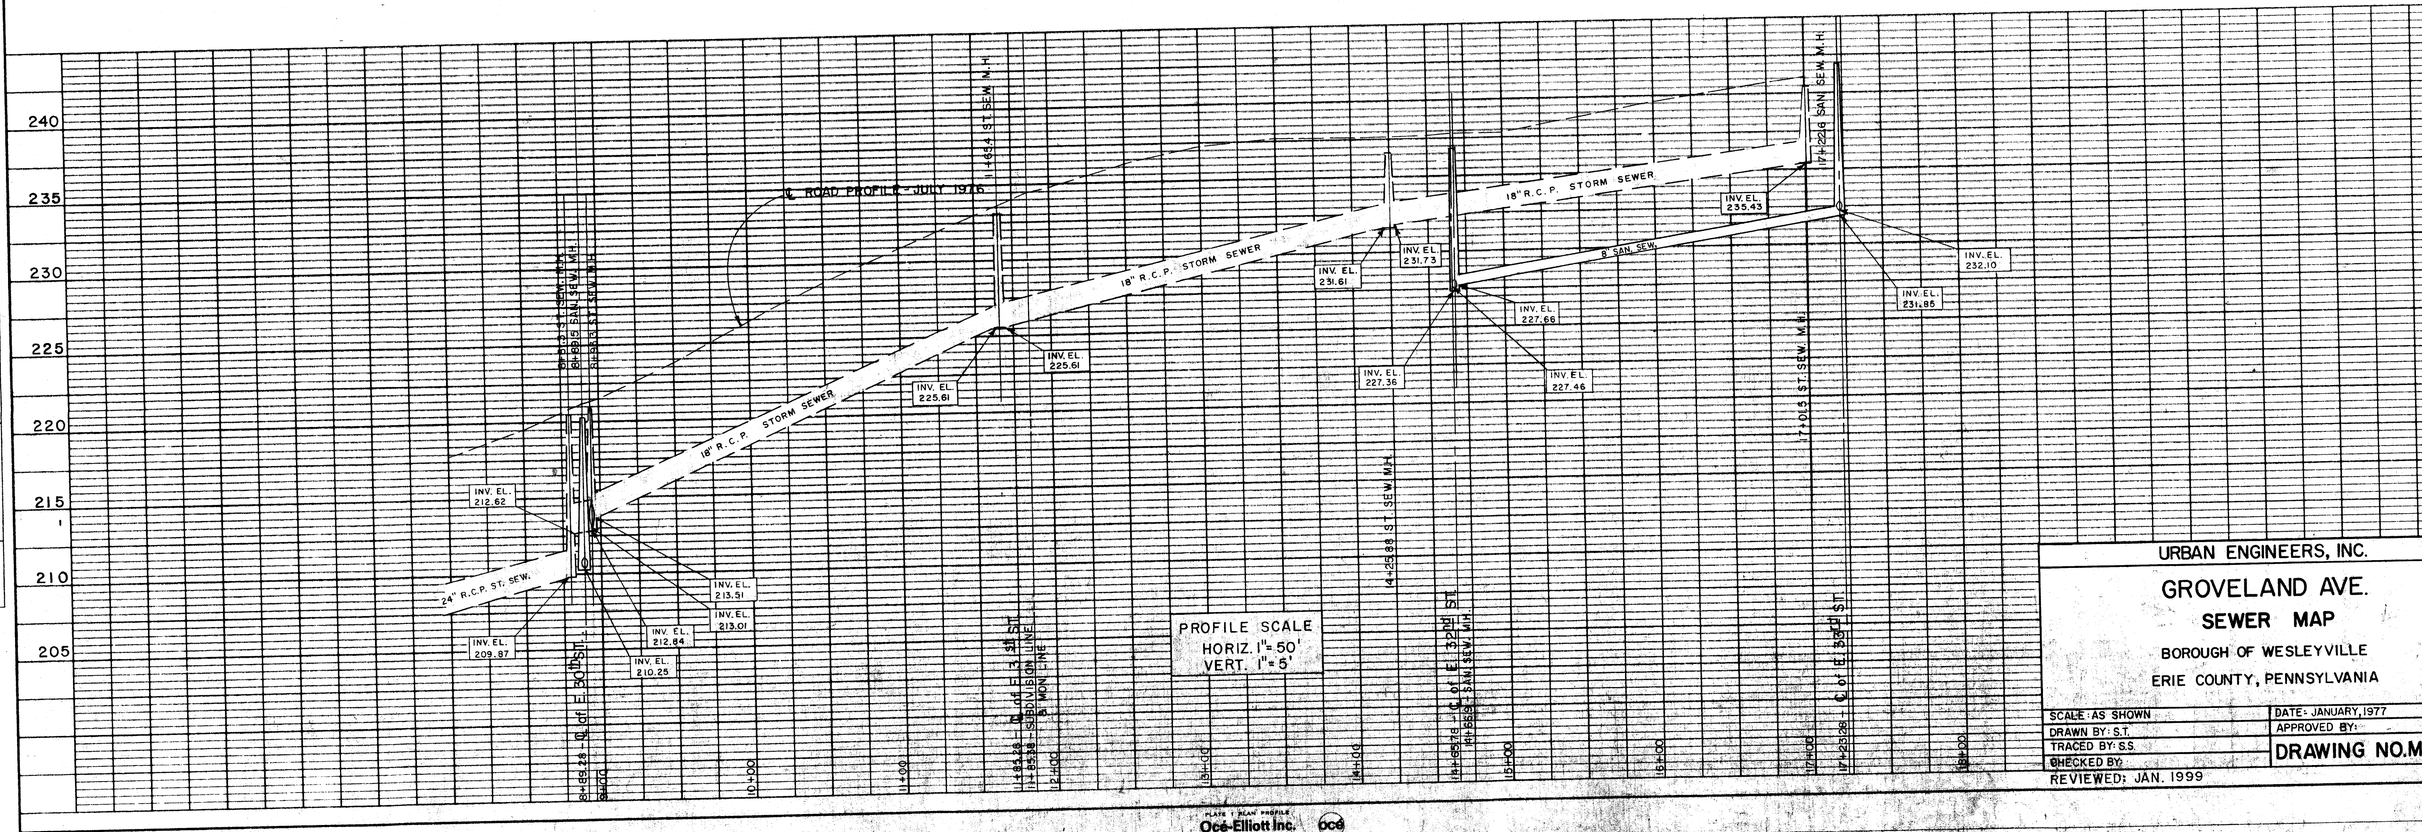

URBAN ENGINEERS, INC.

GROVELAND AVE.

SEWER MAP

BOROUGH OF WESLEYVILLE

ERIE COUNTY, PENNSYLVANIA

SCALE: AS SHOWN	DATE: JANUARY, 1977
DRAWN BY: S.T.	APPROVED BY:
TRACED BY: S.S.	DRAWING NO. MB-45B
CHECKED BY:	
REVIEWED: JAN. 1999	

PLATE 1 PLAN PROFILE

Oce-Elliott Inc. NO. 499 TRACING CLOTH

PLAN
NOTE BOOK
NO
SURVEYED
PLOTTED
GRADES CHECKED
ALIGNMENT CHECKED
RT. OF WAY CHECKED
STRUCTURE NO.(AT N.S.CH. NO.)

PROFILE
NOTE BOOK
NO
SURVEYED
PLOTTED
GRADES CHECKED
ALIGNMENT CHECKED
RT. OF WAY CHECKED
STRUCTURE NO.(AT N.S.CH. NO.)

EUCLID BLVD.

EAST 27th STREET

EAST 28th STREET

EAST 29th STREET

EAST 30th STREET

EAST 31st STREET

HIGHLAND AVE.

PLAN SCALE 1"=50'

7.5' | 5.0' | 5.0' | 5.0' | 5.0' | 5.0' | 5.0'

135	97	78	39	20	131	96	75	40	18		
134	98	77	40	19	130	97	74	41	17		
124.00'	124.00'	124.00'	124.00'	80.80'	123.00'	123.00	123.00'	123.00'	123.00'		
124.00'	124.00'	124.00'	124.00'	80.13'	123.00'	123.00'	123.00'	123.00'	123.00'		
133	99	76	41	18	129	98	73	42	16		
132	100	75	42	17	128	99	72	43	15		

40.935' | 41.625'

36" R.C.P. ST. SEW. | 24" V.C.P. STORM SEWER | 21" R.C.P. STORM SEWER | 18" R.C.P. STORM SEWER | 18" R.C.P. STORM SEWER | 8" SANITARY SEWER

15" R.C.P. | 8" SANITARY SEWER | 24" R.C.P. STORM SEWER | 18" R.C.P. STORM SEWER | CIRCULAR CATCH BASIN | SUBDIVISION LINE

N

PROFILE SCALE
HORIZ. 1"= 50'
VERT 1"= 5'

℄ ROAD PROFILE - JULY 1976

0+12 STORM SEWER M.H. | ℄ of E. 27th ST. | 0+15 STORM SEWER M.H. | 2+18 STORM SEWER M.H. | ℄ of E. 28th ST. | 3+25 STORM SEWER M.H. | 4+39.42 STORM SEWER M.H. | 5+76 STORM SEWER M.H. | ℄ of E. 29th ST. | 5+42.82 | 6+86.93 | SAN. SEW. M.H. | 7+83.23 | ℄ of E. 30th ST. | 8+93.33 | ST. SEW. M.H. | 9+00 | 10+00 | 10+43.3 | ST. SEW. M.H. | 11+00 | 11+84.03 | SAN. SEW. M.H. | 11+85.03 | ℄ of E. 31st ST. | 12+00

36" R.C.P. STORM SEWER | 24" V.C.P. STORM SEWER | 21" R.C.P. STORM SEWER | 18" R.C.P. STORM SEWER | 18" R.C.P. STORM SEWER | 24" R.C.P. STORM SEWER | 8" SANITARY SEWER

INV. EL. 196.16 | INV. EL. 196.36 | INV. EL. 196.68 | INV. EL. 197.21 | INV. EL. 198.74 | INV. EL. 198.26 | INV. EL. 199.33 | INV. EL. 199.07 | INV. EL. 205.41 | INV. EL. 215.14 | INV. EL. 217.16 | INV. EL. 216.30 | INV. EL. 216.33 | INV. EL. 217.24 | INV. EL. 217.63 | INV. EL. 218.58 | INV. EL. 218.66

230 | 225 | 220 | 215 | 210 | 205 | 200 | 195 | 190

URBAN ENGINEERS, INC.


HIGHLAND AVE.
SEWER MAP


BOROUGH OF WESLEYVILLE
ERIE COUNTY, PENNSYLVANIA

SCALE: AS SHOWN	DATE: JANUARY, 1977
DRAWN BY: S.T.	APPROVED BY:
TRACED BY: S.S.	DRAWING NO. MB-46A
CHECKED BY:	

REVIEWED: JAN. 1999

PLATE I PLAN PROFILE
Oes-Elliott Inc.
NO. 467 TRACING CLOTH
069

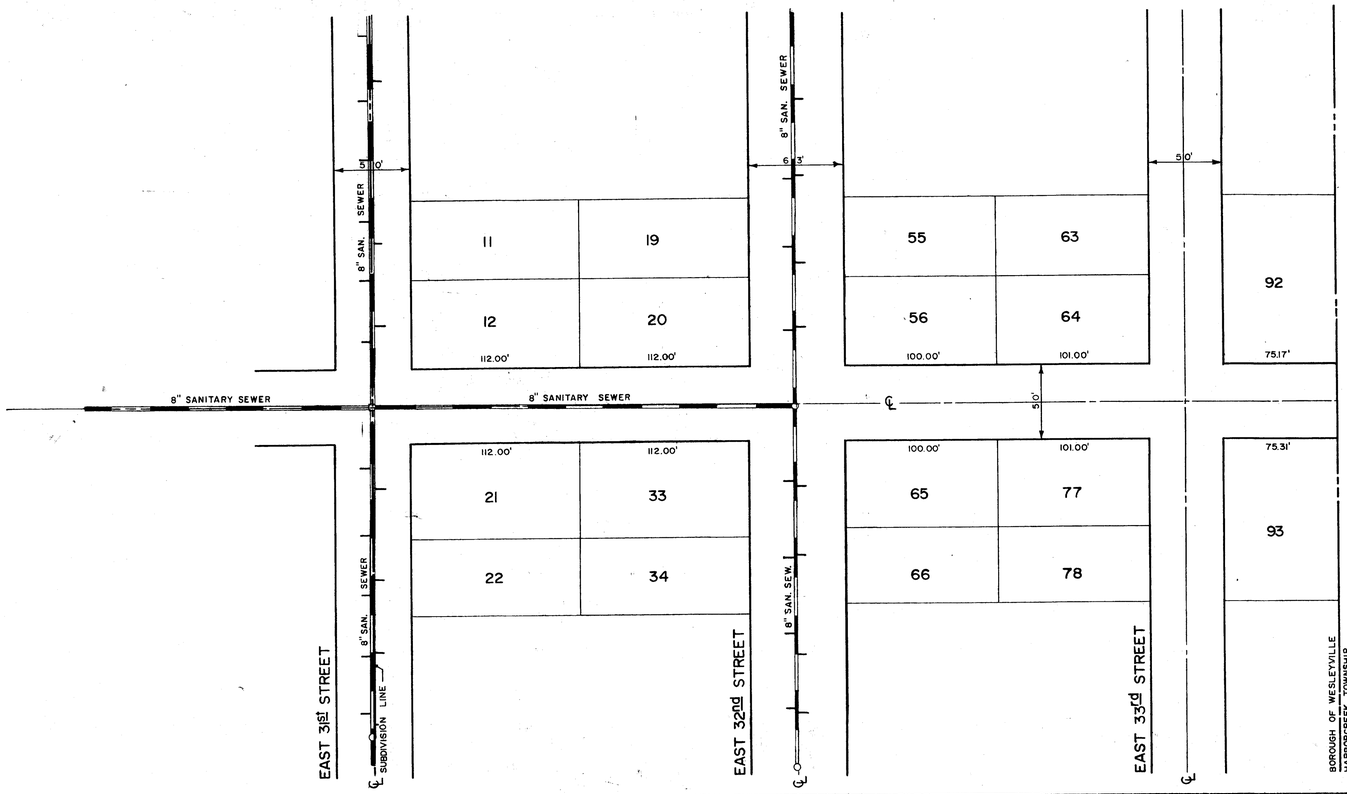


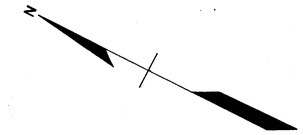

HIGHLAND AVE

PLAN SCALE 1"=50'

PROFILE SCALE
HORIZ 1"=50'
VERT 1"=5'

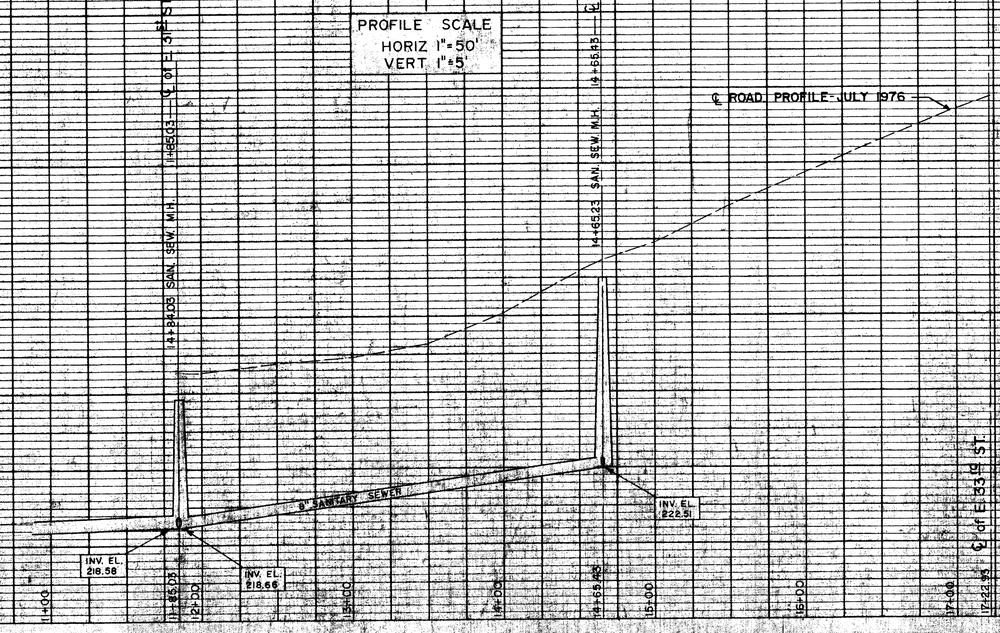

URBAN ENGINEERS, INC.

HIGHLAND AVE.
SEWER MAP

BOROUGH OF WESLEYVILLE
ERIE COUNTY, PENNSYLVANIA

SCALE: AS SHOWN	DATE: JANUARY, 1977
DRAWN BY: S.T.	APPROVED BY:
TRACED BY: S.S.	DRAWING NO. MB-46B
CHECKED BY:	
REVIEWED: JAN. 1999	


PLAN: SURVEYED, PLOTTED, NOTE BOOK, NO. — ALIGNMENT CHECKED, R/W CHECKED, BY, DATE


PROFILE: SURVEYED, PLOTTED, GRADES CHECKED, B.M.'s NOTED, STRUCTURE NOTAT HS CH. RD., NOTE BOOK, NO., BY, DATE

PLANS & PLAN PROFILES
Oce-Elliott Inc.
NO. ERIE / ERIE COUNTY
oce

SHANNON ROAD

PLAN SCALE 1"= 50'

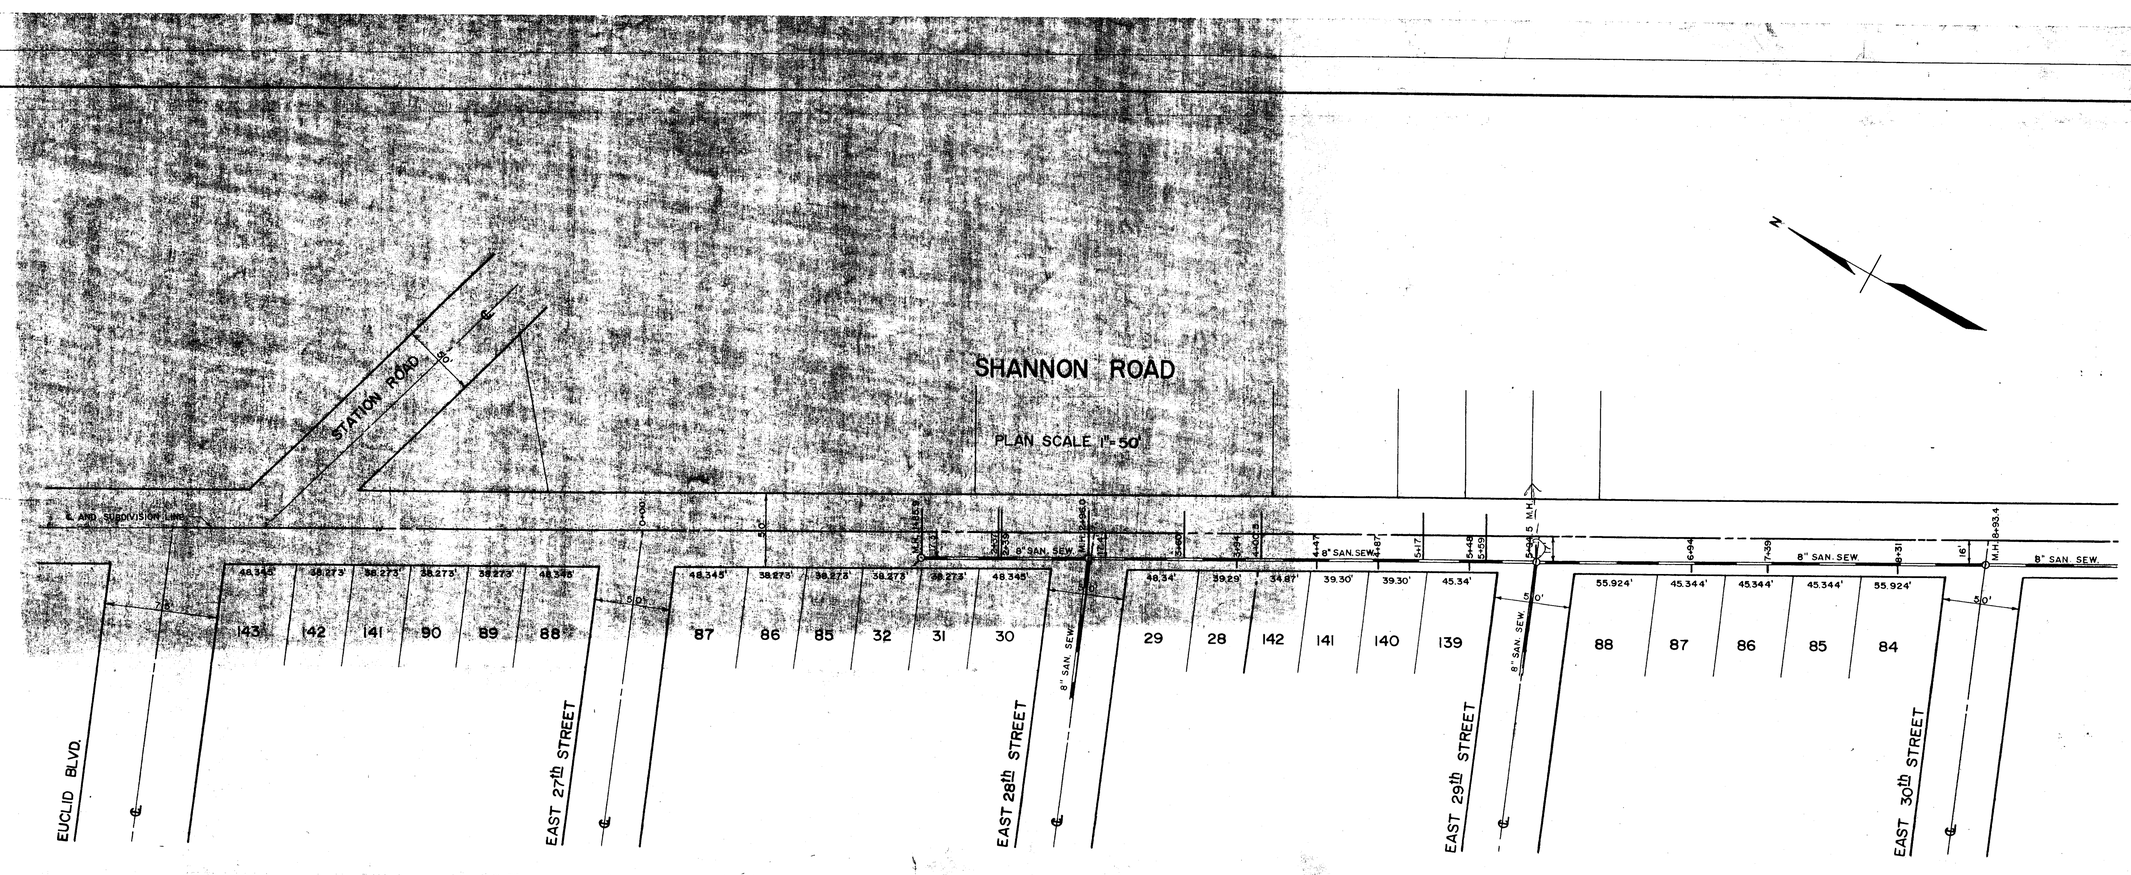

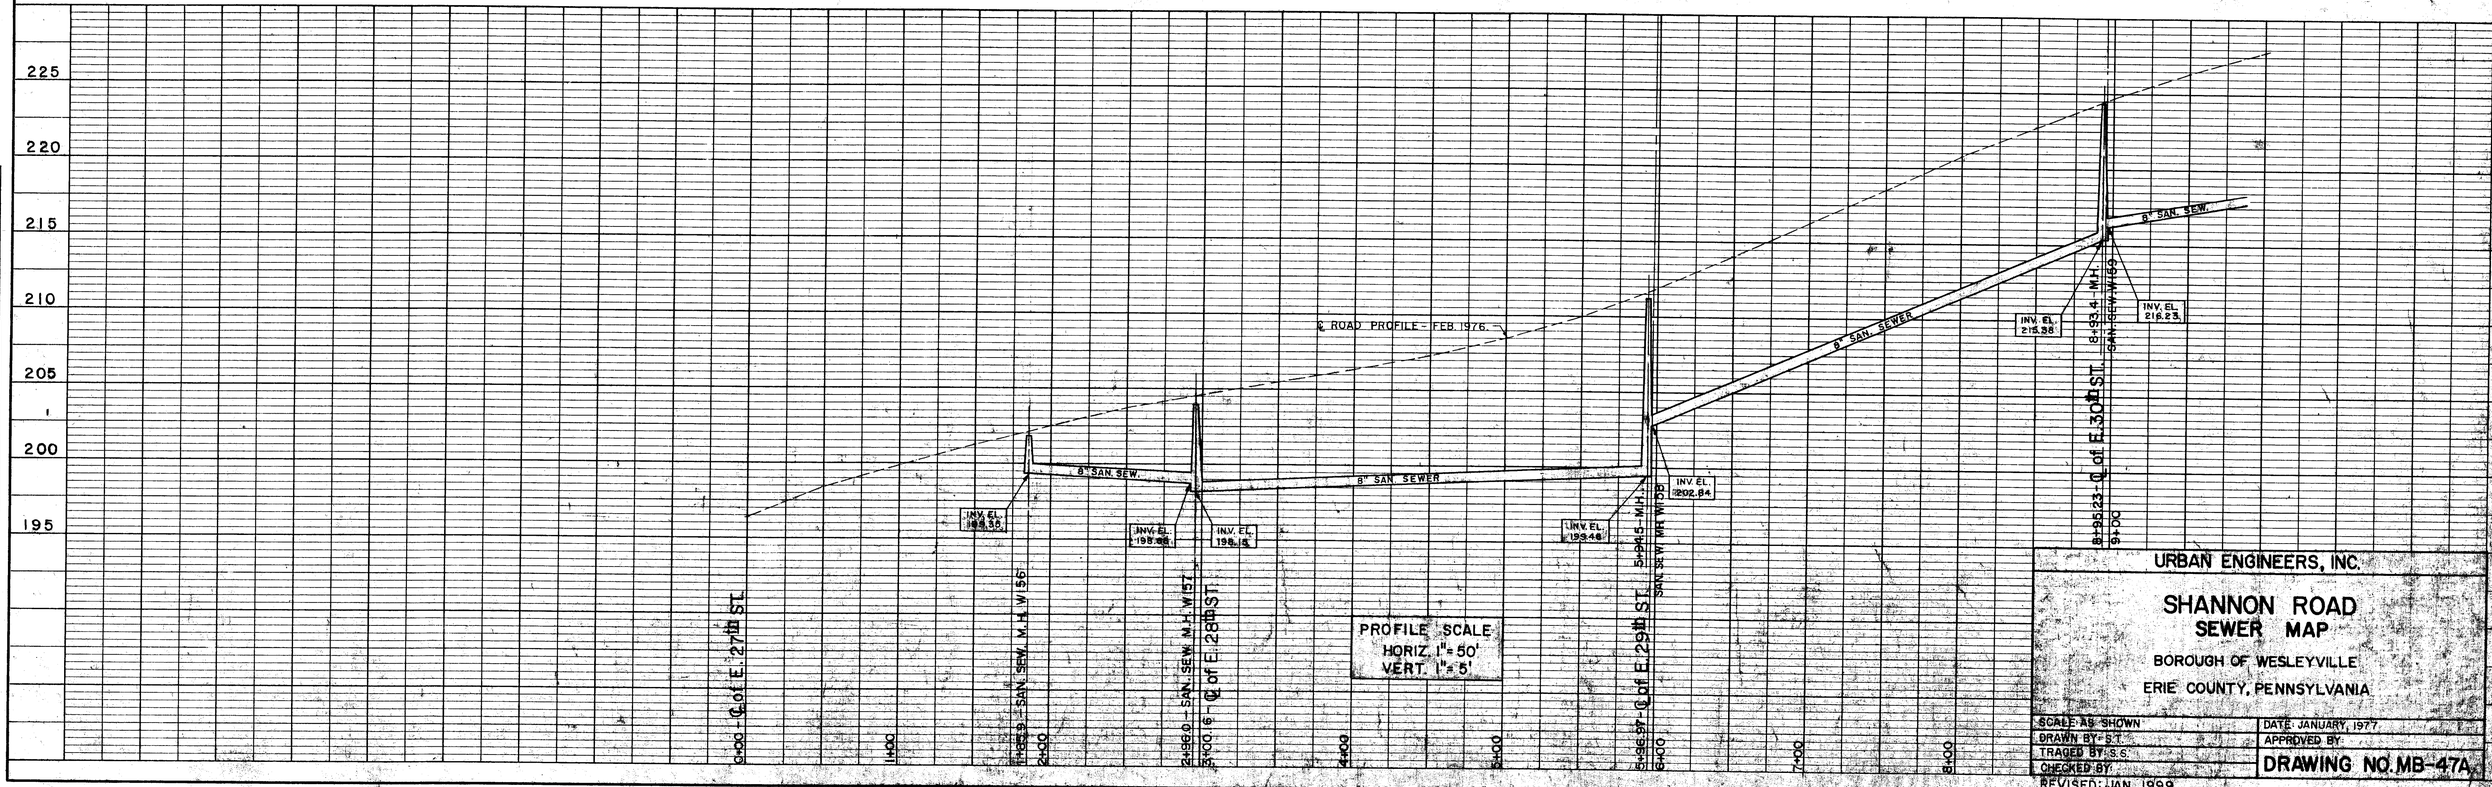

PROFILE SCALE
HORIZ. 1"= 50'
VERT. 1"= 5'

URBAN ENGINEERS, INC.

SHANNON ROAD
SEWER MAP

BOROUGH OF WESLEYVILLE
ERIE COUNTY, PENNSYLVANIA

SCALE: AS SHOWN	DATE: JANUARY, 1977
DRAWN BY: S.T.	APPROVED BY:
TRACED BY: S.S.	DRAWING NO. MB-47A
CHECKED BY:	

REVISED: JAN. 1999


PLOTTED
DRAWN CHECKED
B. M.'s NOTED
STRUCTURE NOTATIONS CHECKED
NOTE BOOK
No.
ALIGNMENT CHECKED
RT. OF WAY CHECKED

Printed in U.S.A.
On IMPERIAL Tracing Cloth


PLATE I PLAN-PROFILE B P R STANDARD
EUGENE DIETZGEN CO. CHICAGO, NEW YORK

SHANNON ROAD

PLAN SCALE 1"=50'

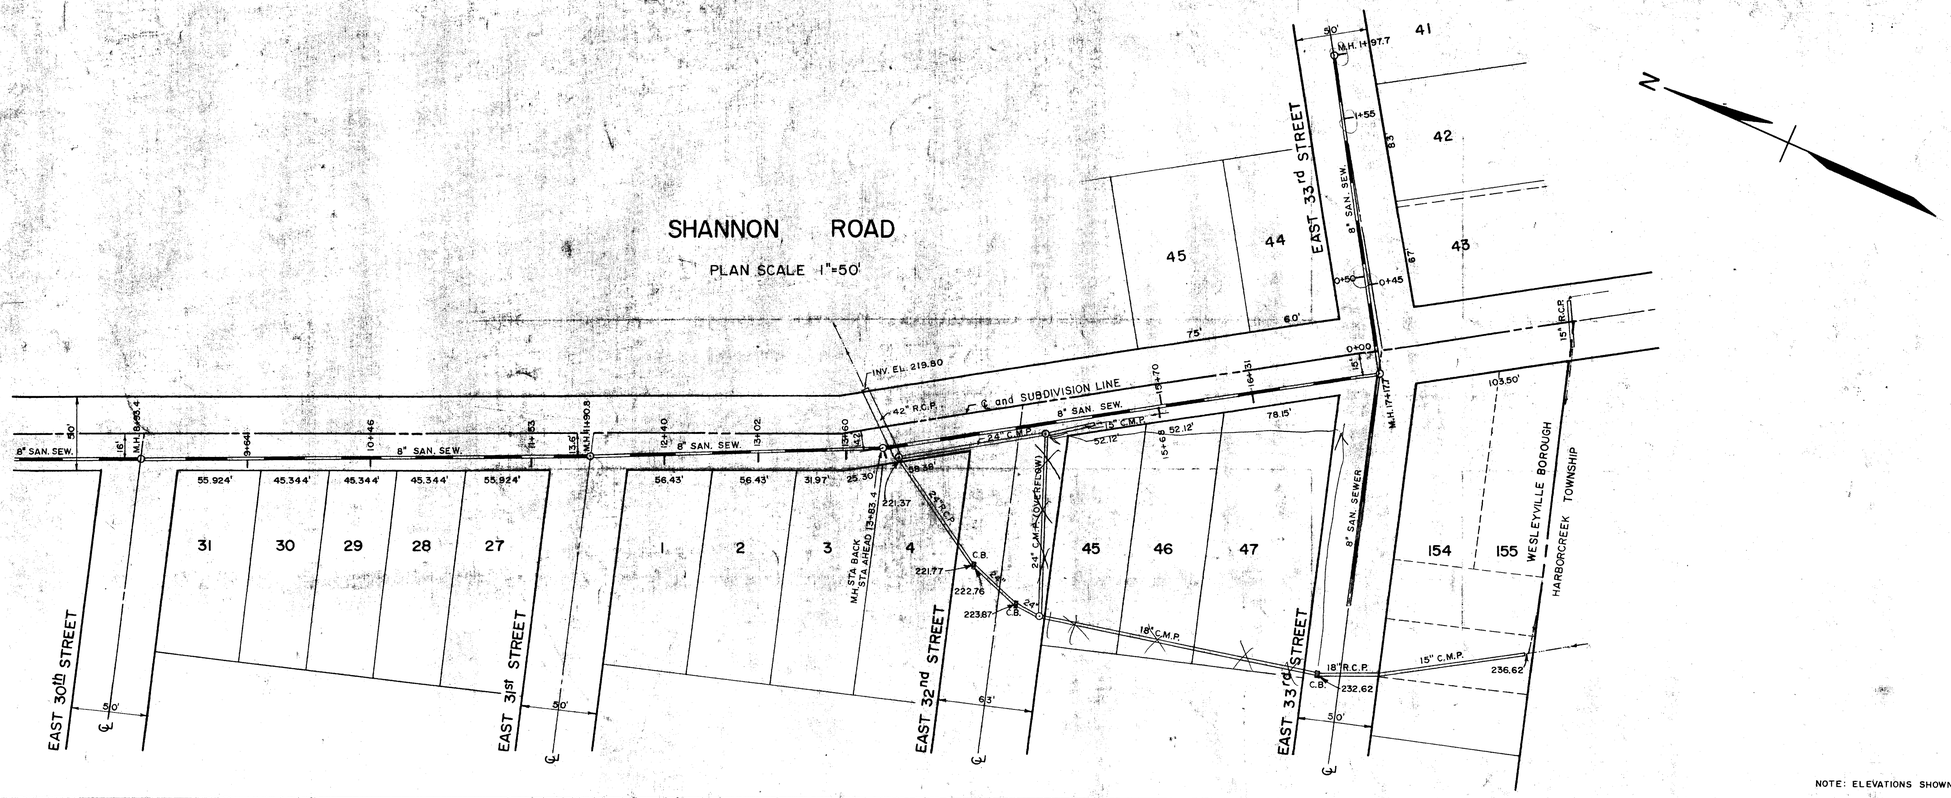

NOTE: ELEVATIONS SHOWN INDICATE INVERT ELEVATION.

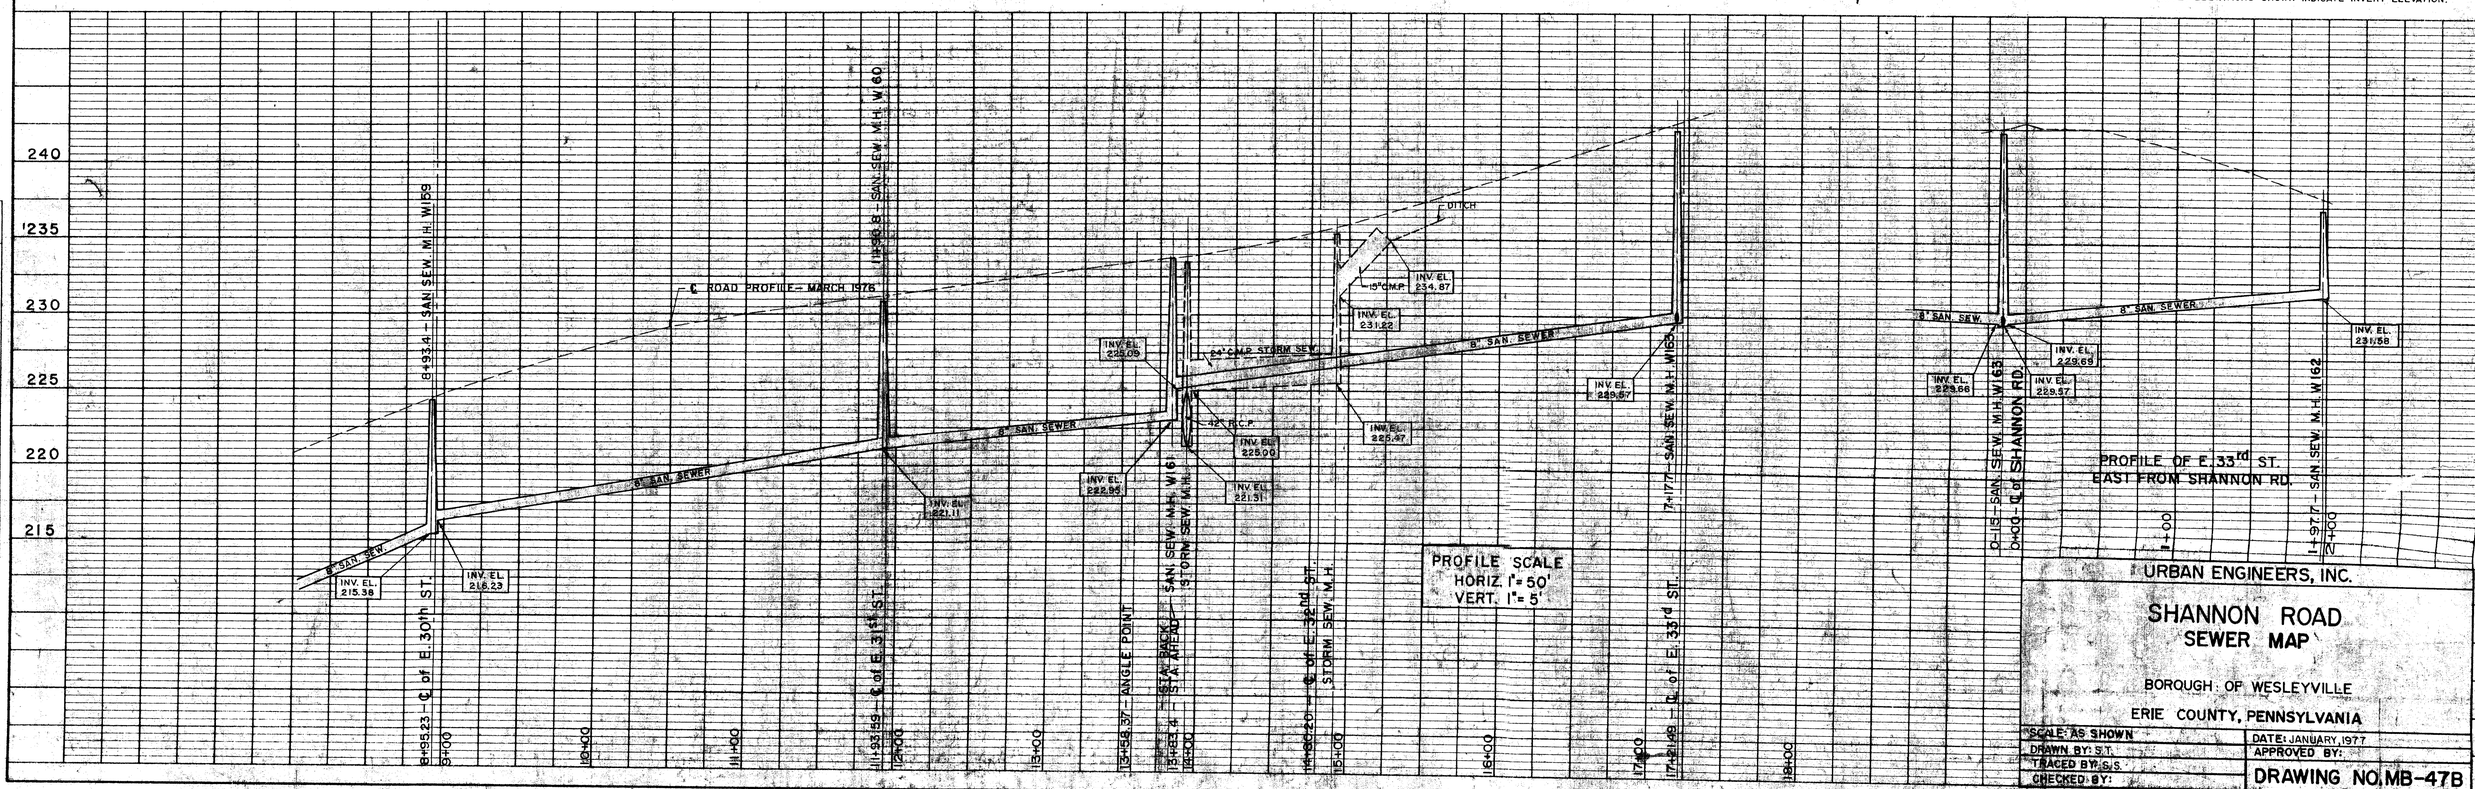

PROFILE SCALE
HORIZ. 1"= 50'
VERT. 1"= 5'

URBAN ENGINEERS, INC.

SHANNON ROAD SEWER MAP

BOROUGH OF WESLEYVILLE

ERIE COUNTY, PENNSYLVANIA

SCALE: AS SHOWN	DATE: JANUARY, 1977
DRAWN BY: S.T.	APPROVED BY:
TRACED BY: S.S.	
CHECKED BY:	DRAWING NO. MB-47B

REVISED: JAN. 1999

PLAN
NOTE BOOK
SURVEYED
PLOTTED
ALIGNMENT CHECKED
RT OF WAY CHECKED
NO
BY
DATE

PROFILE
NOTE BOOK
SURVEYED
PLOTTED
GRADES CHECKED
M.H.'s NOTED
STRUCTURE NOTAT'NS CH. RD.
NO

PLATE 1 PLAN PROFILE
Oce-Elliott Inc.
NO 4X3 TRACING FILM